


0406-094

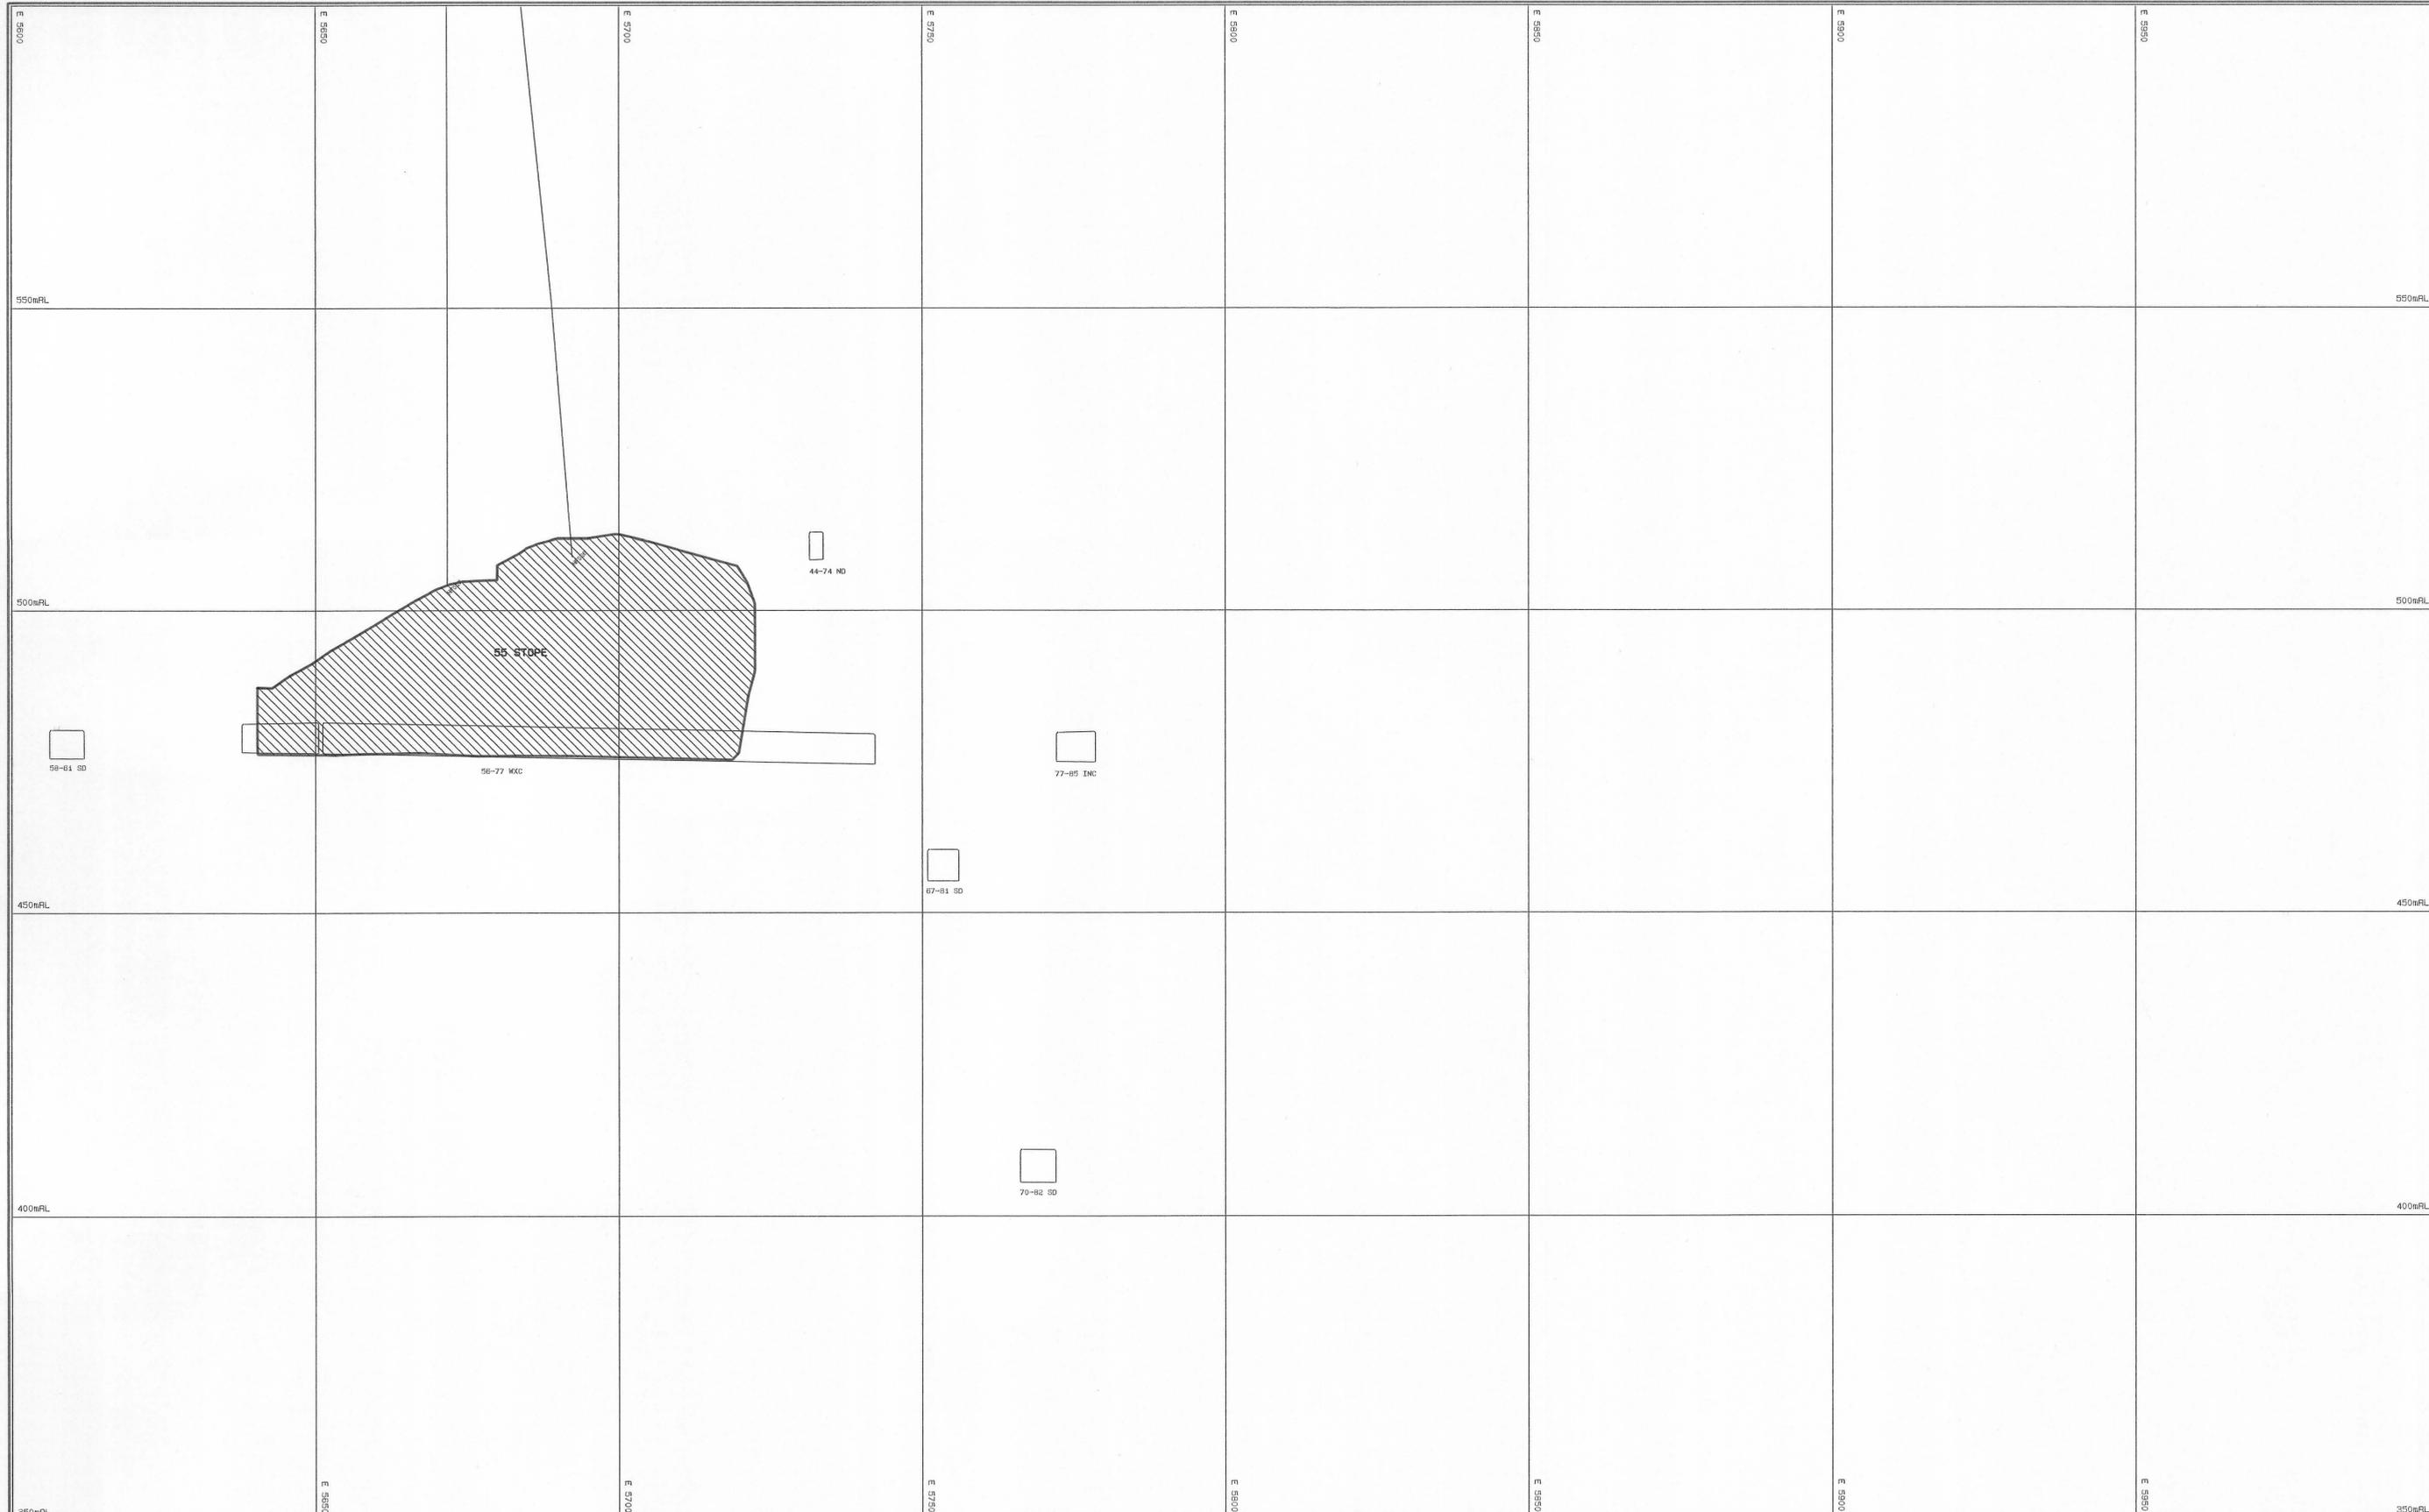

KEY

- HP = PROBE HOLE
- HA = COMP. AIR HOLE
- HV = VENT HOLE
- HE = ELECTRICAL HOLE
- HM = WATER HOLE
- HF = FILL HOLE

REV	DATE	REVISION	DRAWN	CHK	APP	APP



SCALE 1: 500

DRAWN	5-MAR-93
CHECKED	<i>[Signature]</i>
DESIGNED	<i>[Signature]</i>
DESIGN CHK.	
DESIGN APP.	
PROJECT APP.	

ABERFOYLE RESOURCES LTD.
HELLYER DIVISION

CROSS SECTION
 10550 NORTH

Drawing No. REF 350 Y
 REVISION



K