


0406 - 121

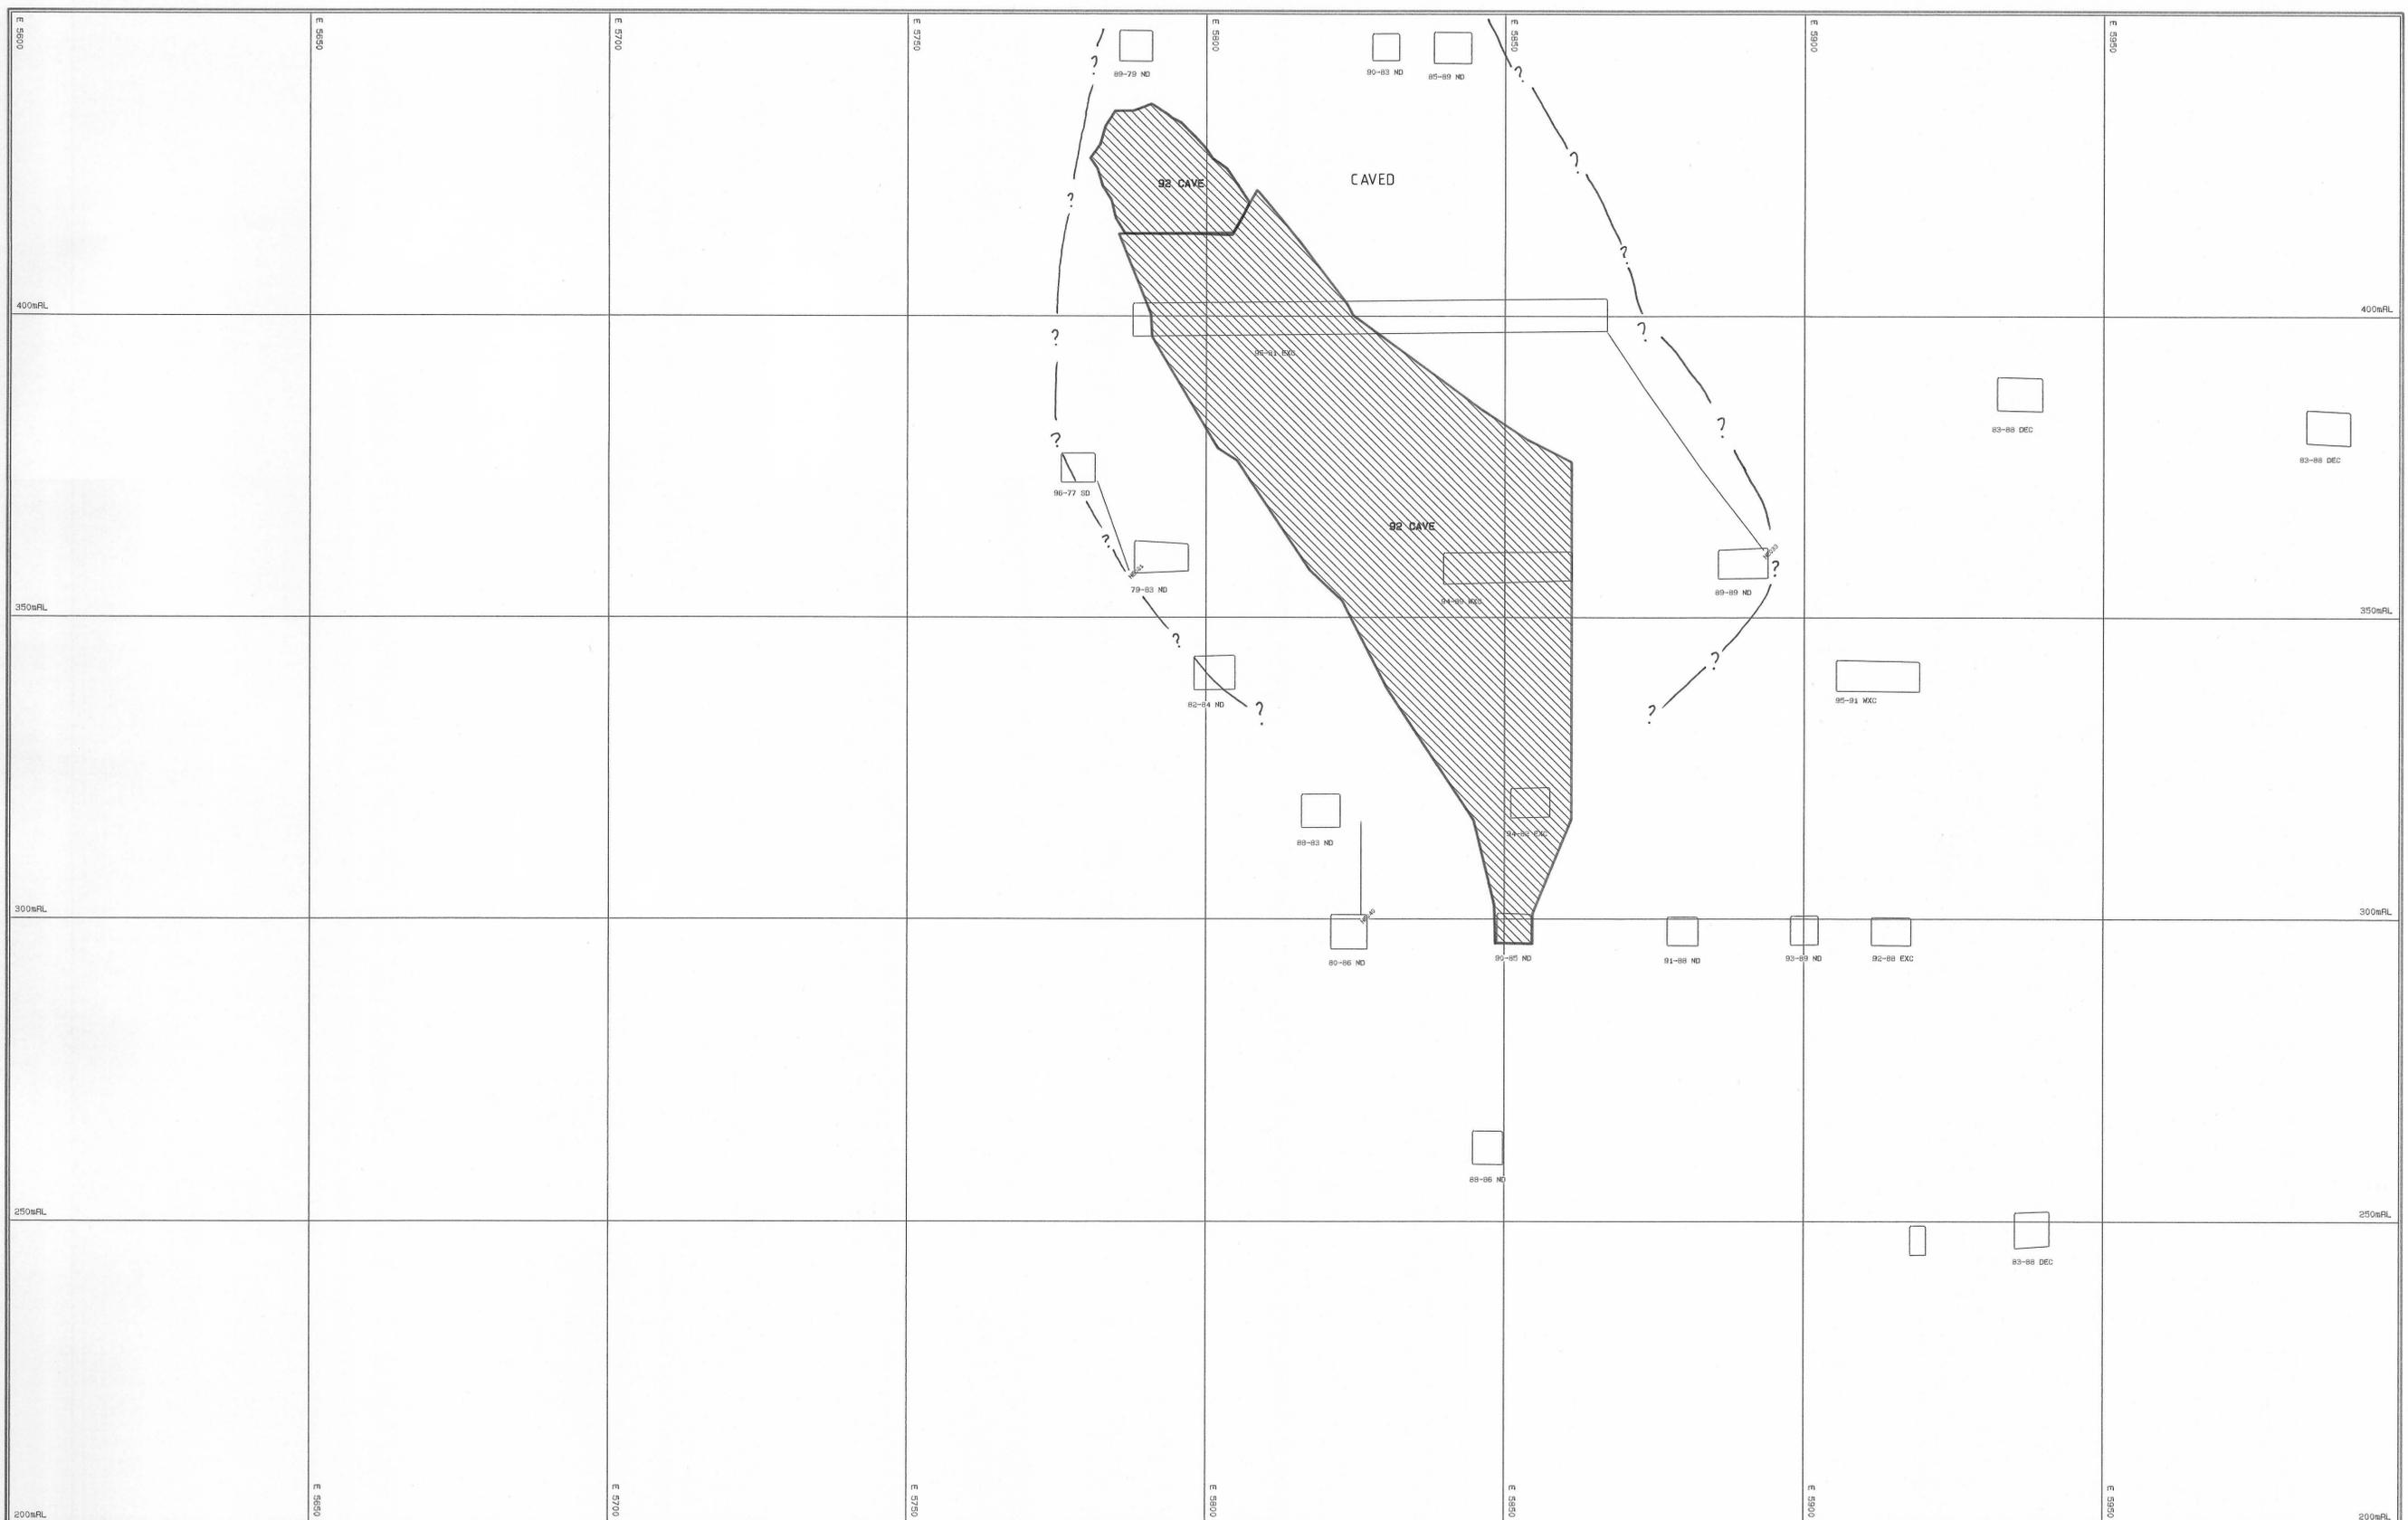

KEY

- HP = PROBE HOLE
- HA = COMP. ATR HOLE
- HV = VENT HOLE
- HE = ELECTRICAL HOLE
- HM = WATER HOLE
- HF = FILL HOLE

REV	DATE	REVISION	DRAWN	CKD	APP	APP



SCALE 1: 500

DRAWN		5-MAR-93
CHECKED	YH	5-3-93
DESIGNED		
DESIGN CKD.		
DESIGN APP.		
PROJECT APP.		

ABERFOYLE RESOURCES LTD.  
HELLYER DIVISION

CROSS SECTION  
10950 NORTH

Drawing No. REF 200 Y  
REVISION

