



0406-128

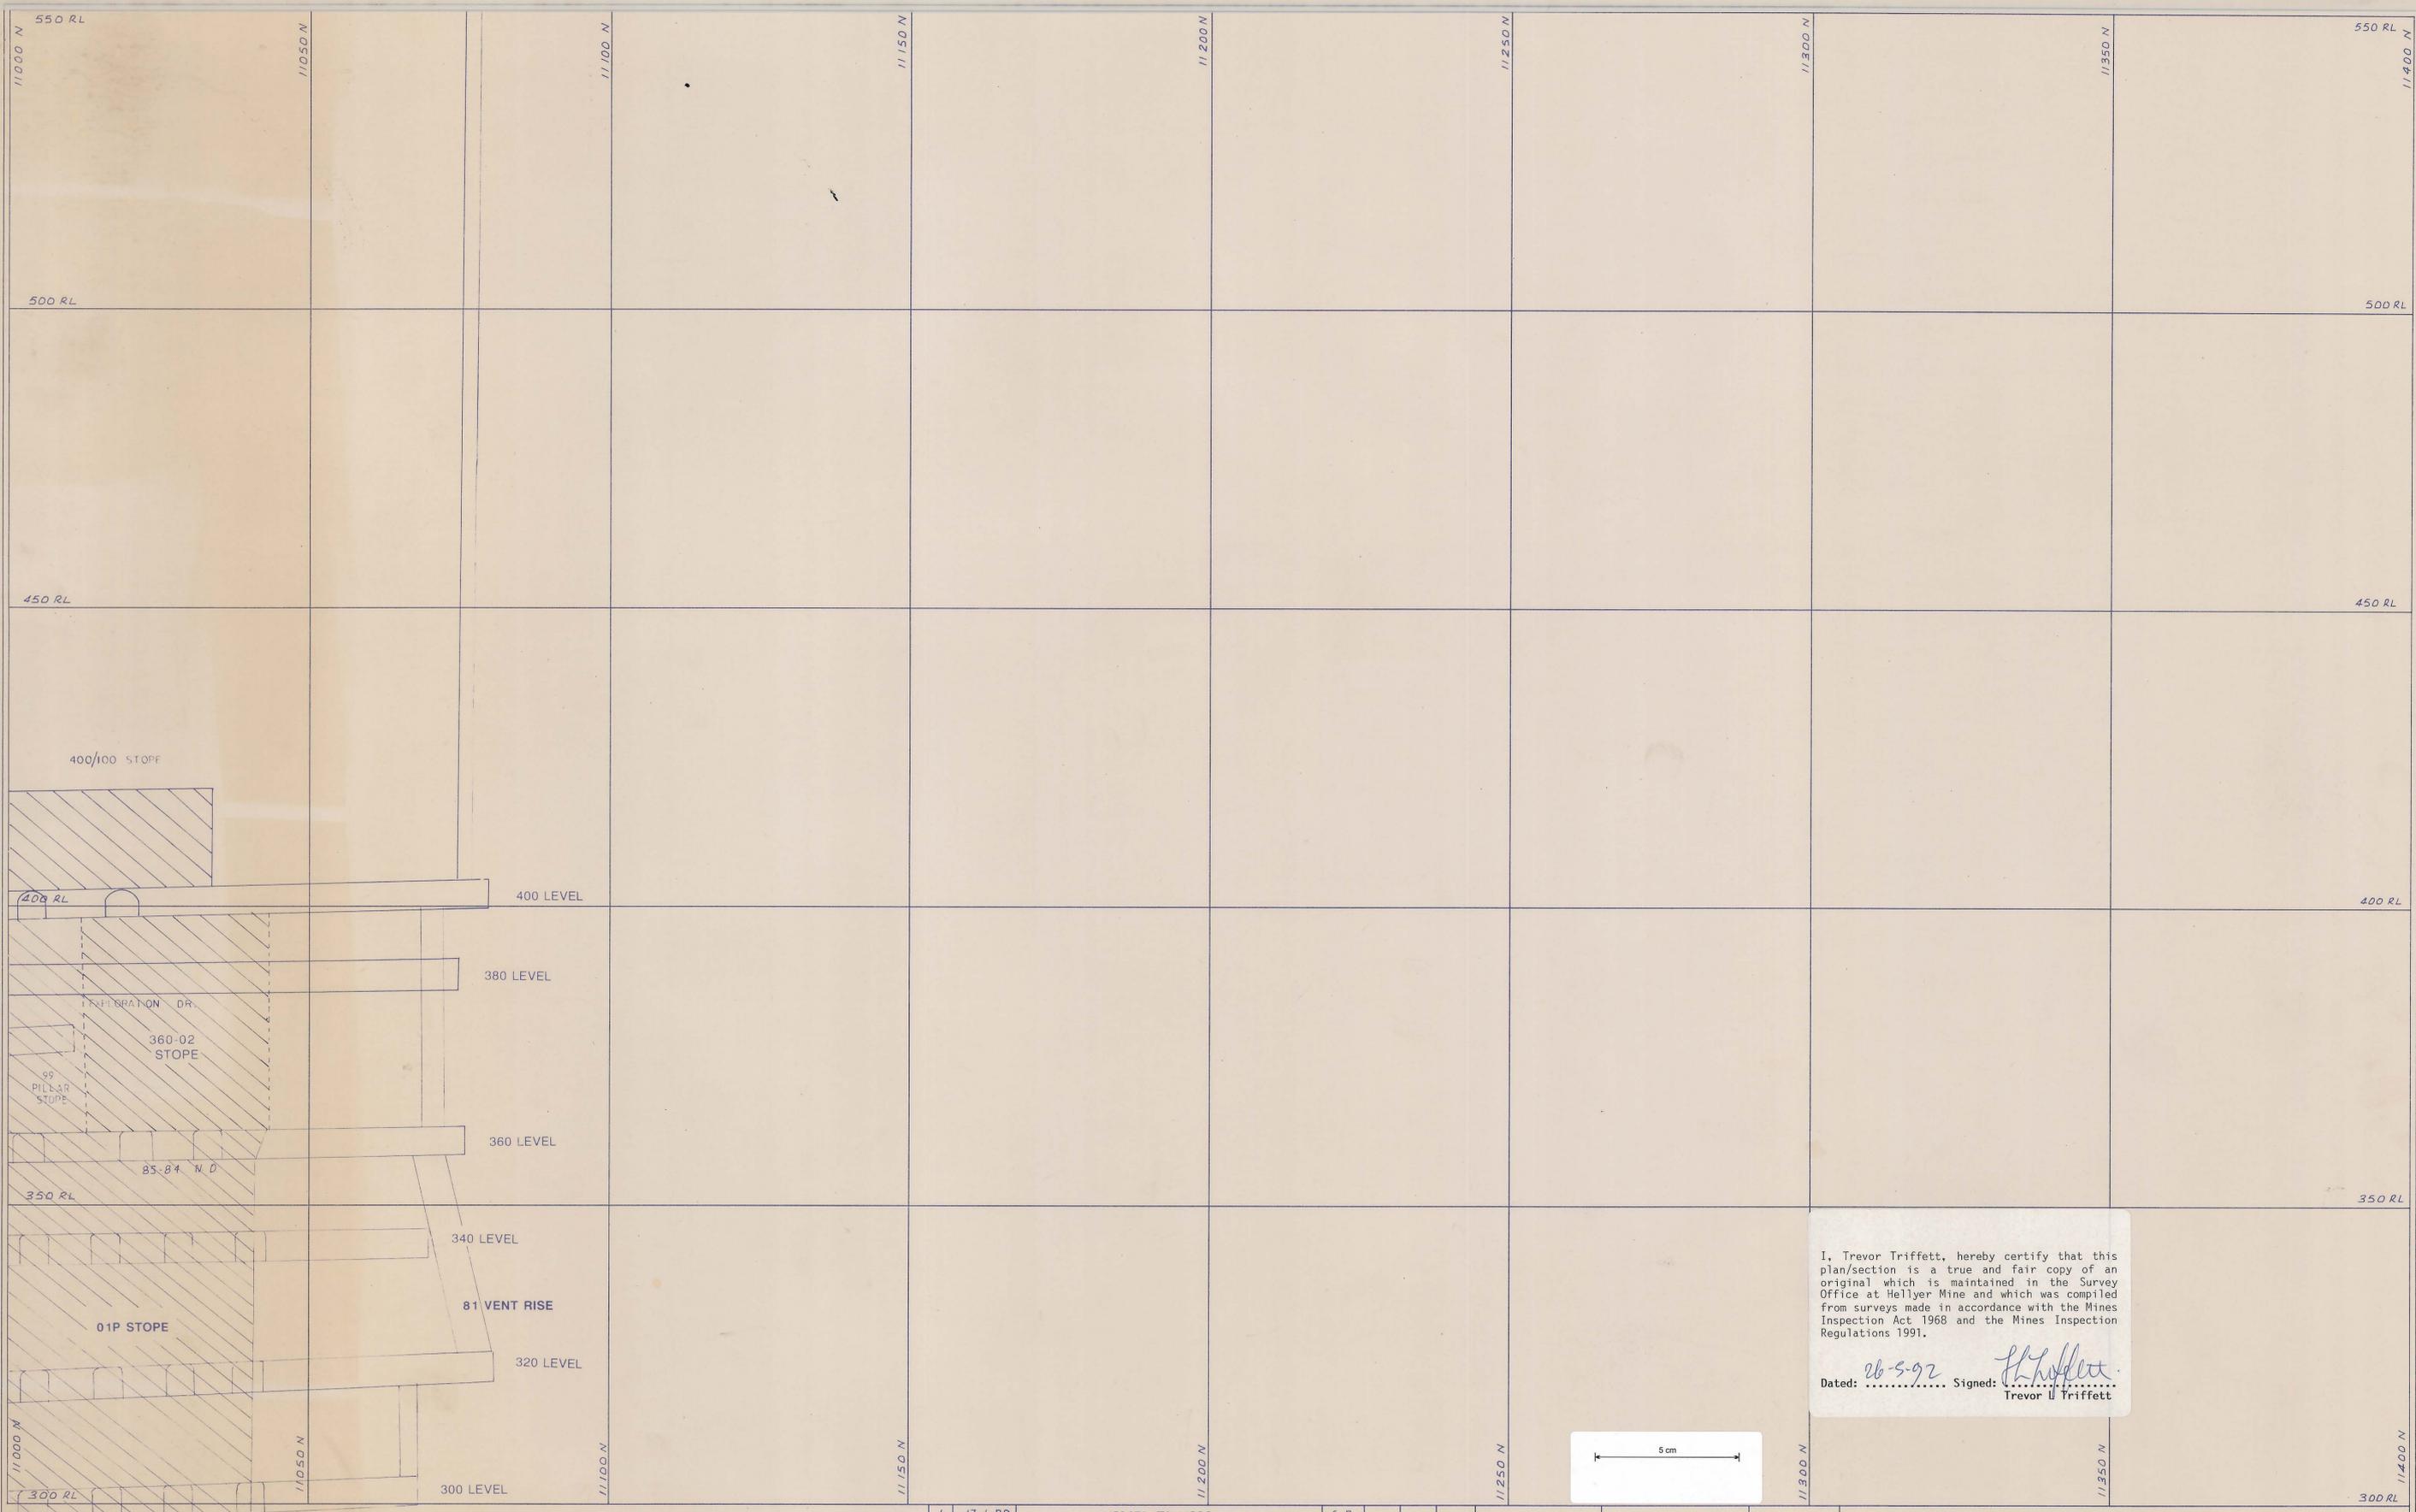


I, Trevor Triffett, hereby certify that this plan/section is a true and fair copy of an original which is maintained in the Survey Office at Hellyer Mine and which was compiled from surveys made in accordance with the Mines Inspection Act 1968 and the Mines Inspection Regulations 1991.

Dated: 26-5-92 Signed: *Trevor Triffett*
Trevor U Triffett

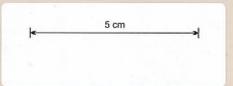

REV	DATE	REVISION	DRAWN	CKD	APP	APP
1	17-1-88	UPDATE TO 1988	C.P.			
2	29-3-89	" " 1989	C.P.			
3	28-12-89	" " 1990	C.P.			
4	13-4-91	" " 1991	DS			
5	4-2-92	" " 1992	DS			

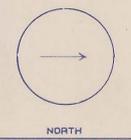

SCALE 1:500		
DRAWN	C. P.	FEB '87
CHECKED		
DESIGNED		
DESIGN CKD		
DESIGN APP		
PROJECT APP		

Aberfoyle Resources Limited
HELLYER DIVISION

LONGITUDINAL SECTION

DRAWING NO. HEL-010-1149	REVISION
------------------------------------	----------