
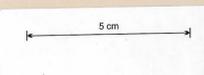


0406-129

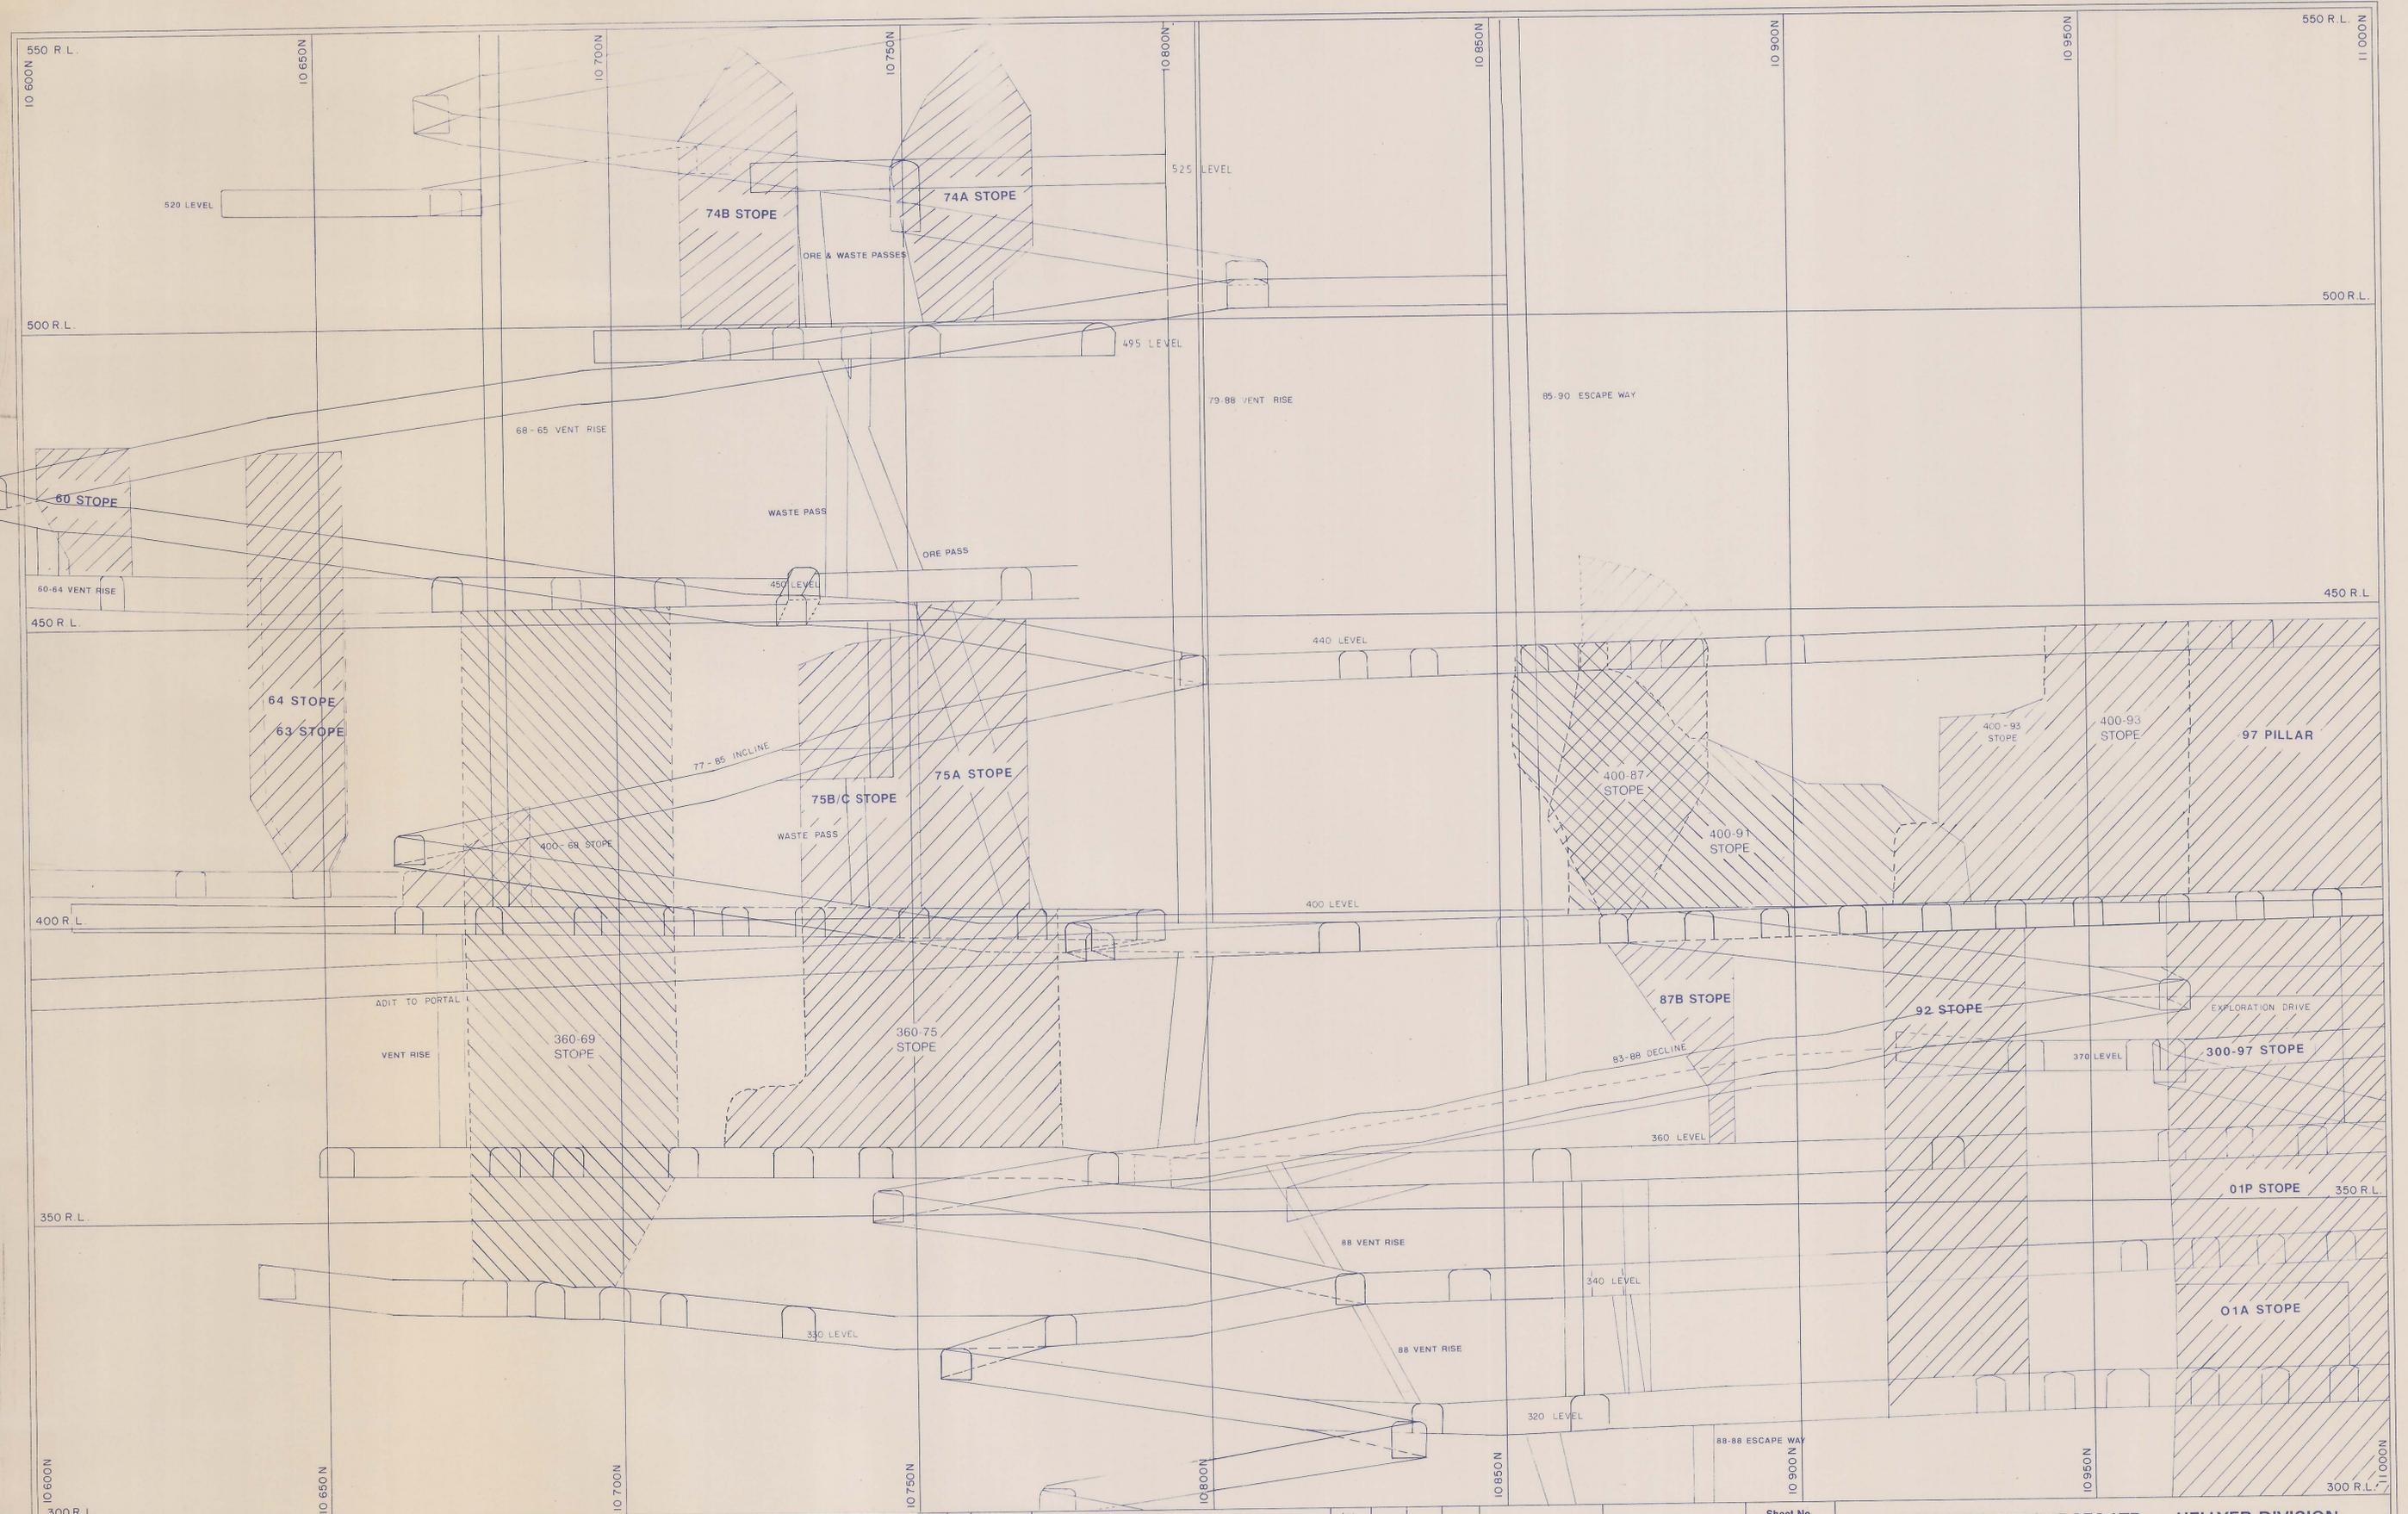

I, Trevor Triffett, hereby certify that this plan/section is a true and fair copy of an original which is maintained in the Survey Office at Hellyer Mine and which was compiled from surveys made in accordance with the Mines Inspection Act 1968 and the Mines Inspection Regulations 1991.

Dated: 26-5-92 Signed: *T. Triffett*  
Trevor L Triffett

REV	DATE	REVISION	DRAWN	CKD	APP	APP
1	15-4-91	UPDATE TO 1991	DAS			
2	17-2-92	" " 1992	DAS			



SCALE 1:500	Sheet No.
DRAWN	
CHECKED	
DESIGNED	
DESIGN CKD	
DESIGN APP	
PROJECT APP	

ABERFOYLE RESOURCES LTD. — HELLYER DIVISION	
PROJECT:	
DRAWING NO.	HEL-010-1148
REVISION	

**LONGITUDINAL SECTION**