


0406 - 132

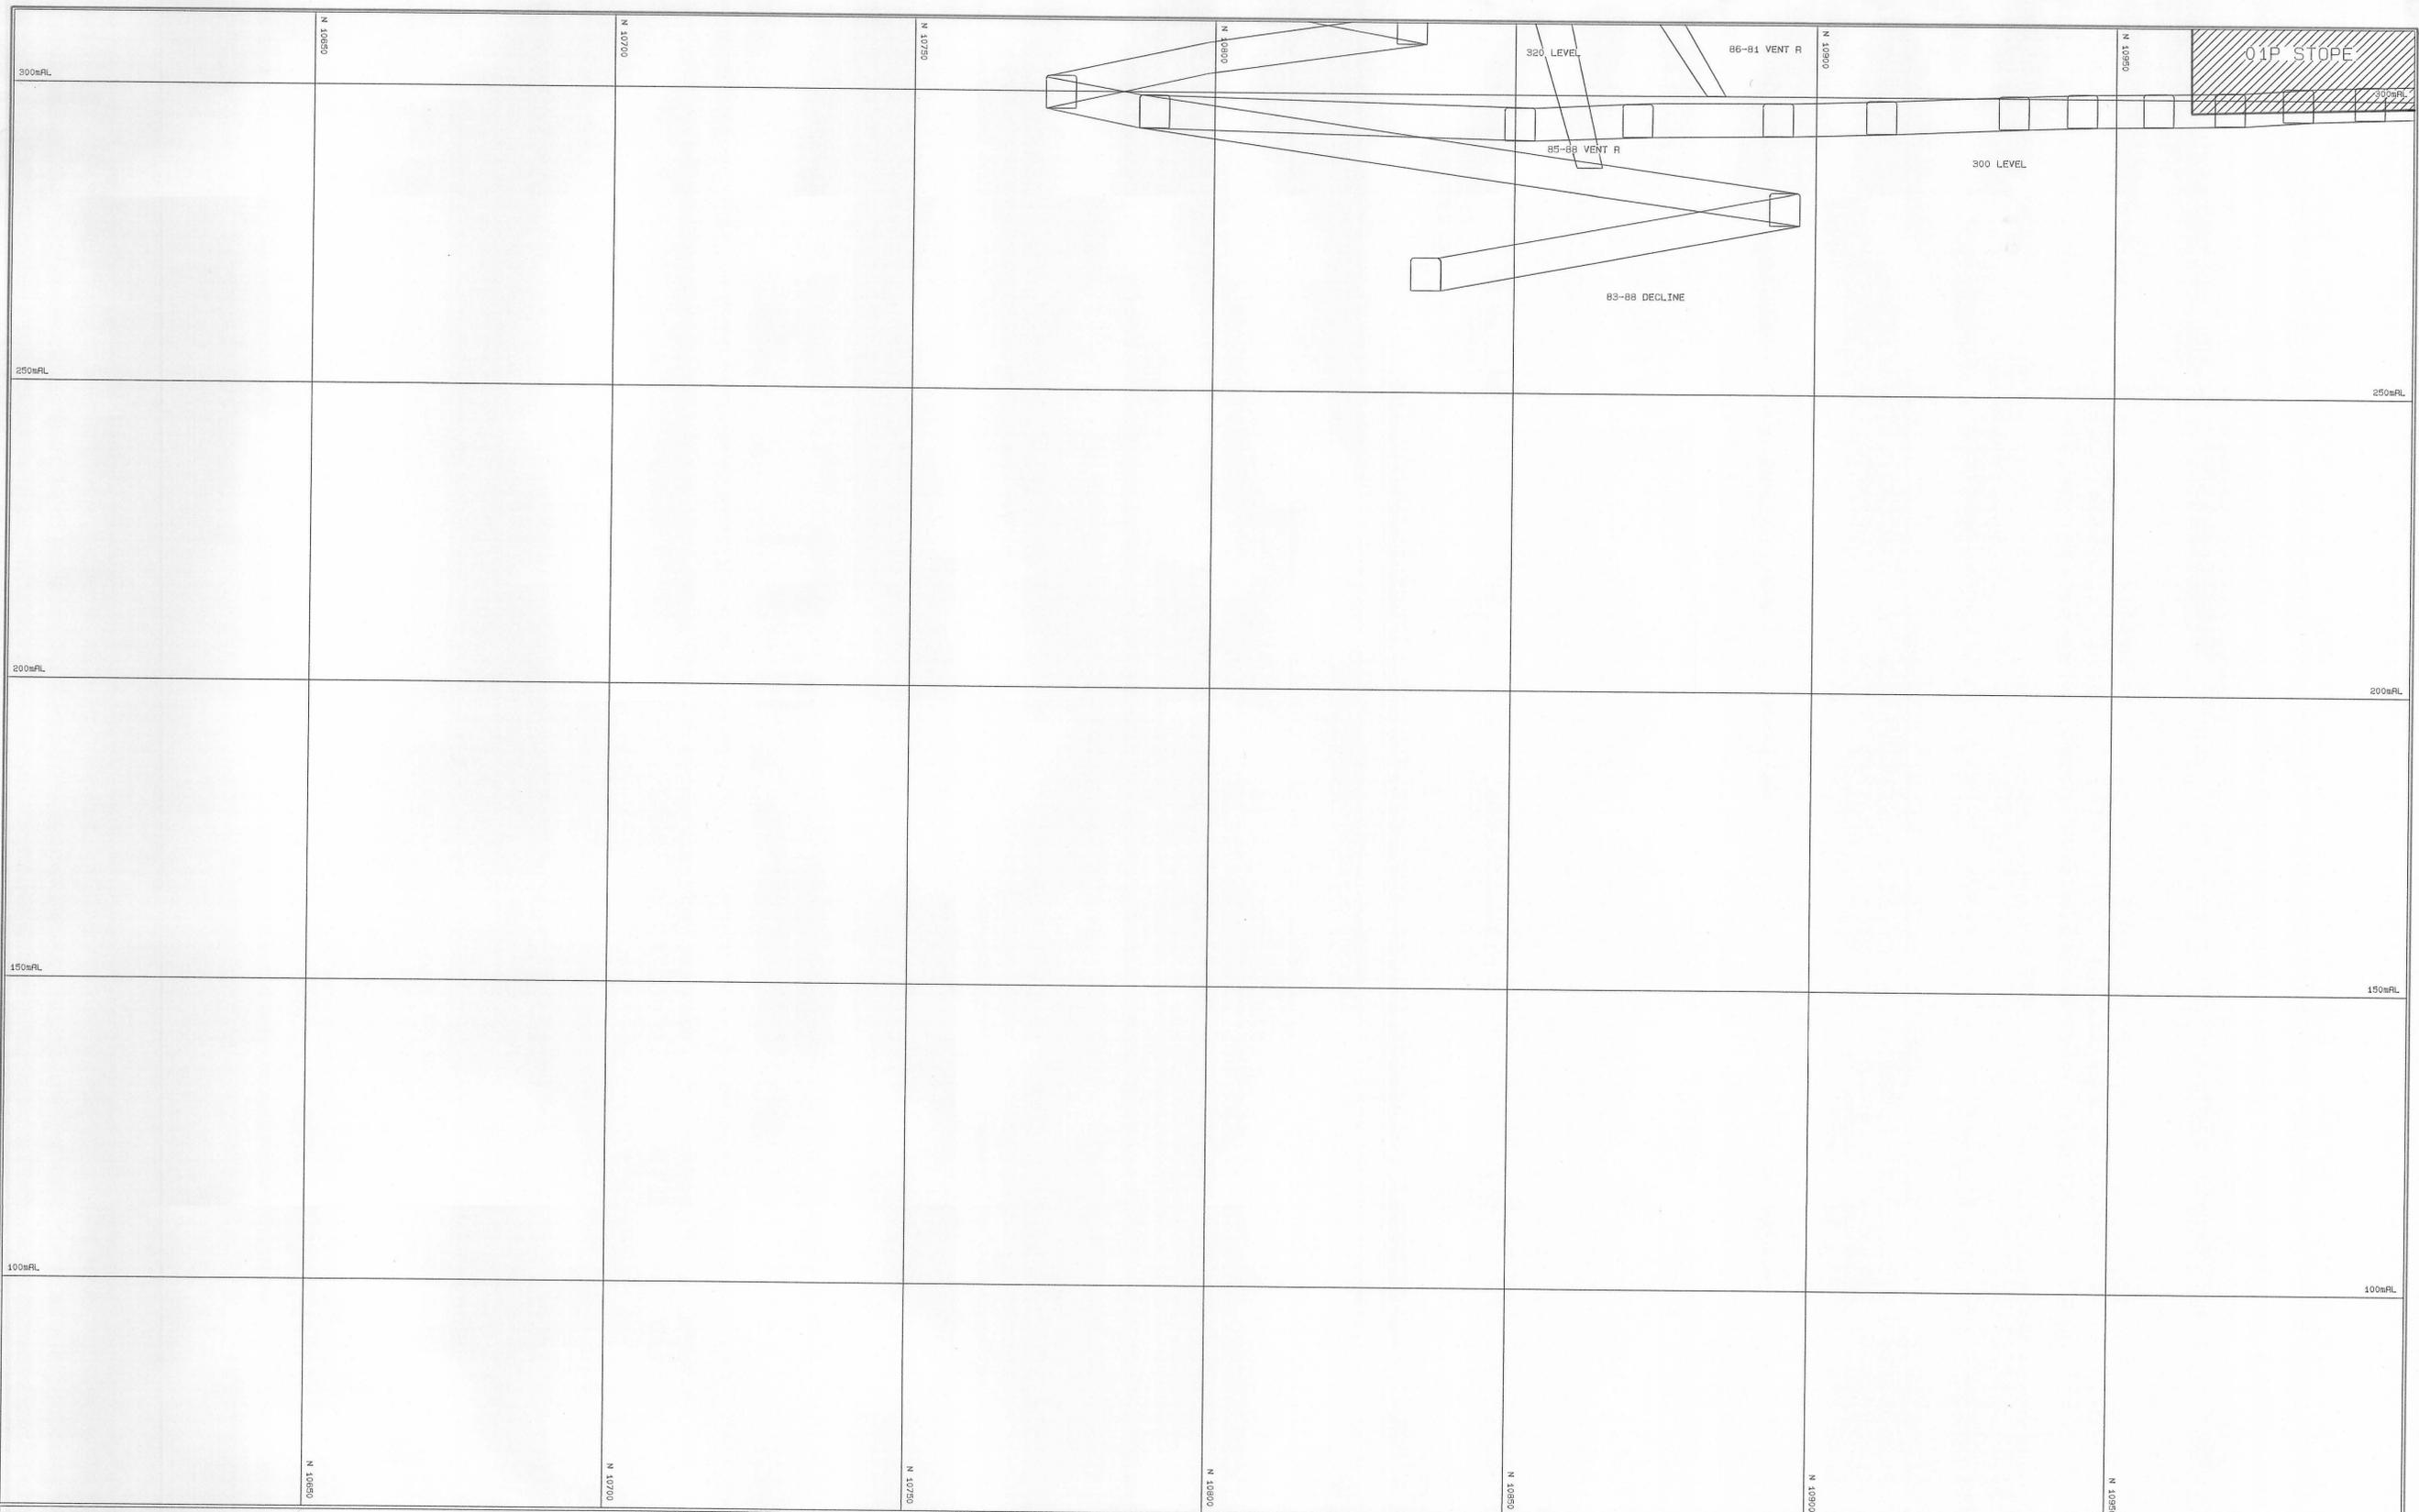

SURPAC SOFTWARE INTERNATIONAL, AUSTRALIA

I, Trevor Triffett, hereby certify that this plan/section is a true and fair copy of an original which is maintained in the Survey Office at Hellyer Mine and which was compiled from surveys made in accordance with the Mines Inspection Act 1968 and the Mines Inspection Regulations 1991.

Dated: 16-5-92 Signed: *T. Triffett*

- KEY**
- HP - PROBE HOLE
 - HA - COMP. AIR HOLE
 - HV - VENT HOLE
 - HE - ELECTRICAL HOLE
 - HM - WATER HOLE
 - HF - FILL HOLE

| REV | DATE | REVISION | DRAWN | CKD | APP | APP |
|-----|------|----------|-------|-----|-----|-----|
| | | | | | | |
| | | | | | | |
SCALE 1:500

| | | |
|--------------|--------------------|-----------|
| DRAWN | DAS | 19-FEB-92 |
| CHECKED | <i>[Signature]</i> | 15-4-92 |
| DESIGNED | | |
| DESIGN CKD. | | |
| DESIGN APP. | | |
| PROJECT APP. | | |

ABERFOYLE RESOURCES LTD.
HELLYER DIVISION

HELLYER MINE
LONG SECTION
REF. RL62 (Y) N10600 (X)

Drawing No. HEL
REVISION