


0406-148

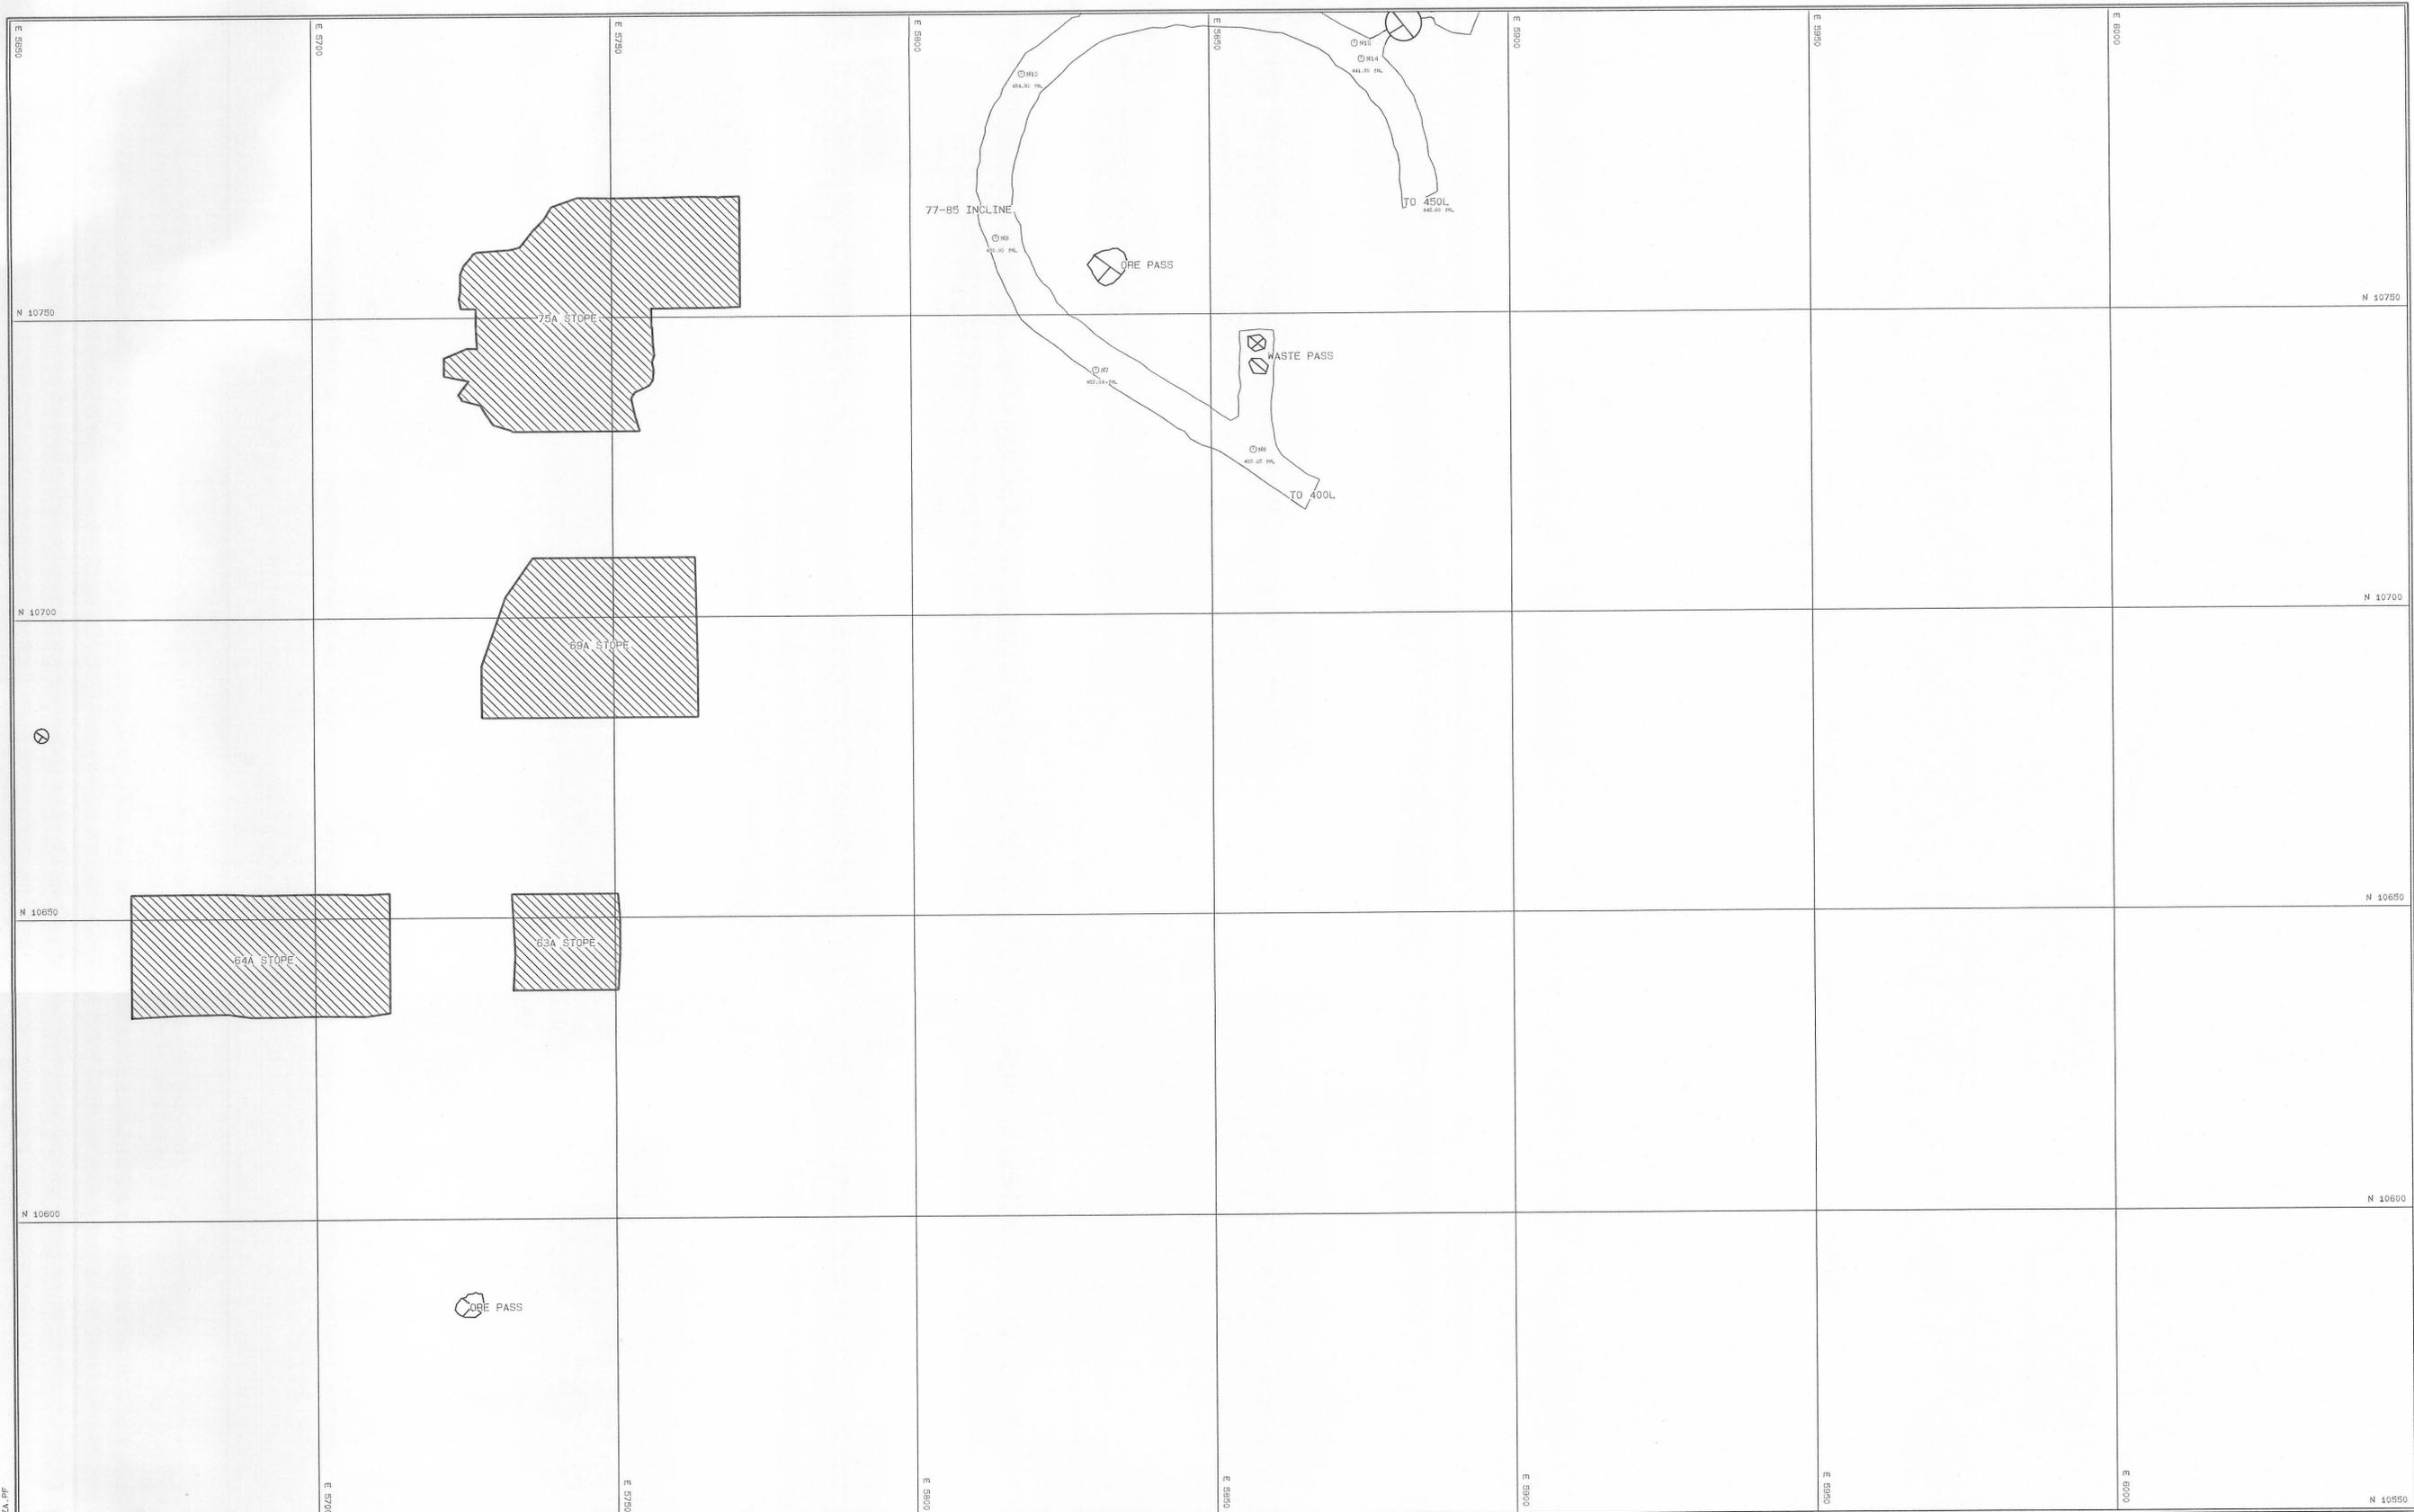

SURPAC SOFTWARE INTERNATIONAL, AUSTRALIA

I, Trevor Triffett, hereby certify that this plan/section is a true and fair copy of an original which is maintained in the Survey Office at Hellyer Mine and which was compiled from surveys made in accordance with the Mines Inspection Act 1968 and the Mines Inspection Regulations 1991.

Dated: 26.5.92 Signed: *T. Triffett*
Trevor L Triffett

REV	DATE	REVISION	DRAWN	CND	APP	APP



SCALE 1: 500

DRAWN	DAS	8-FEB-92
CHECKED	<i>ST</i>	15-4-92
DESIGNED		
DESIGN CND.		
DESIGN APP.		
PROJECT APP.		

ABERFOYLE RESOURCES LTD.
HELLYER DIVISION

HELLYER MINE
LEVEL PLAN
440m HORIZON

Drawing No. _____
REVISION _____

