



0406-151

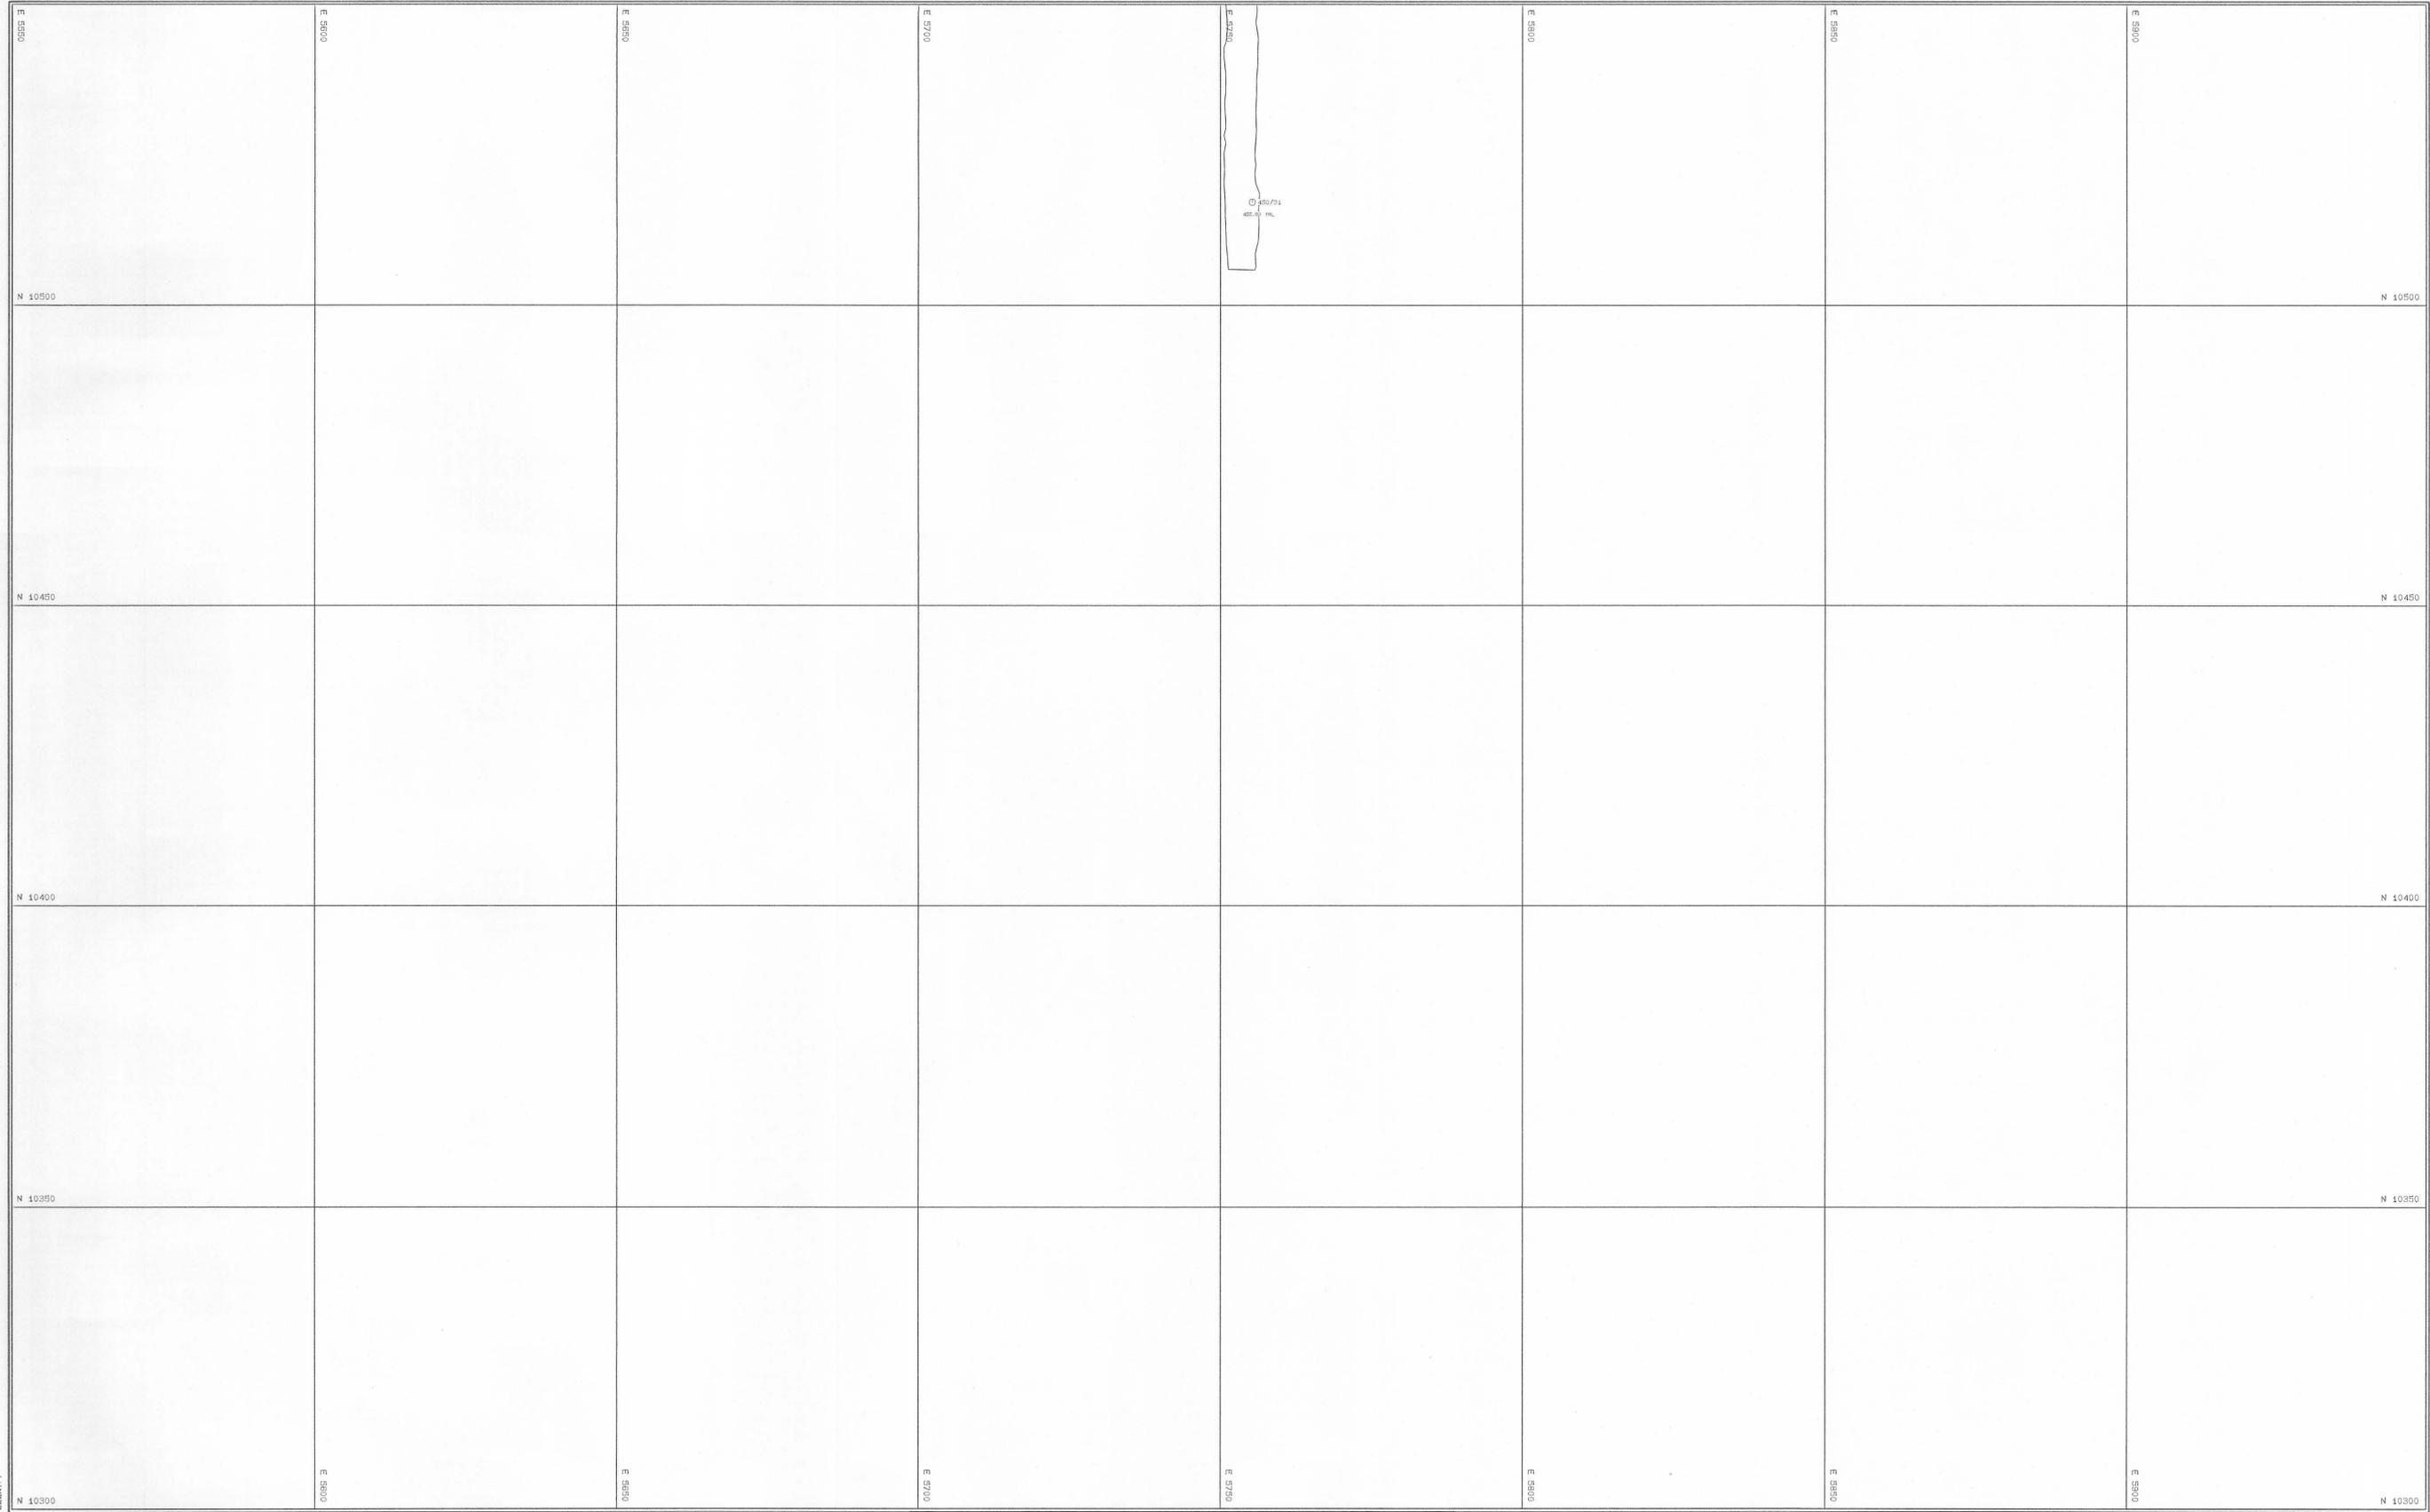

722A PF

SURPAC SOFTWARE INTERNATIONAL, AUSTRALIA

I, Trevor Triffett, hereby certify that this plan/section is a true and fair copy of an original which is maintained in the Survey Office at Hellyer Mine and which was compiled from surveys made in accordance with the Mines Inspection Act 1968 and the Mines Inspection Regulations 1991.

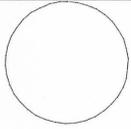

SCALE 1:500		
DRAWN	DAS	5-FEB-92
CHECKED	<i>ST</i>	15-4-92
DESIGNED		
DESIGN CND.		

ABERFOYLE RESOURCES LTD.
 HELLYER DIVISION
 HELLYER MINE
 I/FVI PLAN

Drawing No. _____