


0406-172

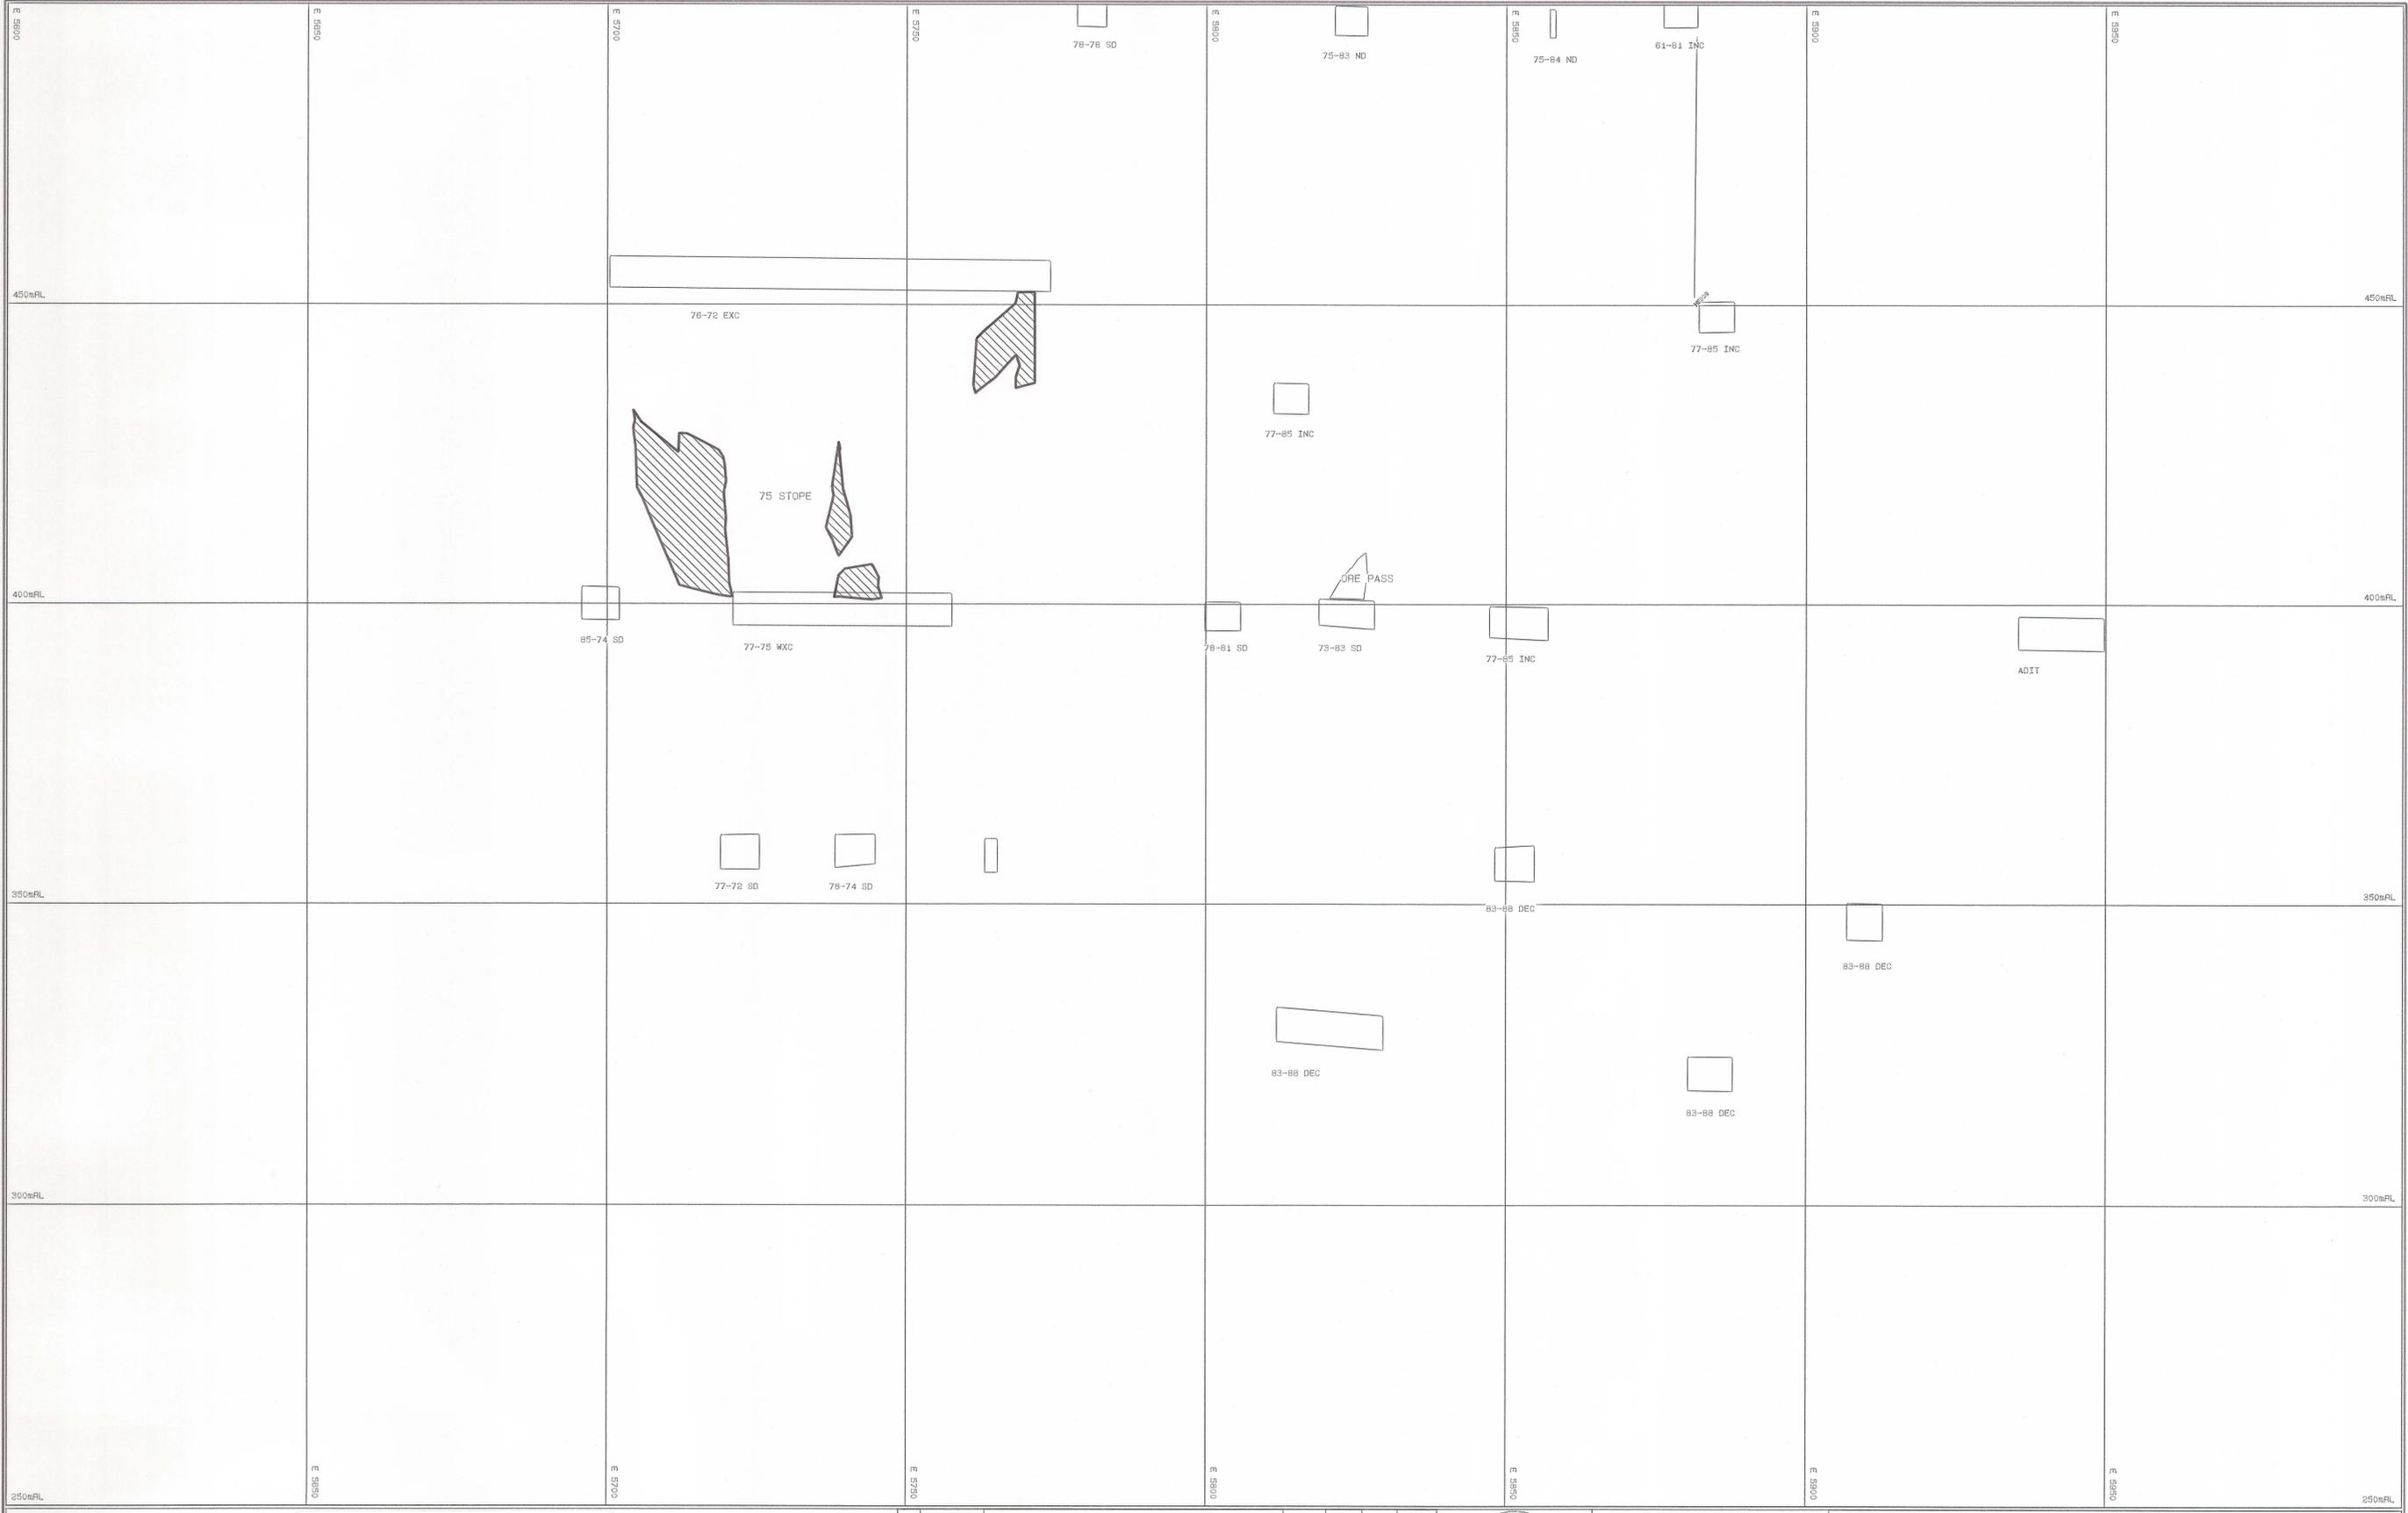

BURPAC SOFTWARE INTERNATIONAL, AUSTRALIA


I, Trevor Triffett, hereby certify that this plan/section is a true and fair copy of an original which is maintained in the Survey Office at Hellyer Mine and which was compiled from surveys made in accordance with the Mines Inspection Act 1968 and the Mines Inspection Regulations 1991.

Dated: 26-5-92 Signed: *T. Triffett*  
Trevor L Triffett

KEY

HP = PROBE HOLE  
 HA = COMP. AIR HOLE  
 HV = VENT HOLE  
 HE = ELECTRICAL HOLE  
 HM = WATER HOLE  
 HF = FILL HOLE

REV	DATE	REVISION	DRAWN	CND	APP	APP

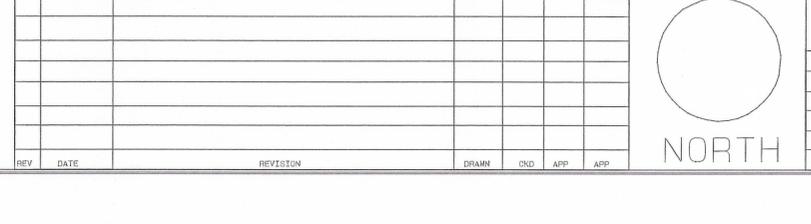

SCALE 1: 500

DRAWN	AMS	17-FEB-92
CHECKED	<i>YEA</i>	<i>15/92</i>
DESIGNED		
DESIGN CND.		
DESIGN APP.		
PROJECT APP.		

**ABERFOYLE RESOURCES LTD.**  
**HELLYER DIVISION**

HELLYER MINE  
 CROSS SECTION  
 10770 NORTH

Drawing No. /  
 REVISION