


0406-173

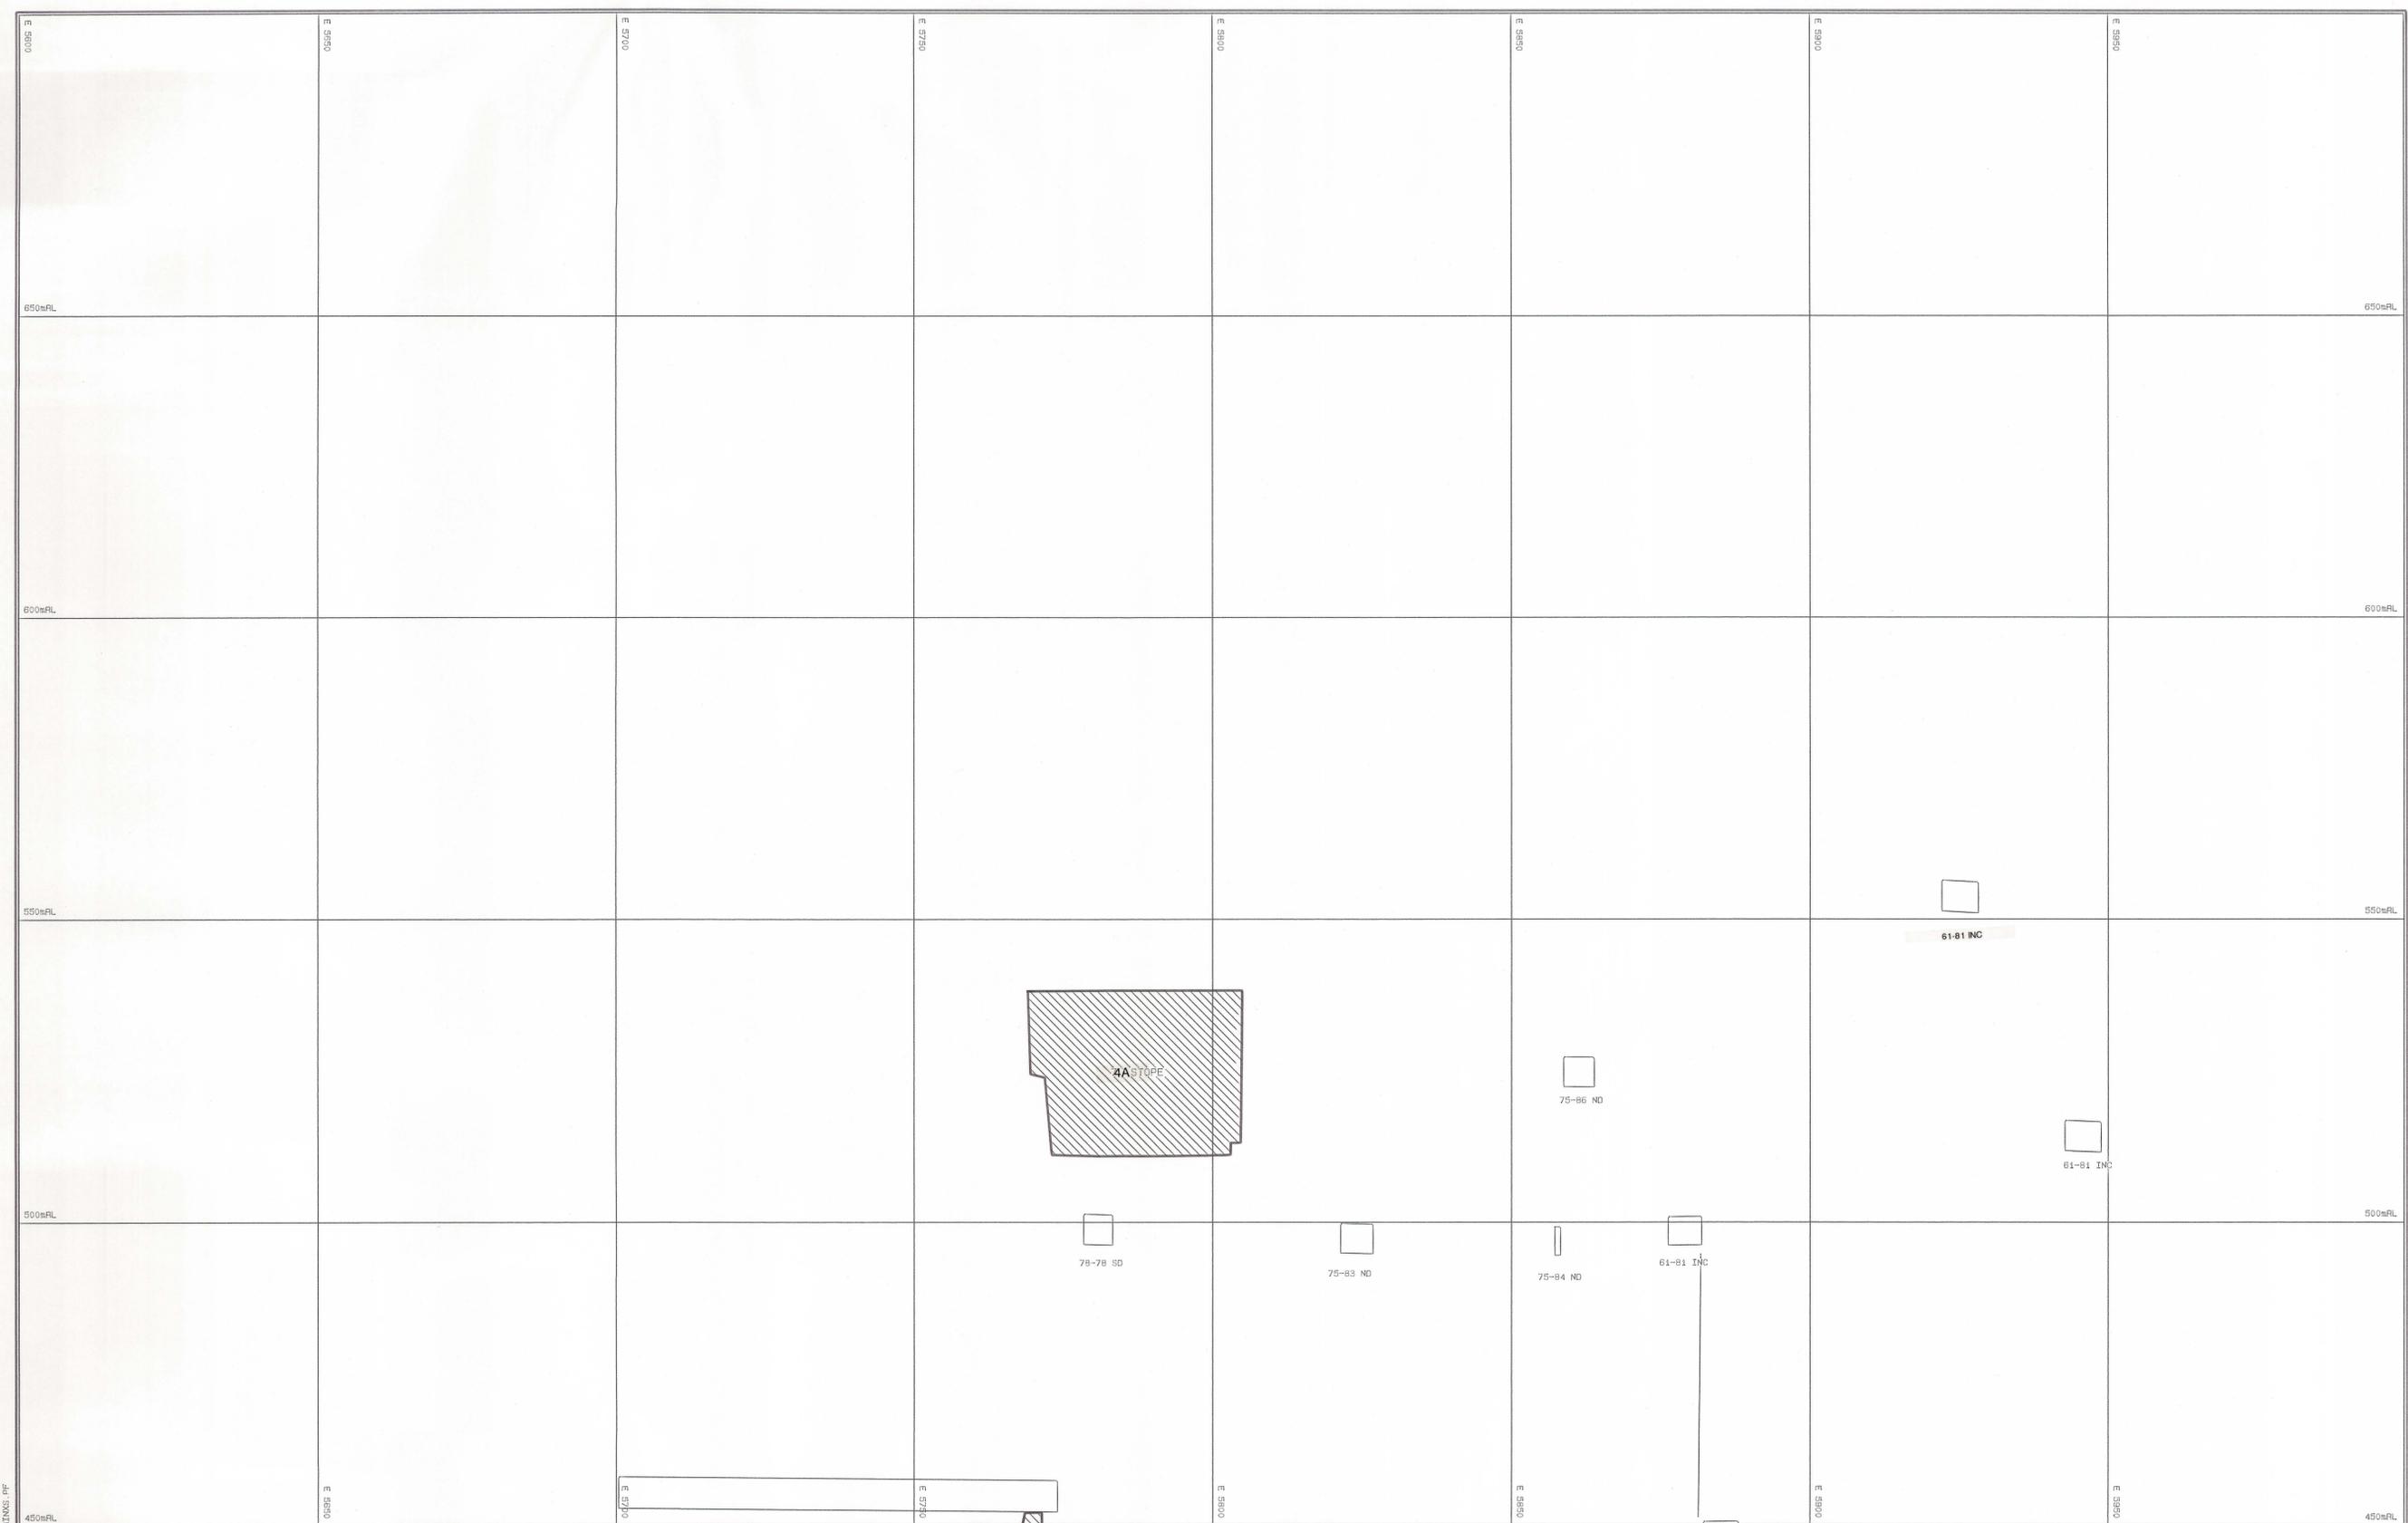

MUNDO, PF  
SURPAC SOFTWARE INTERNATIONAL, AUSTRALIA

I, Trevor Triffett, hereby certify that this plan/section is a true and fair copy of an original which is maintained in the Survey Office at Hellyer Mine and which was compiled from surveys made in accordance with the Mines Inspection Act 1968 and the Mines Inspection Regulations 1991.

Dated: 26-5-92 Signed: *T. Triffett*  
Trevor L Triffett

KEY

- NP = PROBE HOLE
- NA = COMP. AIR HOLE
- NV = VENT HOLE
- NE = ELECTRICAL HOLE
- NW = WATER HOLE
- NF = FILL HOLE

REV	DATE	REVISION	DRAWN	CKD	APP	APP



SCALE 1: 500

DRAWN	AMS	17-FEB-92
CHECKED	<i>sd.</i>	15-5-92
DESIGNED		
DESIGN CKD.		
DESIGN APP.		
PROJECT APP.		

**ABERFOYLE RESOURCES LTD.**  
**HELLYER DIVISION**

HELLYER MINE  
CROSS SECTION  
10770 NORTH

Drawing No.	/
REVISION	

