


0406-190

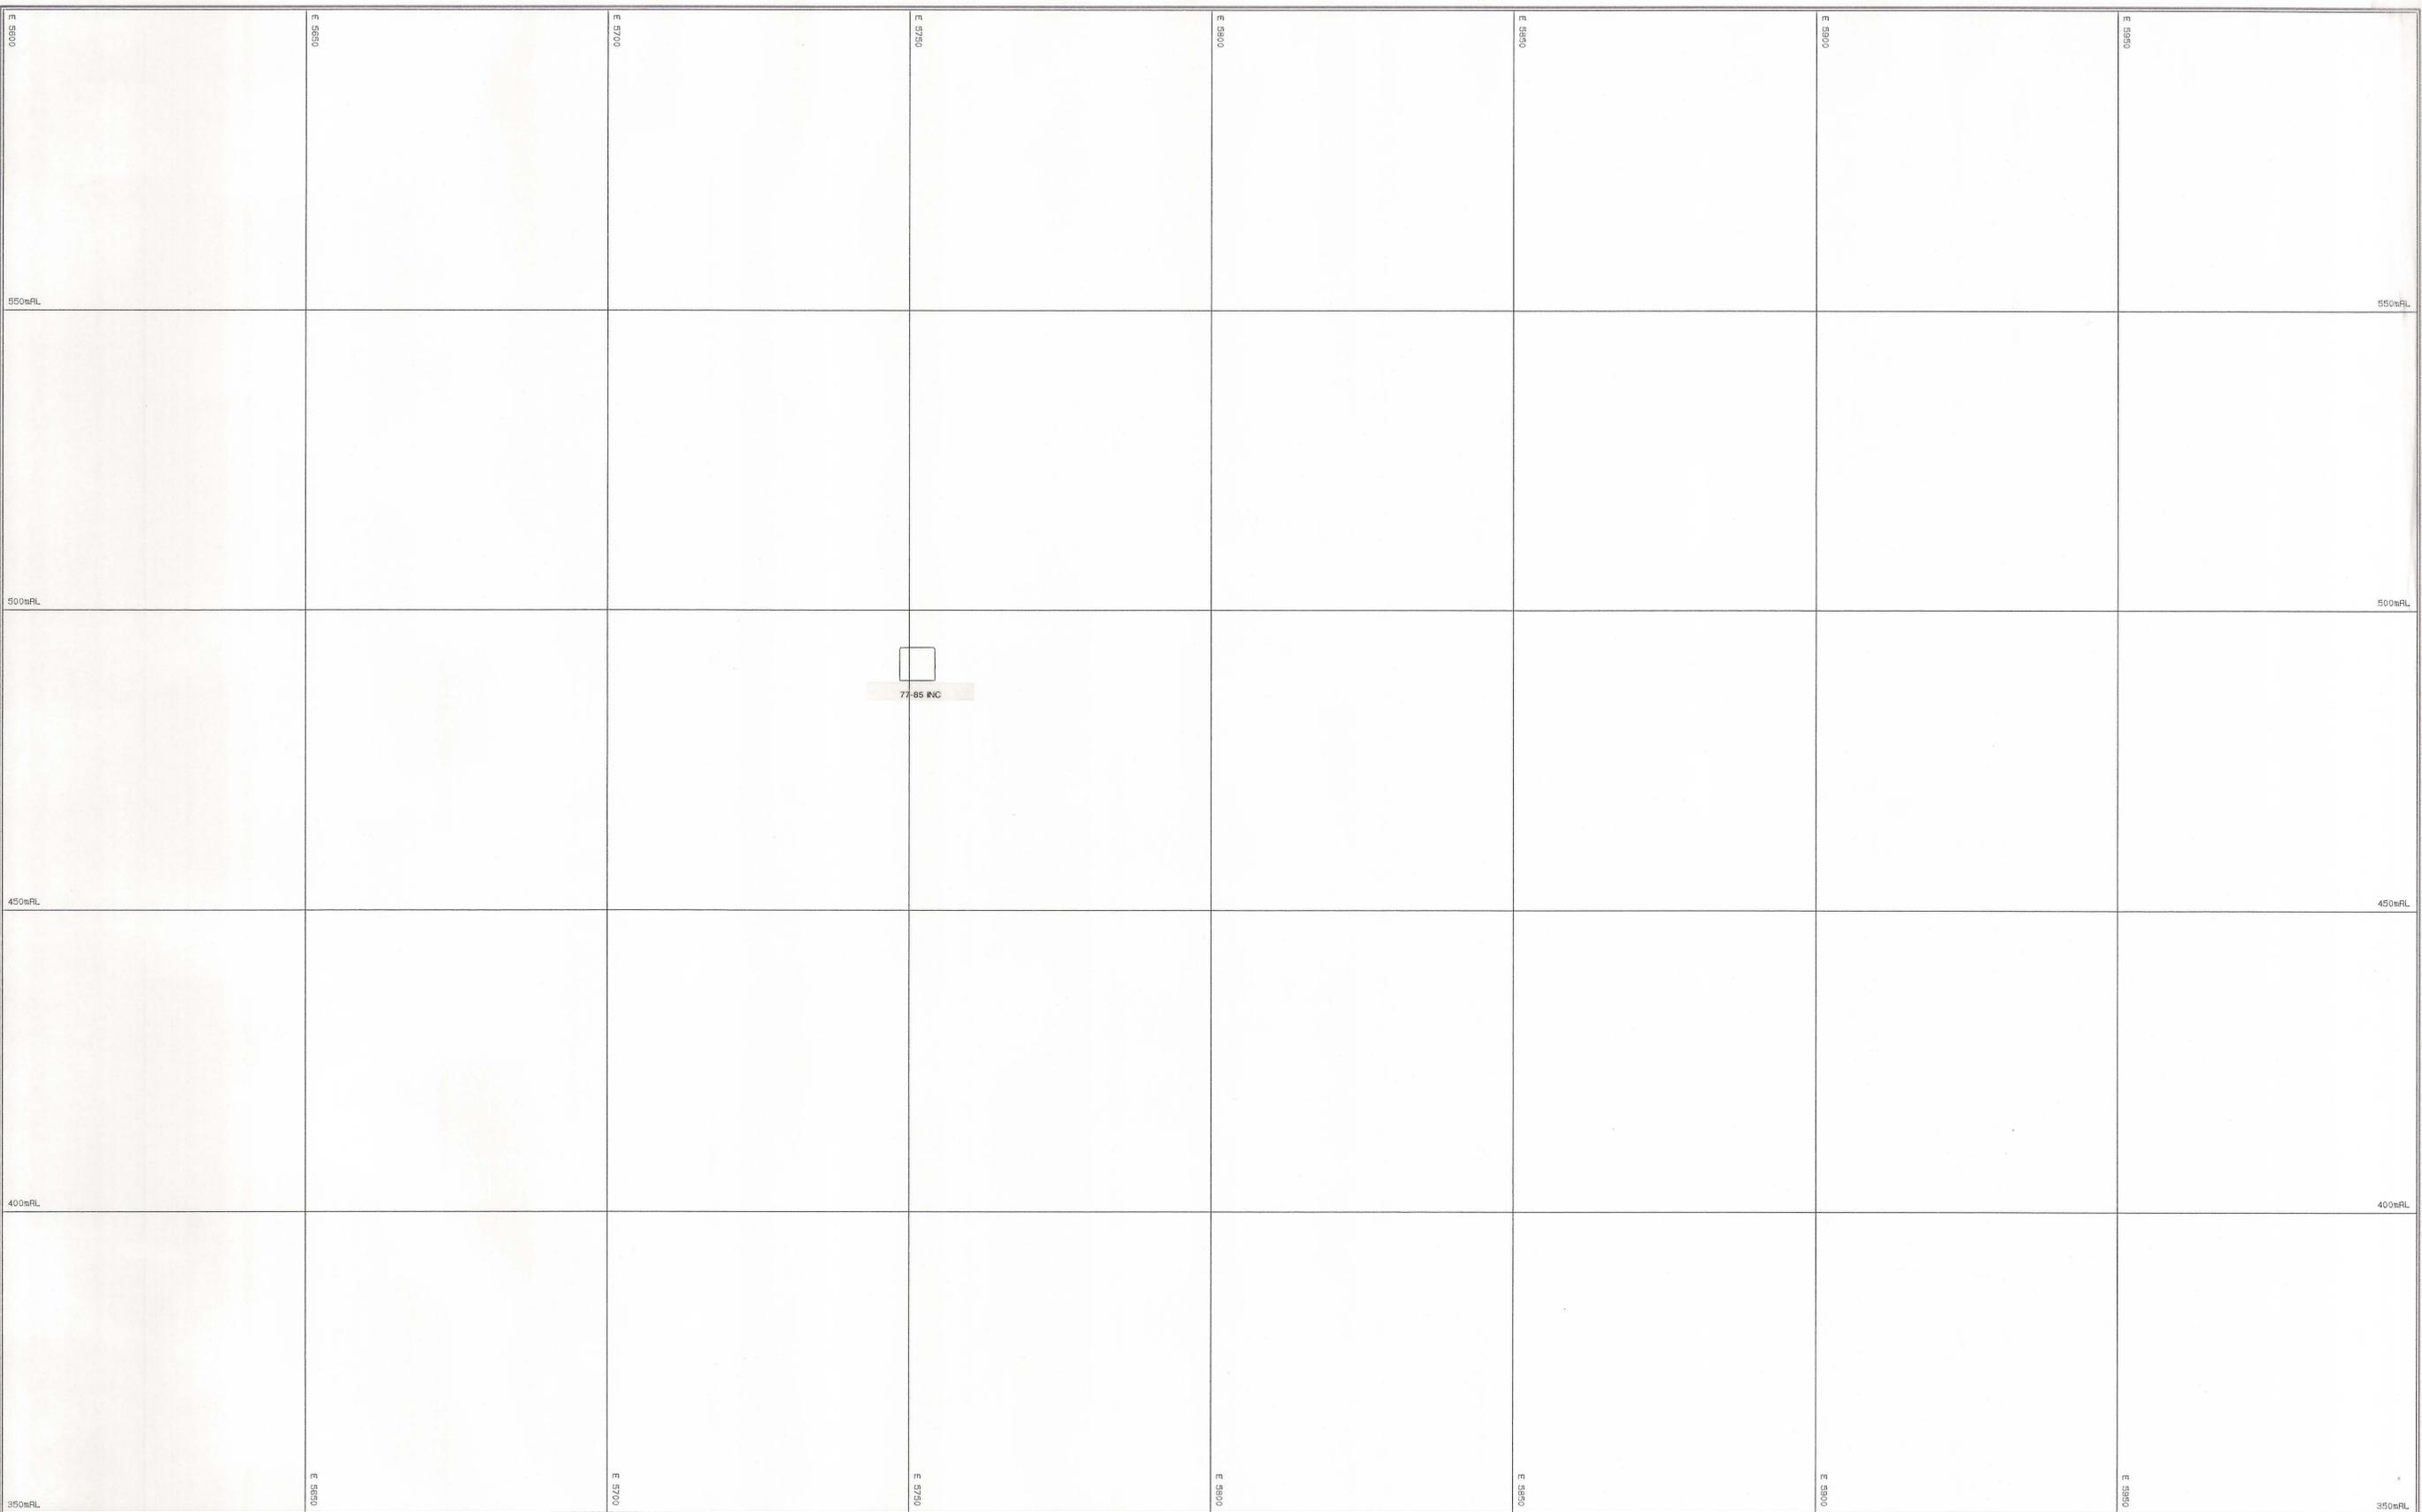

BURPAC SOFTWARE INTERNATIONAL, AUSTRALIA


I, Trevor Triffett, hereby certify that this plan/section is a true and fair copy of an original which is maintained in the Survey Office at Hellyer Mine and which was compiled from surveys made in accordance with the Mines Inspection Act 1968 and the Mines Inspection Regulations 1991.

Dated: 26/5/92 Signed: *Trevor L Triffett*
Trevor L Triffett

KEY

HP	=	PIEGRE HOLE
HA	=	COMP. AIR HOLE
HV	=	VENT HOLE
HE	=	ELECTRICAL HOLE
HW	=	WATER HOLE
HF	=	FILL HOLE

REV	DATE	REVISION	DRAWN	CHK	APP	APP

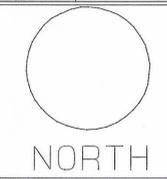

SCALE 1:500

DRAWN	AKS	17-FEB-92
CHECKED	<i>SP</i>	<i>18-92</i>
DESIGNED		
DESIGN CHK.		
DESIGN APP.		
PROJECT APP.		

ABERFOYLE RESOURCES LTD.
HELLYER DIVISION

HELLYER MINE
CROSS SECTION
10470 NORTH

Drawing No. /
REVISION

