
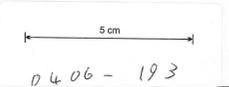


0406 - 193

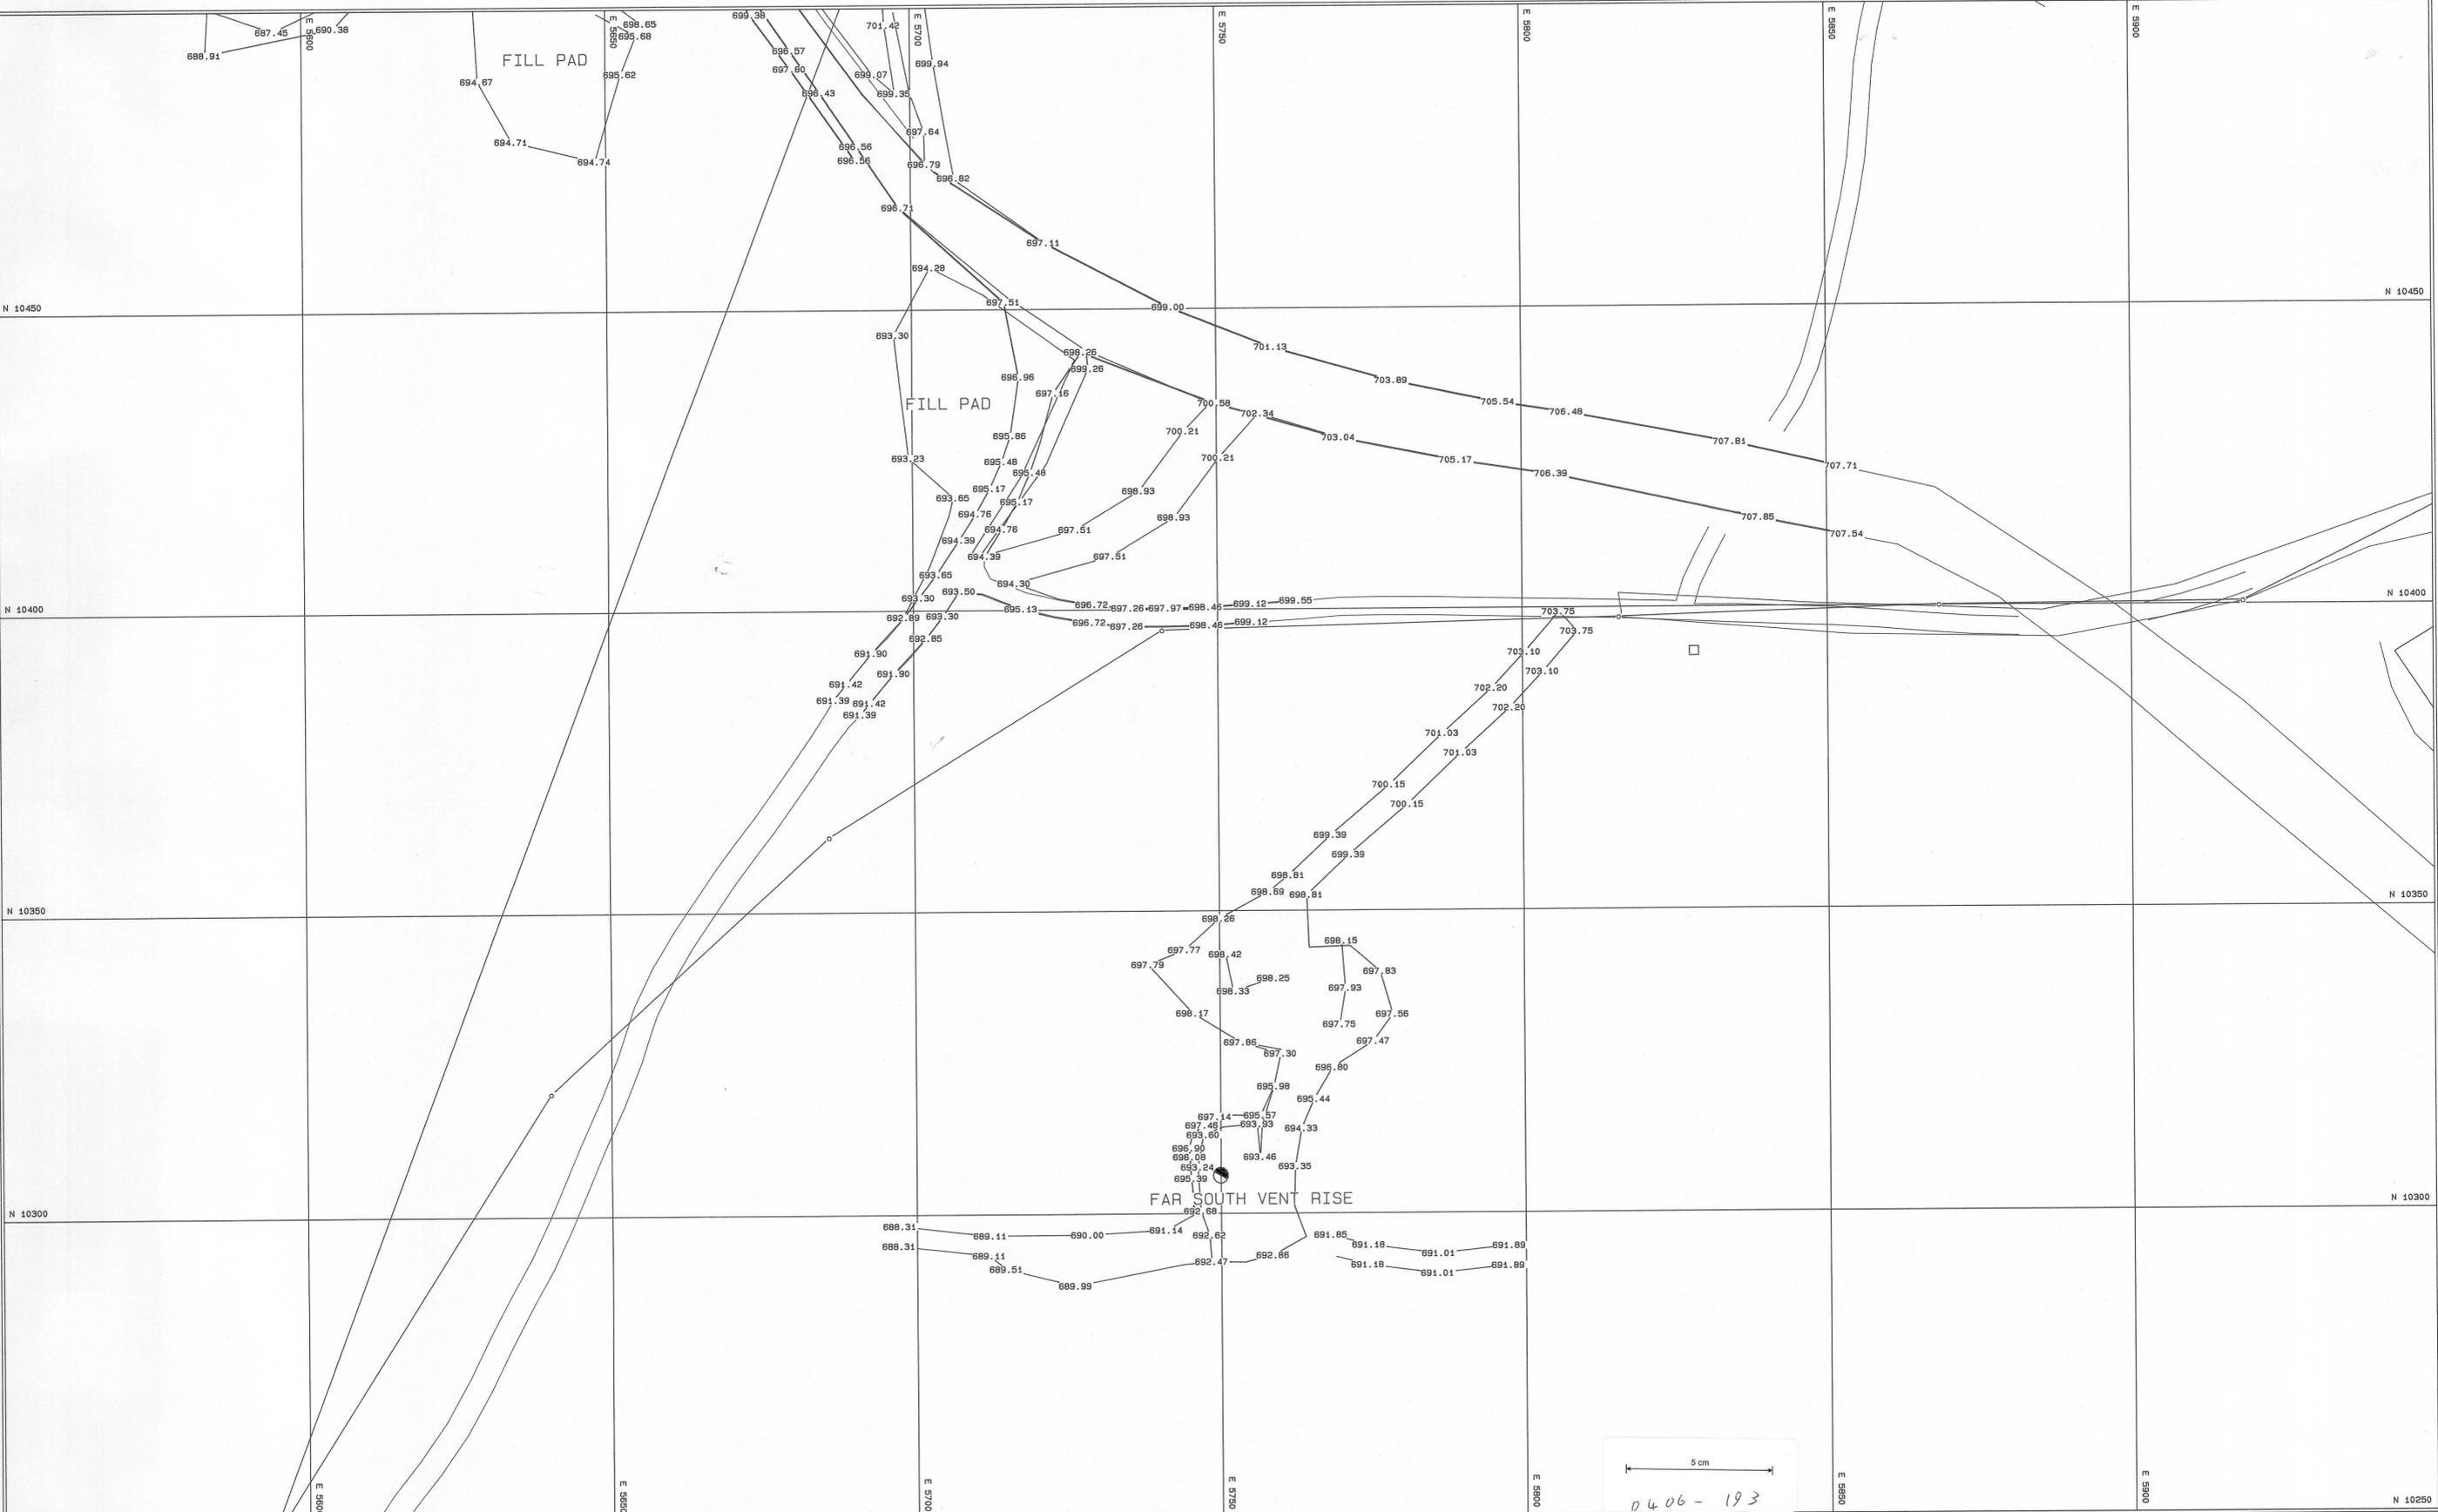

KEY

- HP = PROBE HOLE
- HA = COMP. AIR HOLE
- HV = VENT HOLE
- HE = ELECTRICAL HOLE
- HM = WATER HOLE
- HF = FILL HOLE

REV	DATE	REVISION	DRAWN	CHKD	APP	APP



SCALE 1: 500

DRAWN	TT/DS	16-Dec-94
CHECKED		
DESIGNED		
DESIGN OKD.		
DESIGN APP.		
PROJECT APP.		

ABERFOYLE RESOURCES LTD.
HELLYER DIVISION

SURFACE WORKINGS
1994

Drawing No. SURF 10

REVISION

genera1.pf