


0406-200

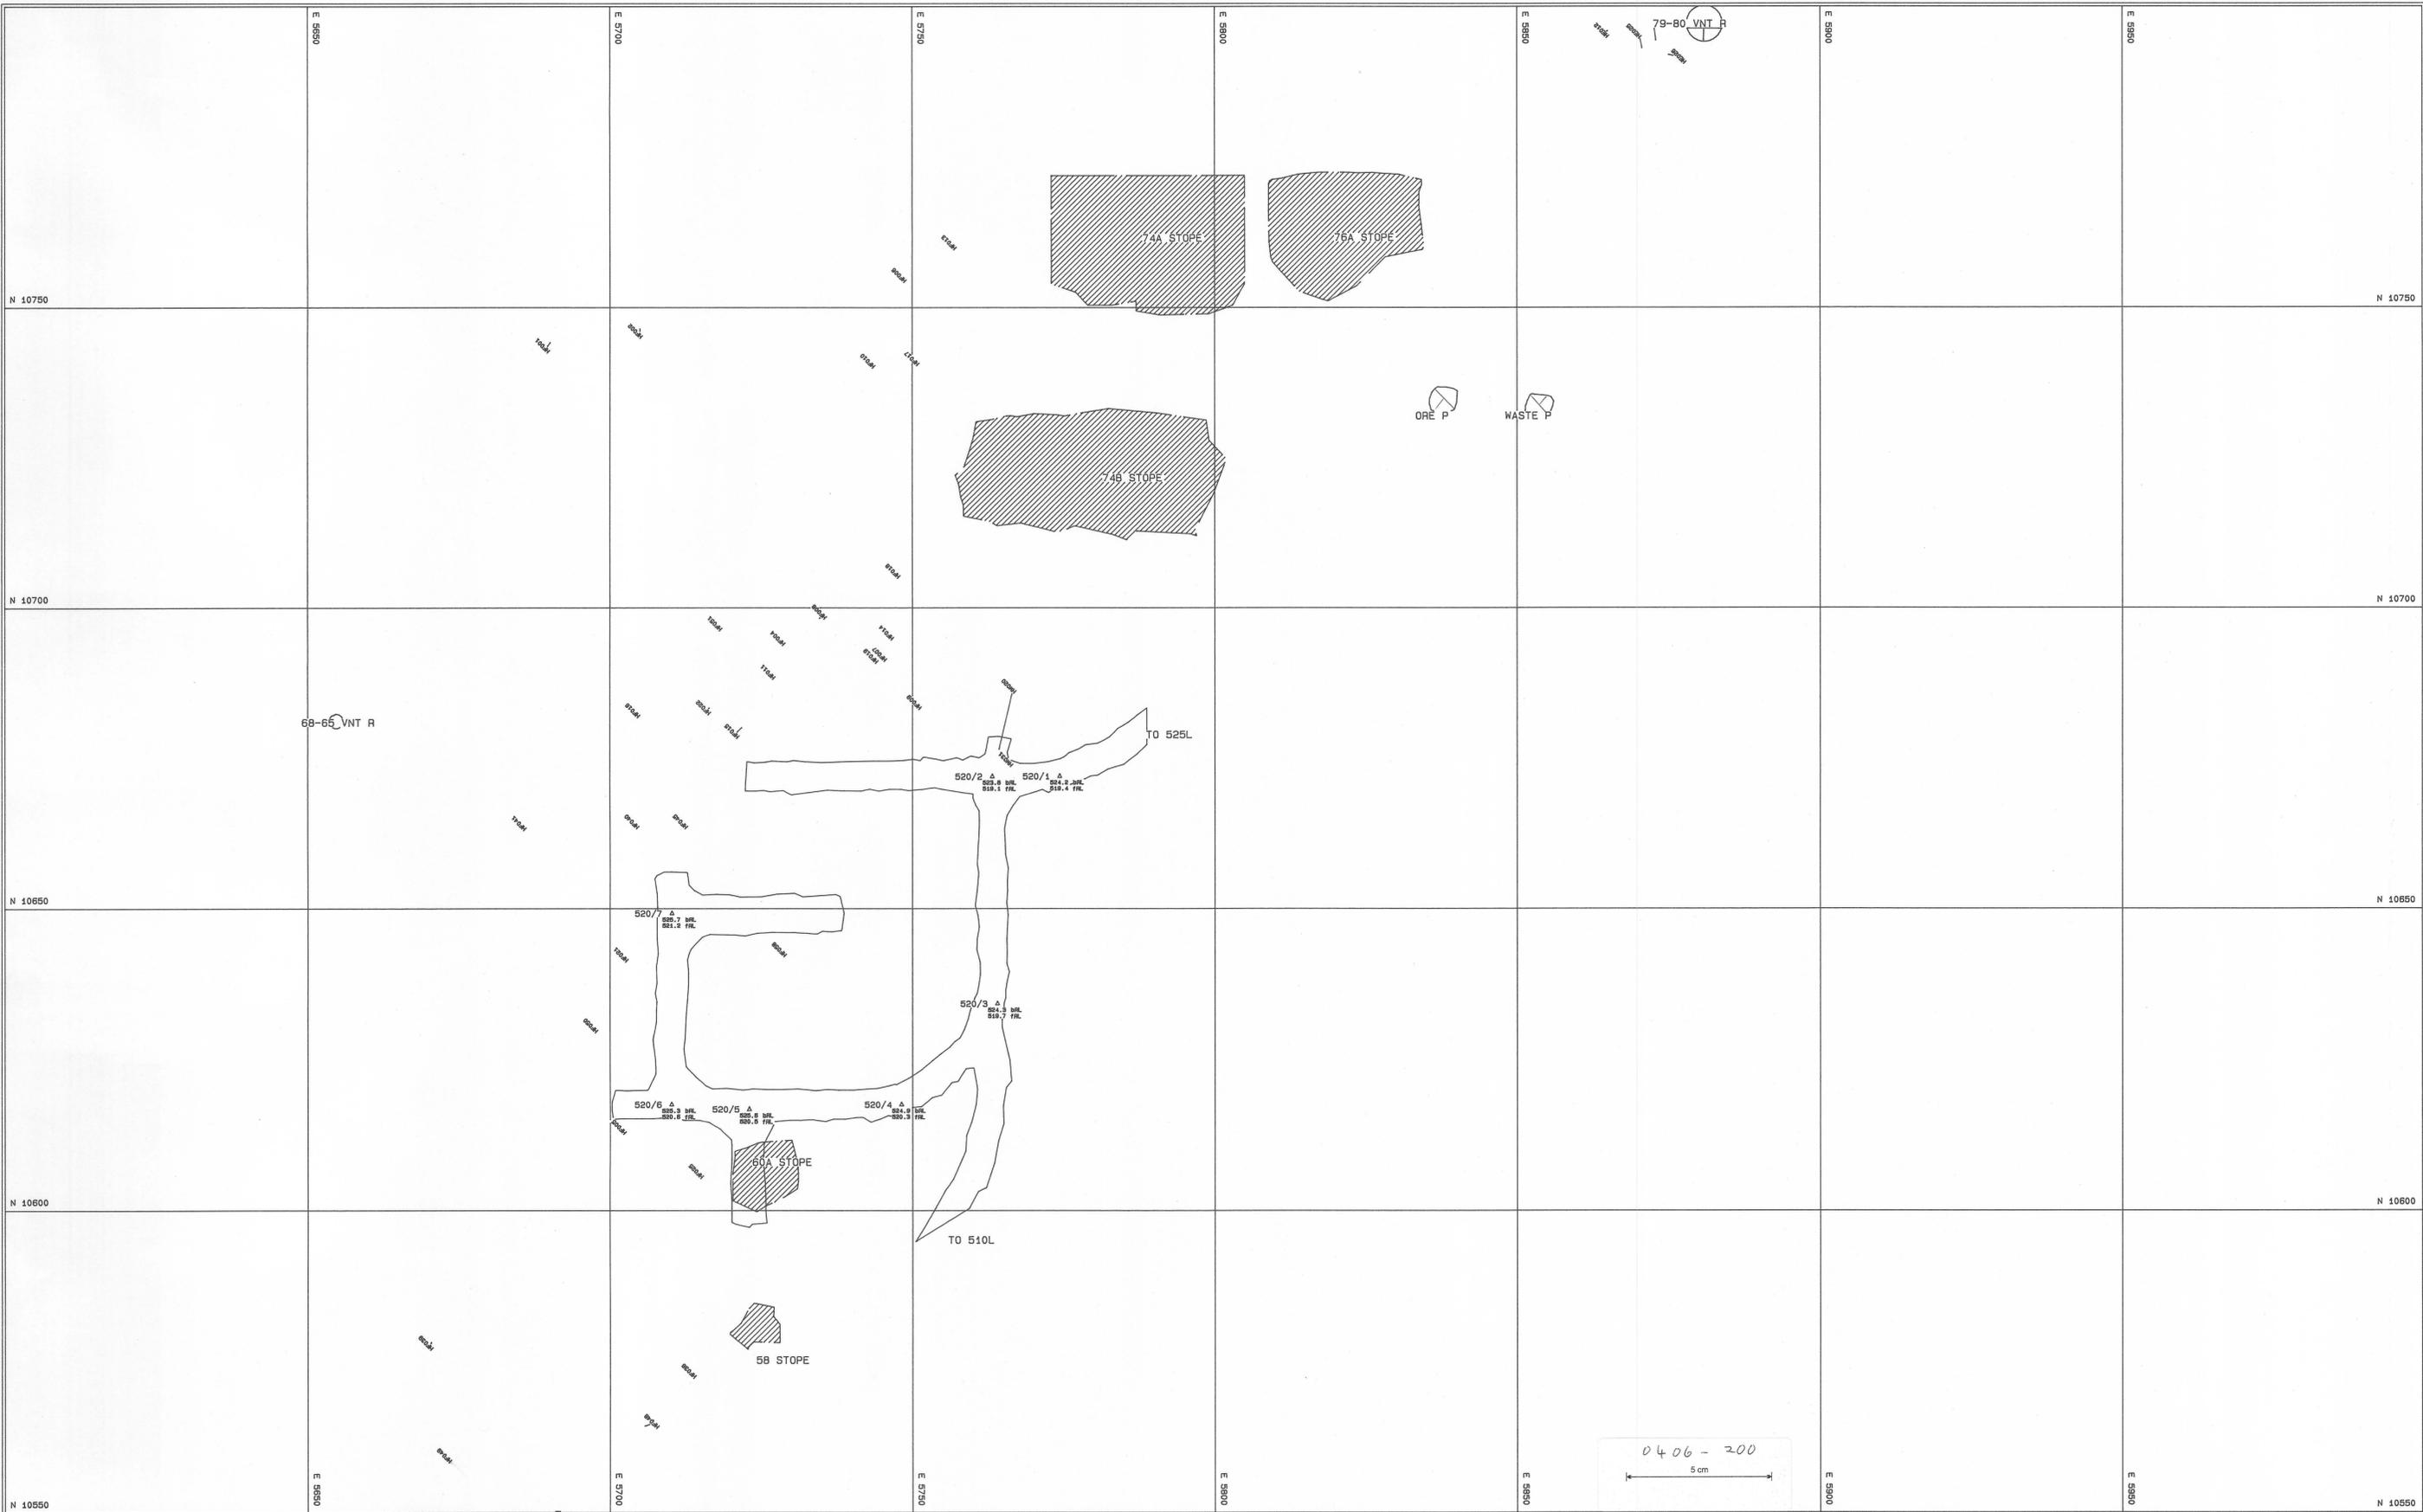

KEY

- HP = PROBE HOLE
- HA = COMP. AIR HOLE
- HV = VENT HOLE
- HE = ELECTRICAL HOLE
- HM = WATER HOLE
- HF = FILL HOLE

REV	DATE	REVISION	DRAWN	CHK	APP	APP



SCALE 1:500

DRAWN	DAS	20-Sep-94
CHECKED	<i>JLS</i>	20-9-94
DESIGNED		
DESIGN CKD.		
DESIGN APP.		
PROJECT APP.		

ABERFOYLE RESOURCES LTD.  
HELLYER DIVISION

HELLYER MINE  
LEVEL PLAN  
HORIZON 520mRL

Drawing No.  
REVISION