


0406-213

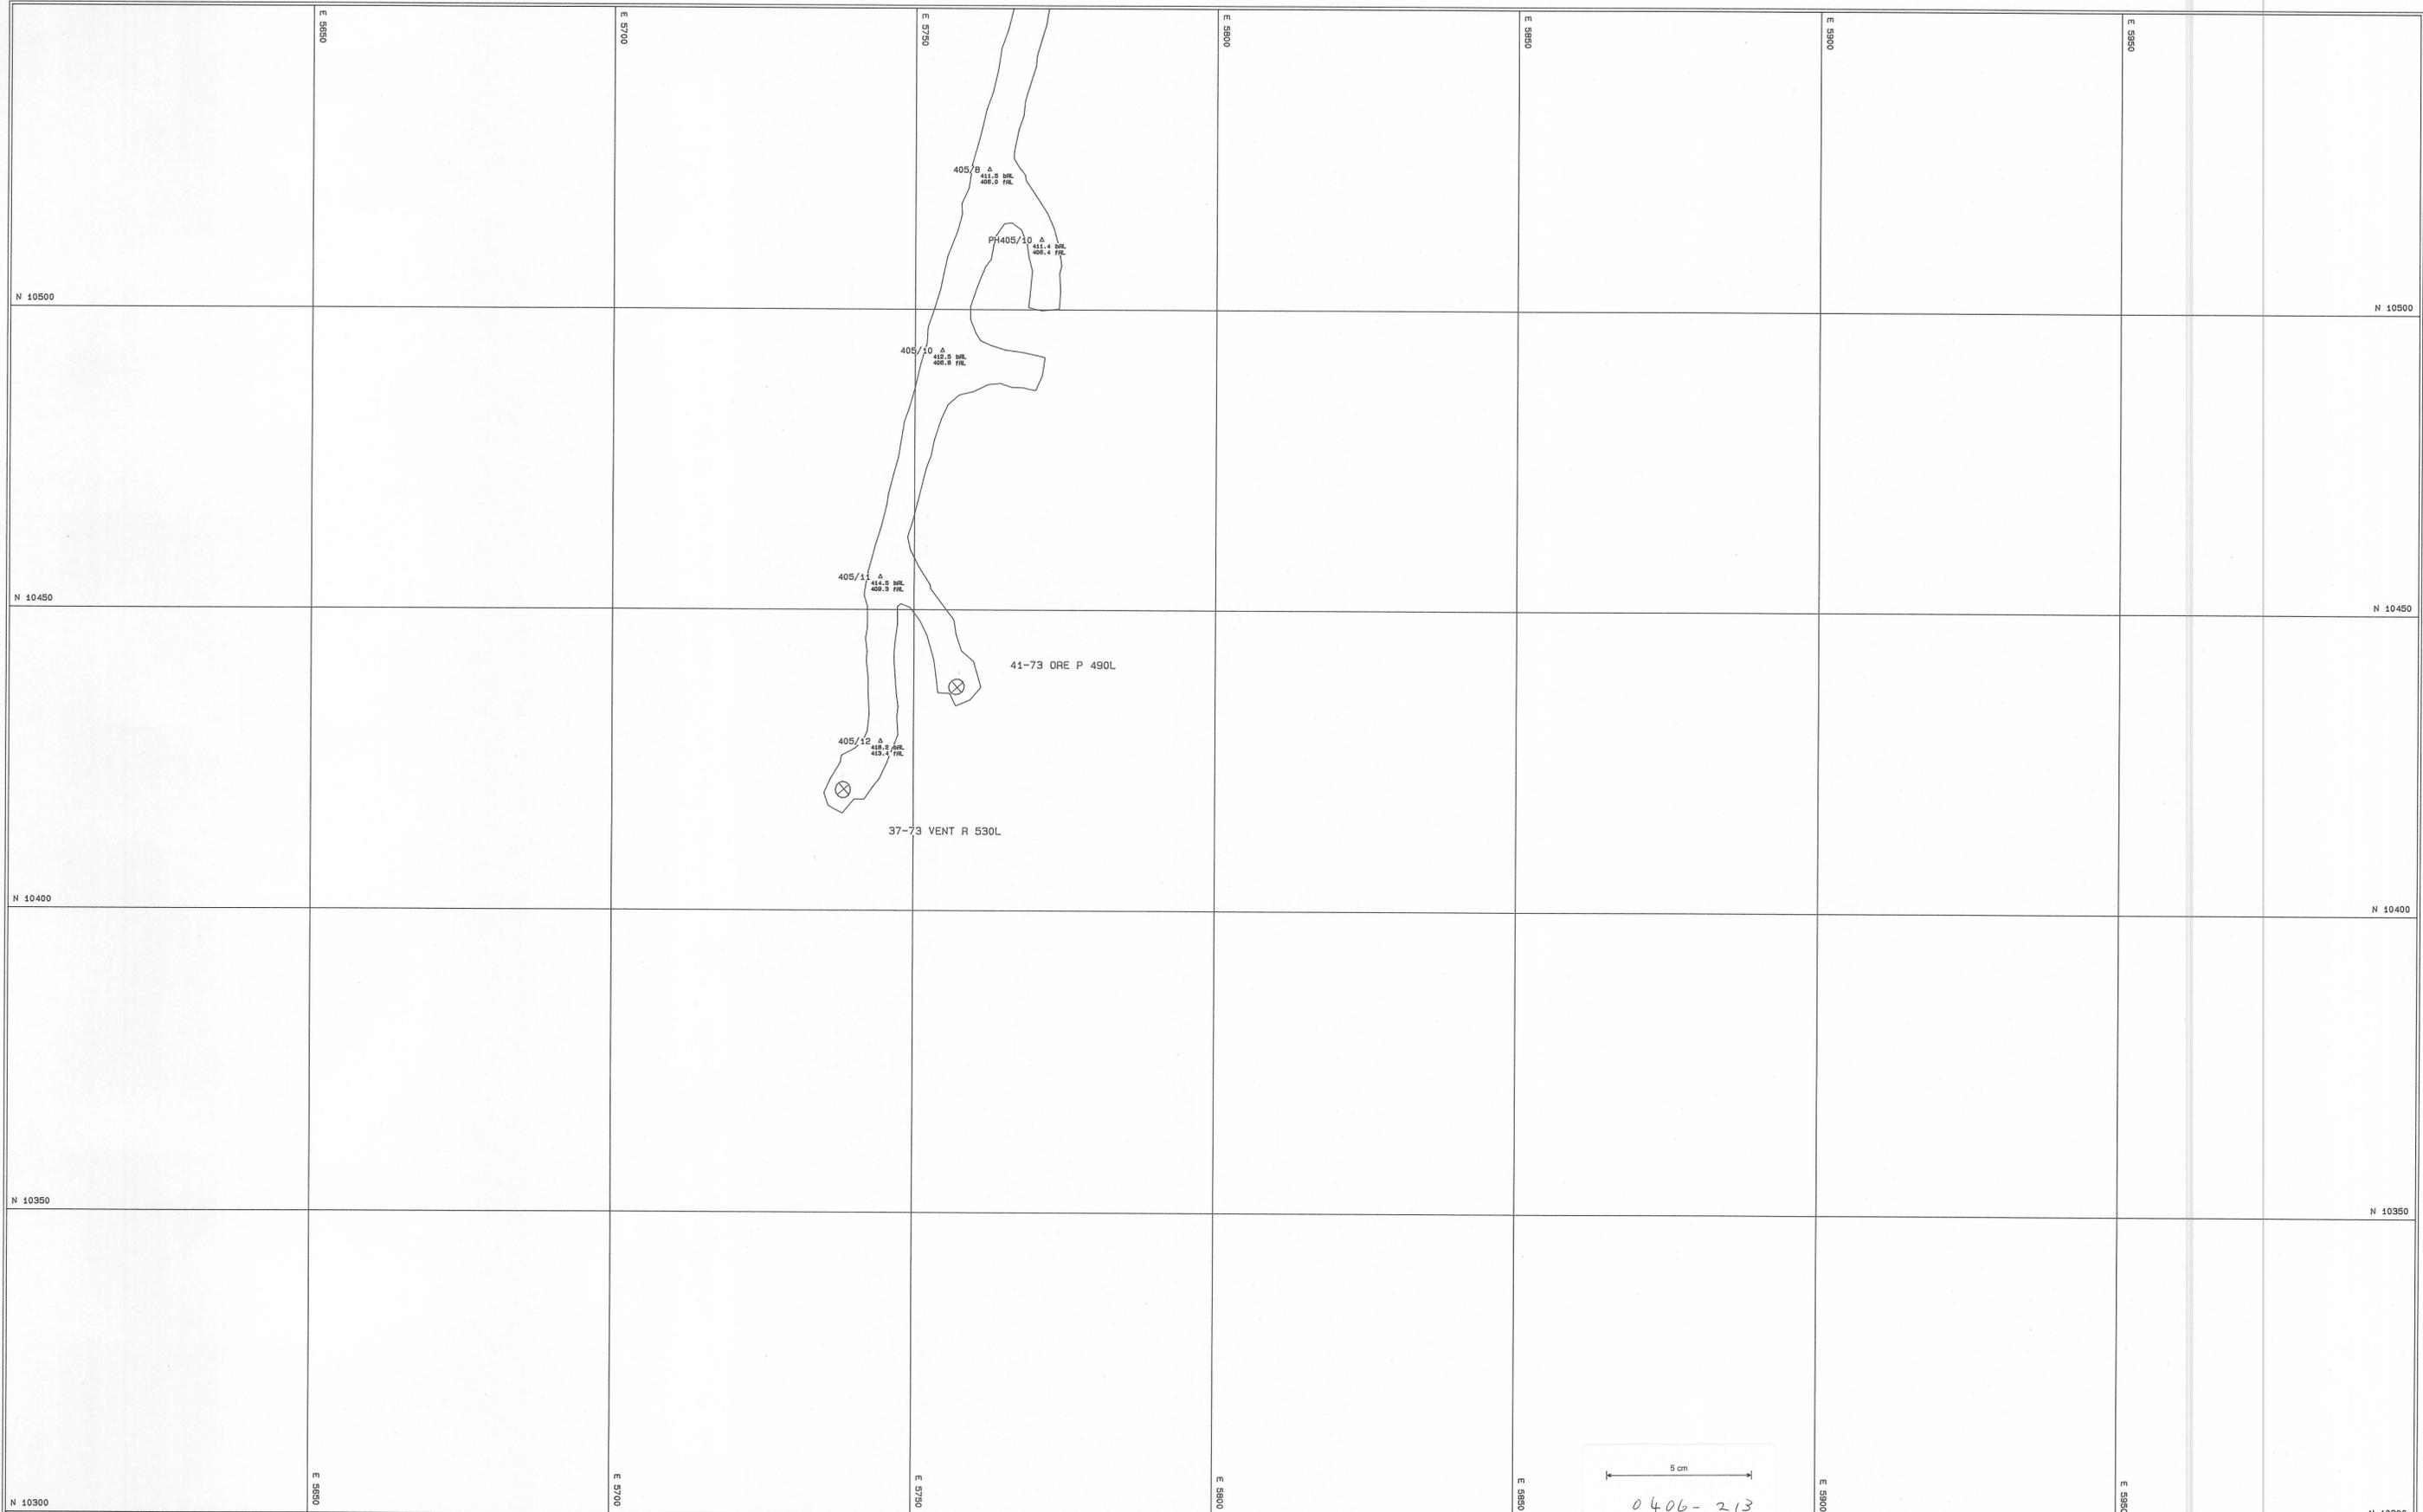

KEY

- HP - PROBE HOLE
- HA - COMP. AIR HOLE
- HV - VENT HOLE
- HE - ELECTRICAL HOLE
- HM - WATER HOLE
- HF - FILL HOLE

REV	DATE	REVISION	DRAMN	CKD	APP	APP



SCALE 1: 500

DRAMN	DAS	20-Sep-94
CHECKED	<i>[Signature]</i>	20-9-94
DESIGNED		
DESIGN CKD.		
DESIGN APP.		
PROJECT APP.		

ABERFOYLE RESOURCES LTD.
HELLYER DIVISION

HELLYER MINE
LEVEL PLAN
HORIZON 405mRL

Drawing No.	
REVISION	