


0406-221



- KEY**
- HP = PROBE HOLE
 - HA = COMP. AIR HOLE
 - HV = VENT HOLE
 - HE = ELECTRICAL HOLE
 - HW = WATER HOLE
 - HF = FILL HOLE

REV	DATE	REVISION	DRAWN	CHK	APP	APP

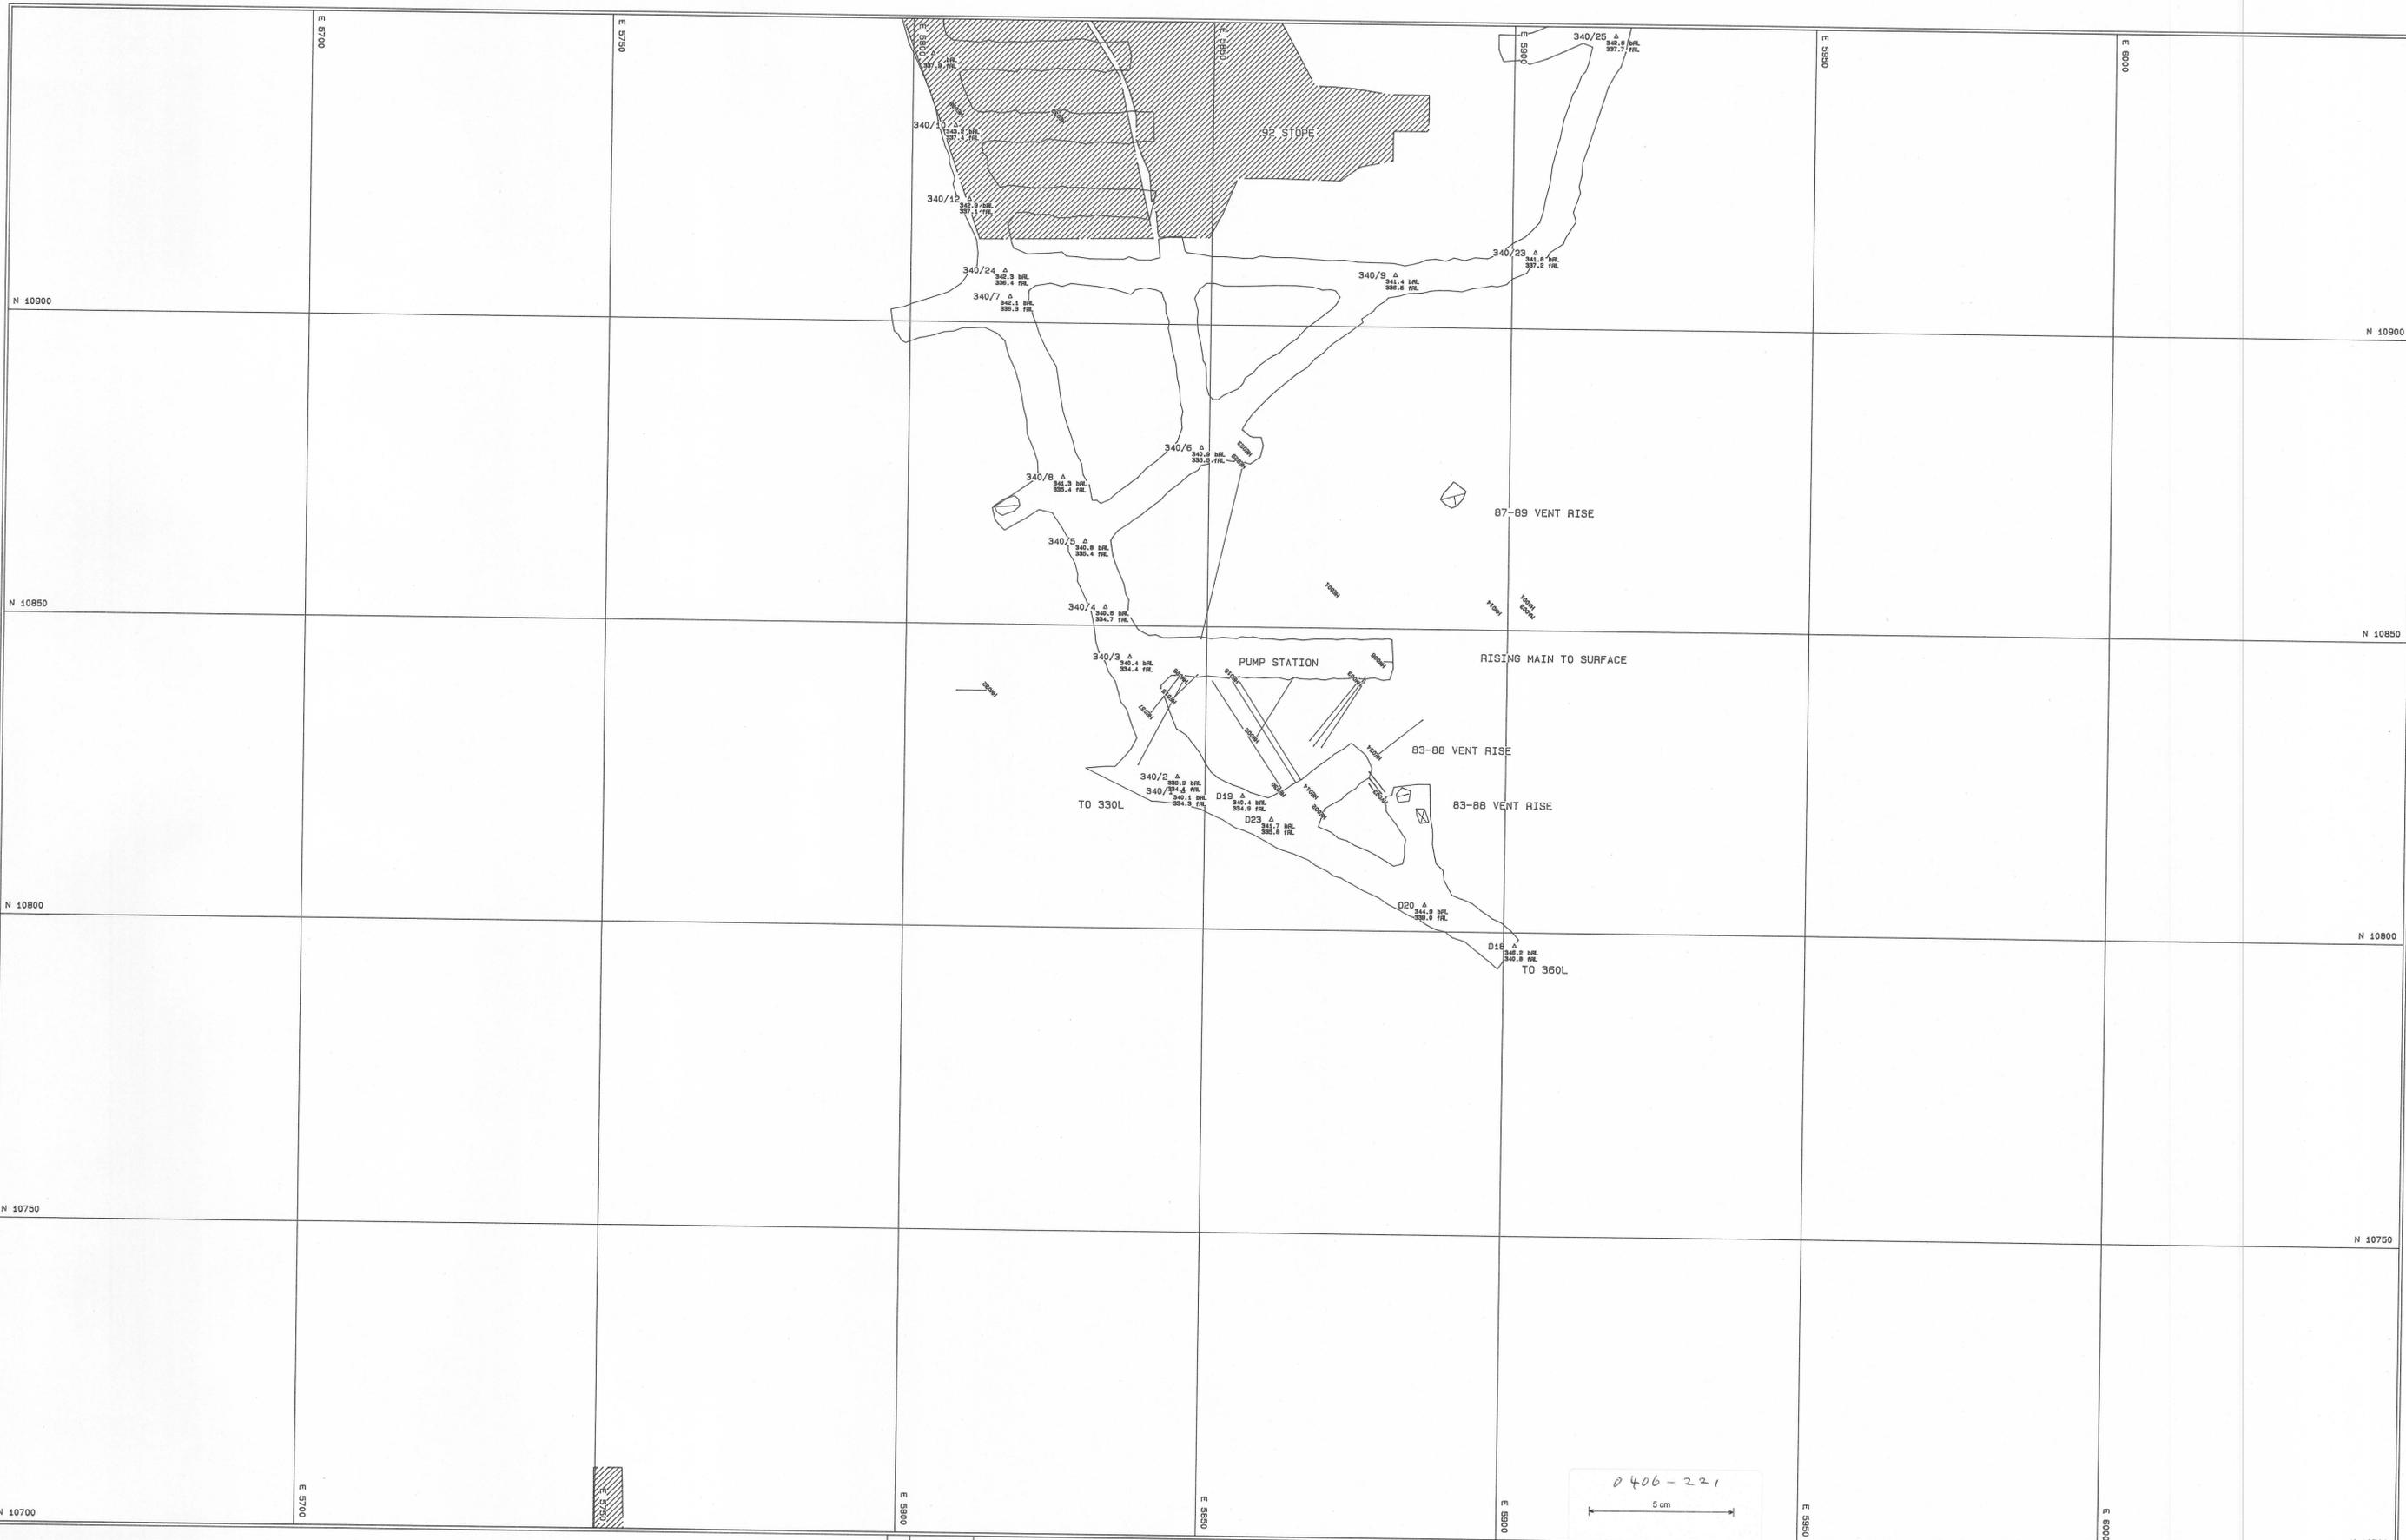

0406-221
5 cm

SCALE 1: 500

DRAWN	DAS	20-Sep-04
CHECKED	JCS	20-9-04
DESIGNED		
DESIGN CKD.		
DESIGN APP.		
PROJECT APP.		

ABERFOYLE RESOURCES LTD.
HELLYER DIVISION

HELLYER MINE
LEVEL PLAN
HORIZON 340mRL

Drawing No.	
REVISION	