


0406-224

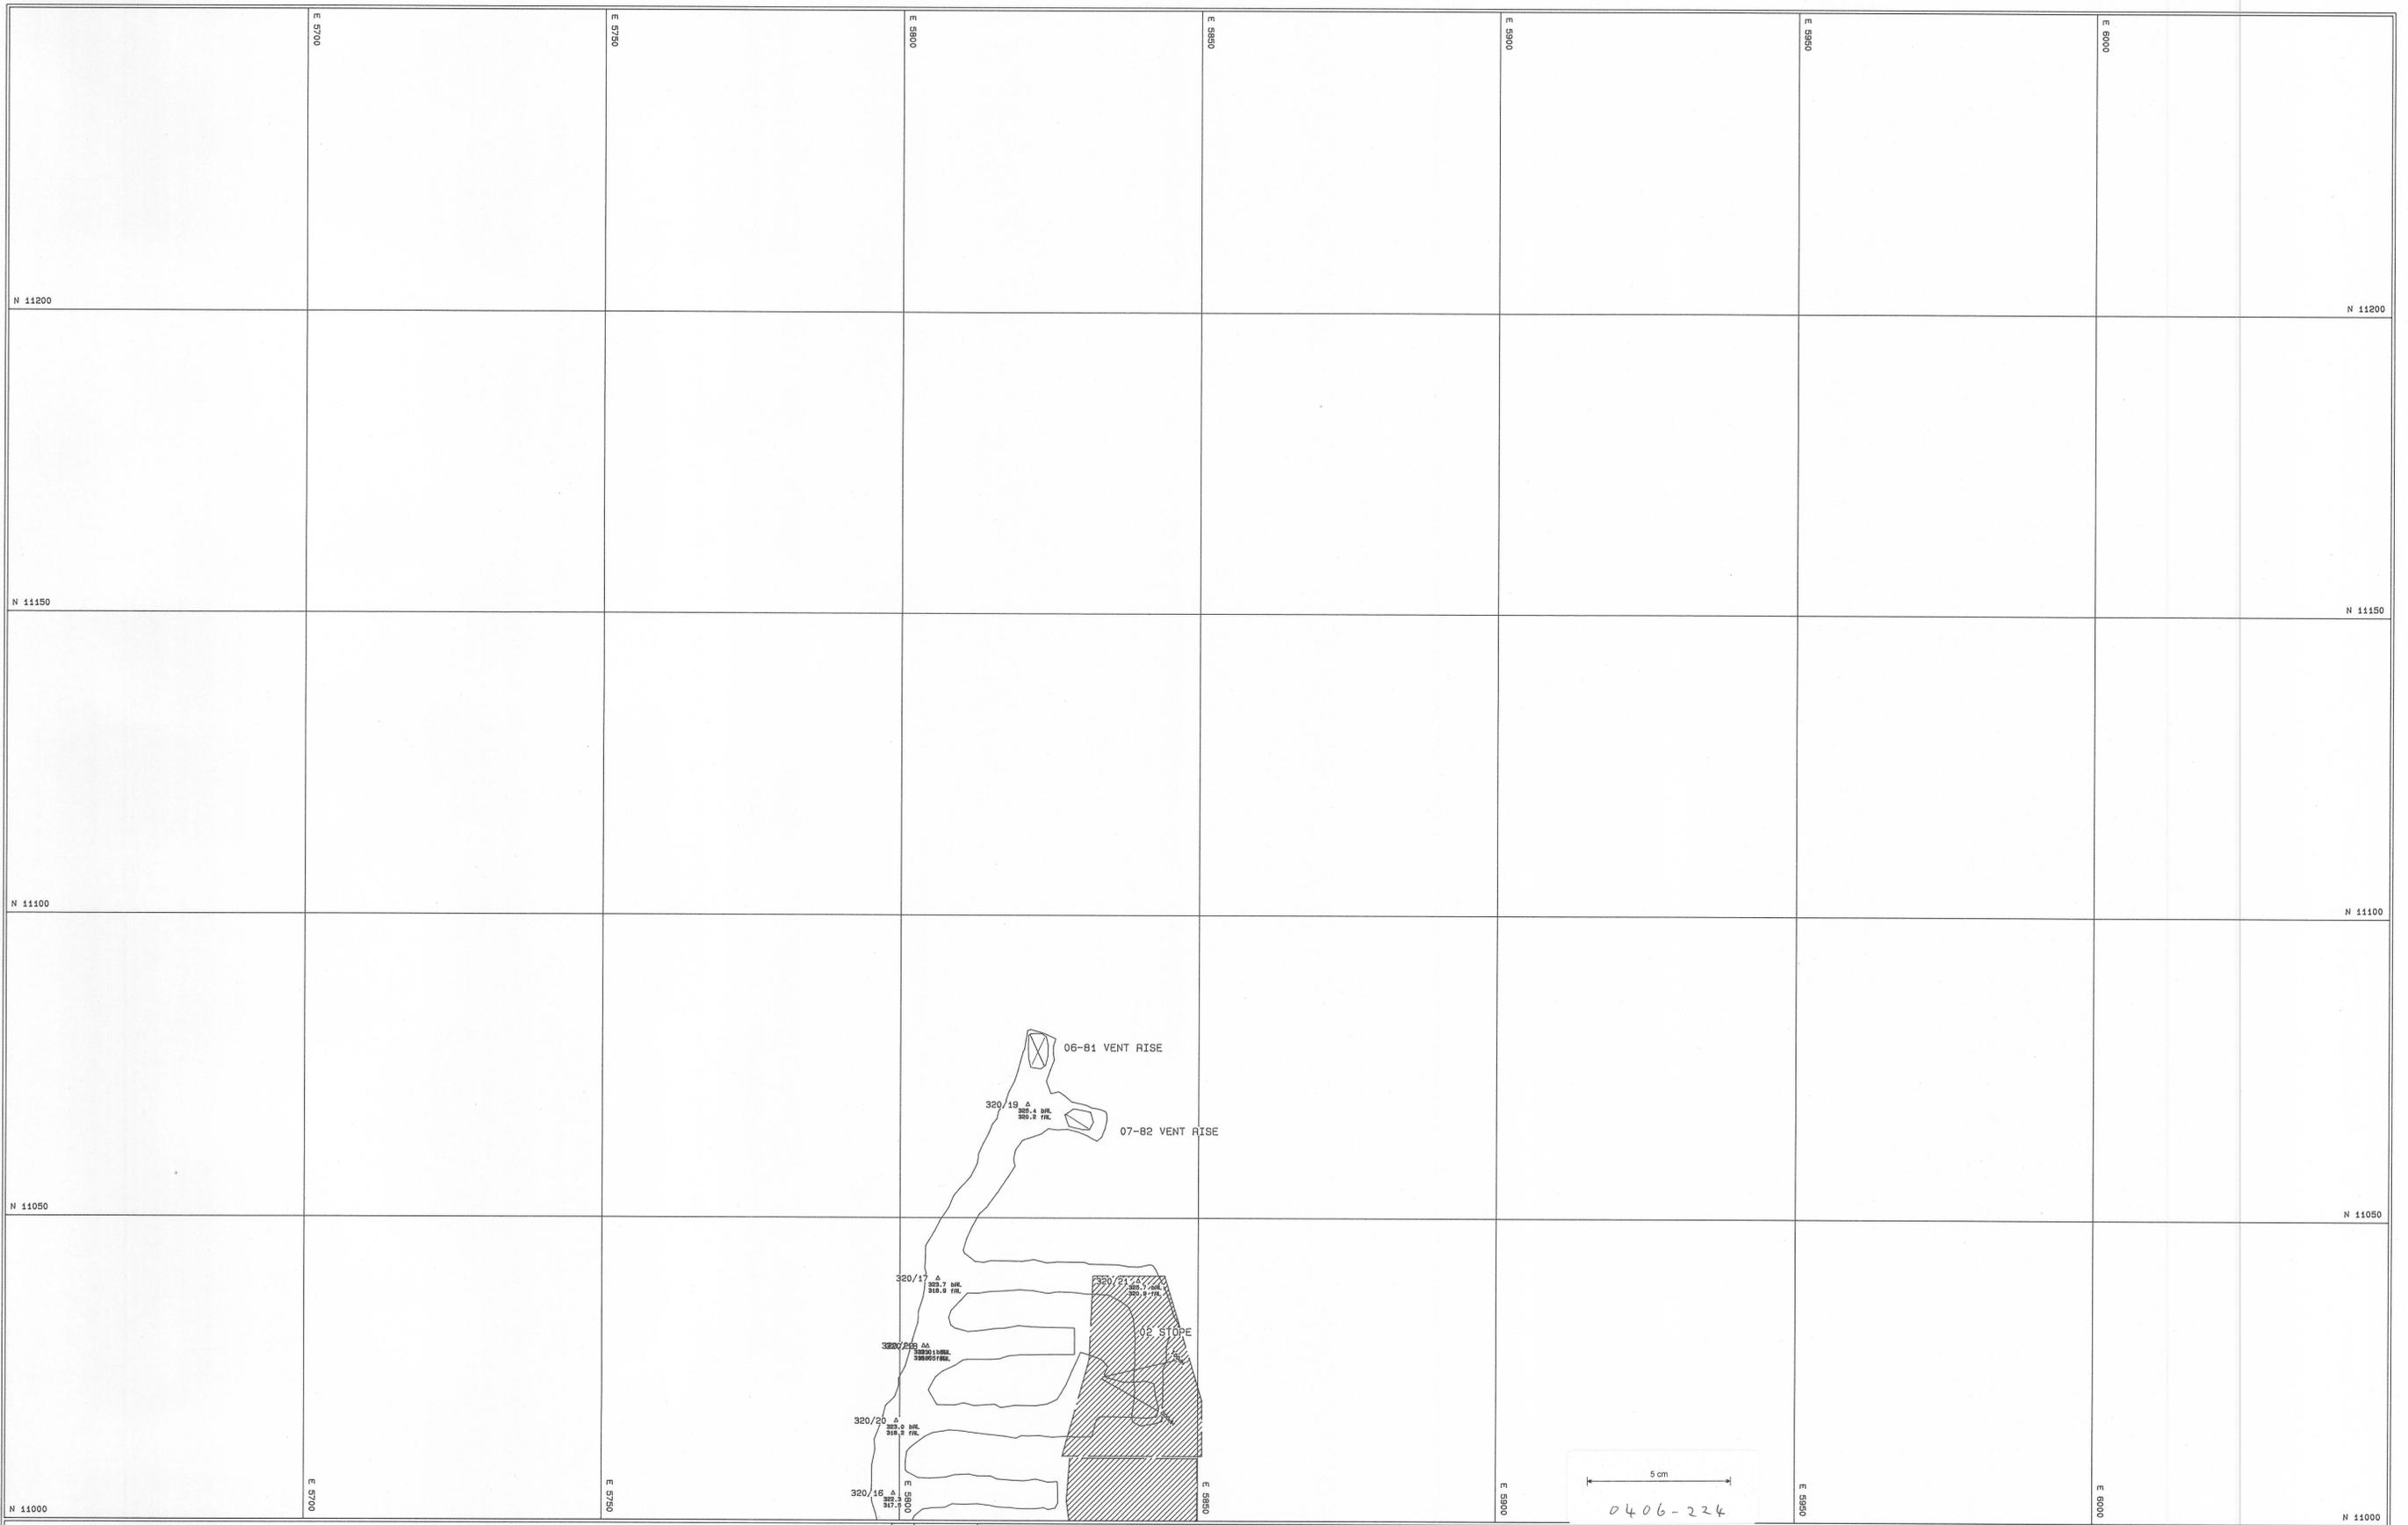

KEY

- HP = PROBE HOLE
- HA = COMP. AIR HOLE
- HV = VENT HOLE
- HE = ELECTRICAL HOLE
- HM = WATER HOLE
- HF = FILL HOLE

REV	DATE	REVISION	DRAWN	CHKD	APP	APP



5 cm  
0406-224

SCALE 1: 500

DRAWN	DAS	20-Sep-94
CHECKED	<i>[Signature]</i>	20-9-94
DESIGNED		
DESIGN CHKD.		
DESIGN APP.		
PROJECT APP.		

ABERFOYLE RESOURCES LTD.  
HELLYER DIVISION

HELLYER MINE  
LEVEL PLAN  
HORIZON 320mRL

Drawing No.  
REVISION