


0406-225

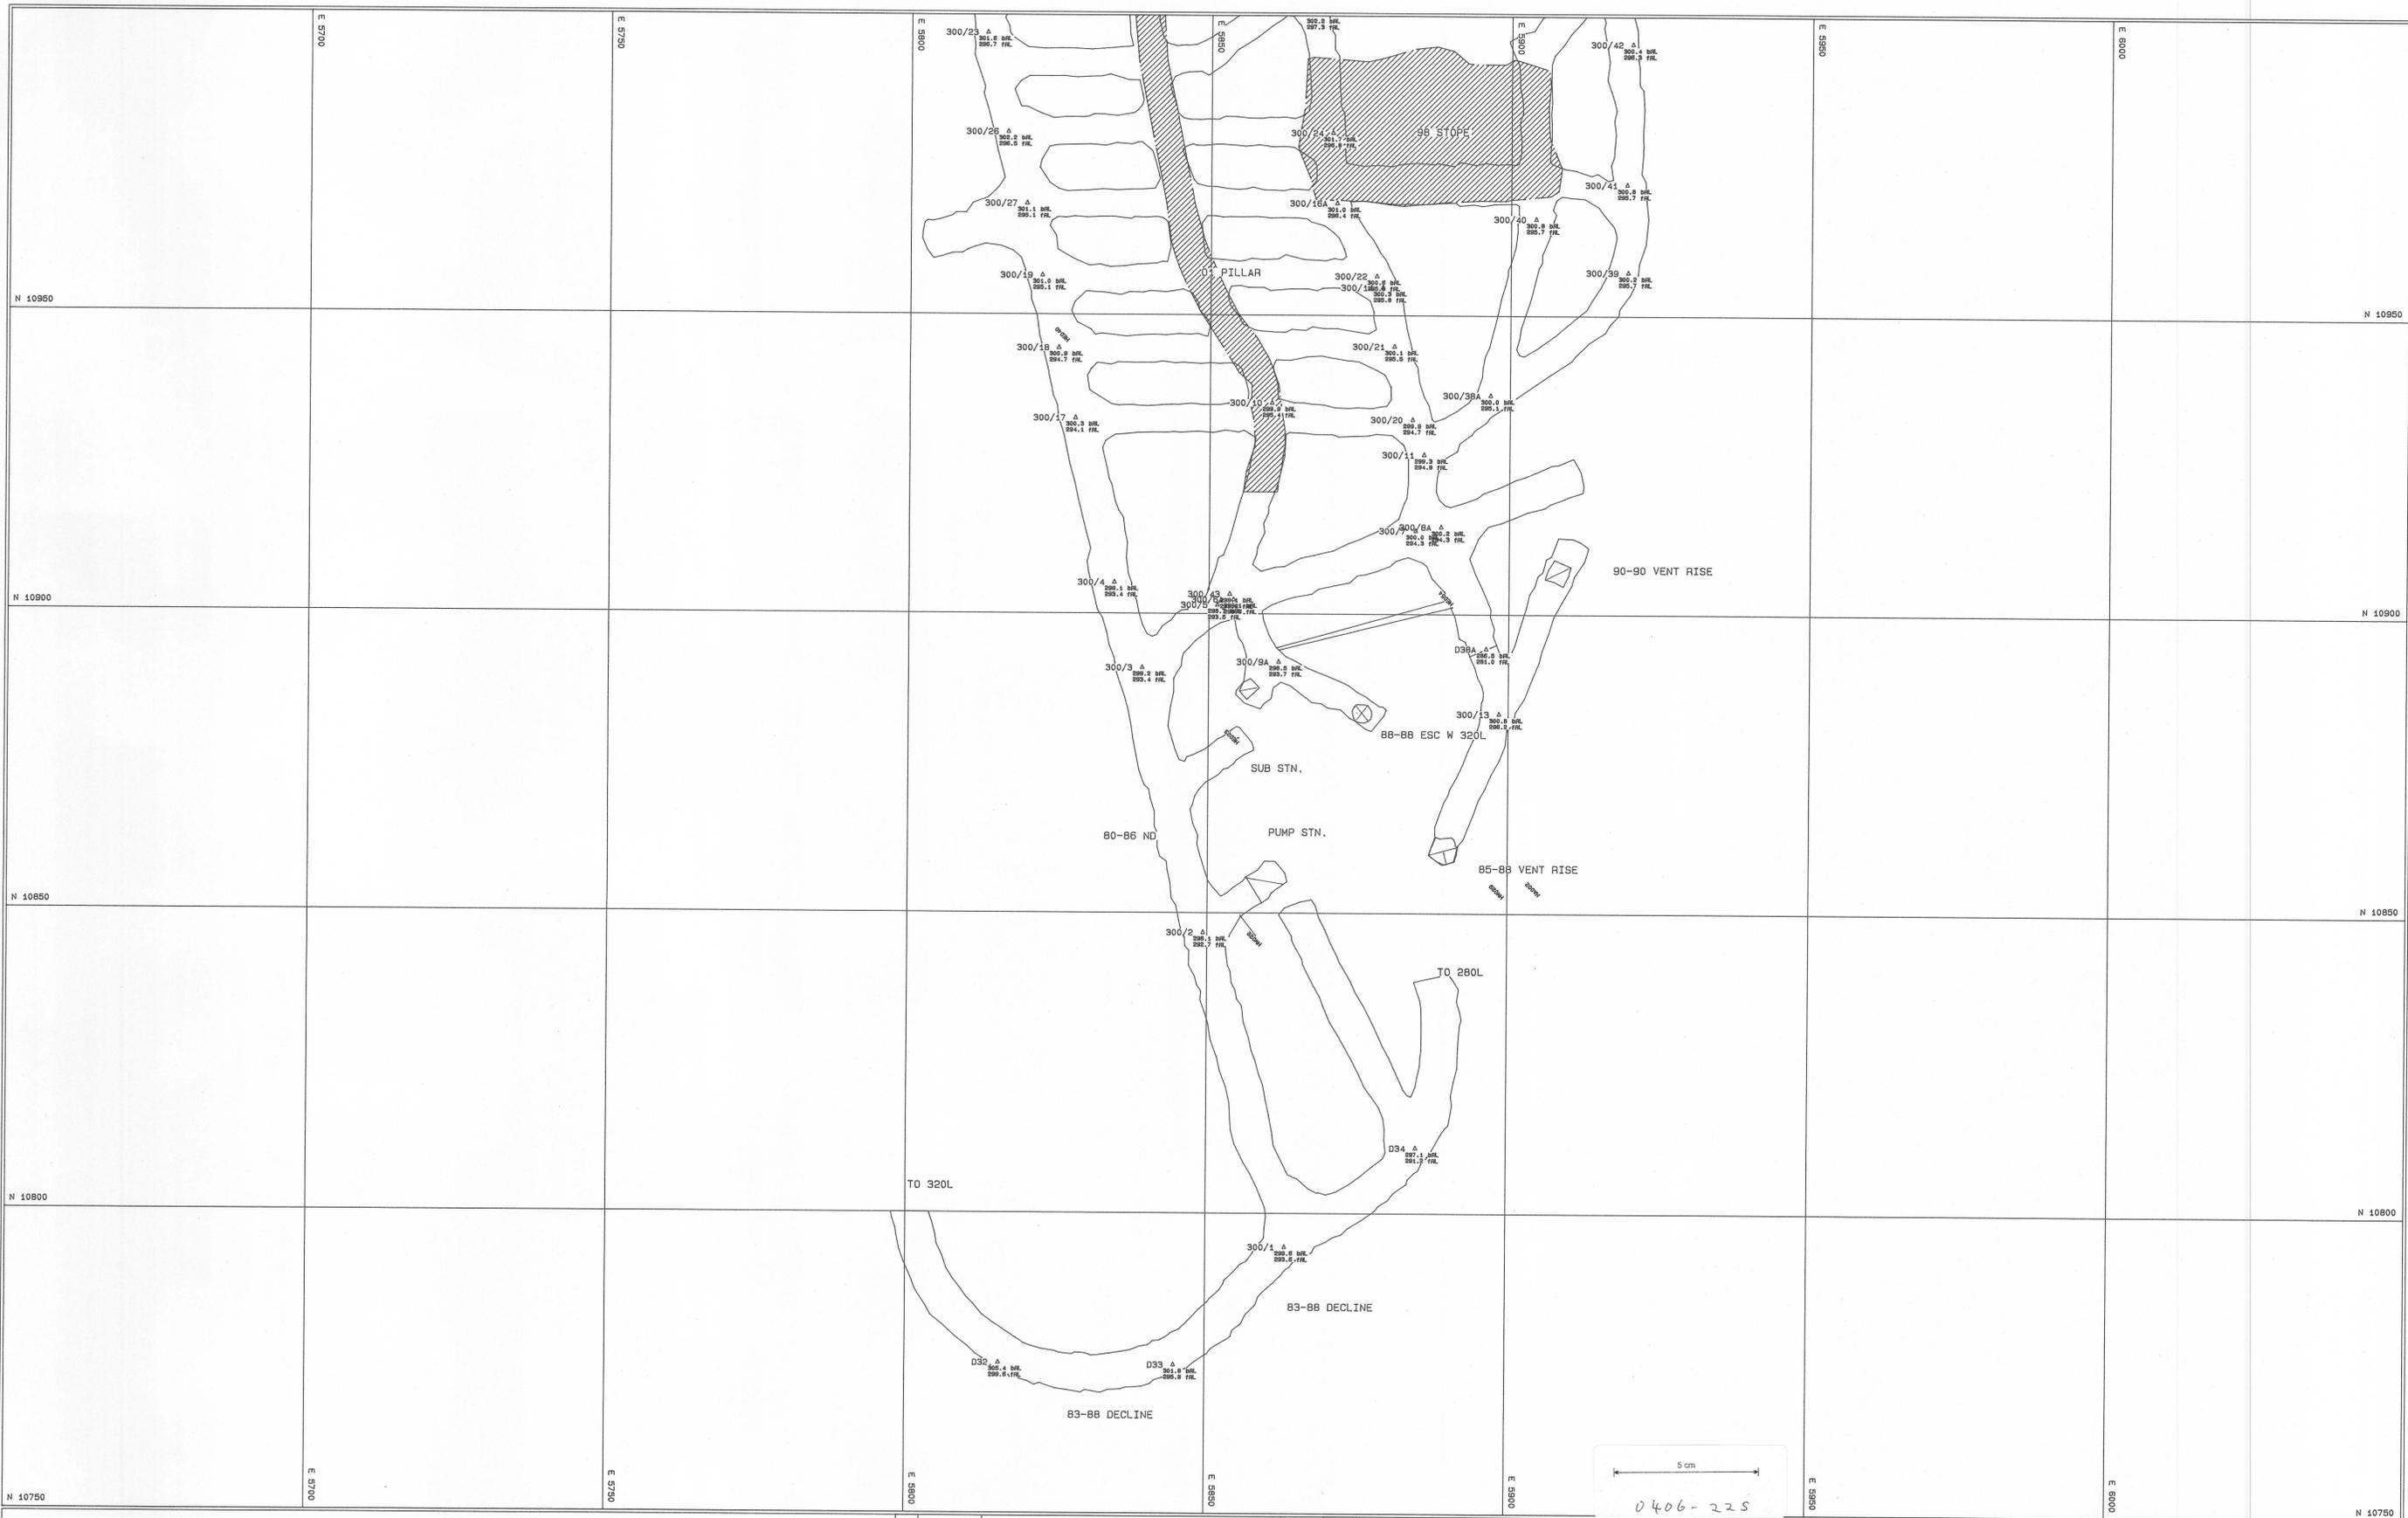

KEY

- HP = PROBE HOLE
- HA = COMP. AIR HOLE
- HV = VENT HOLE
- HE = ELECTRICAL HOLE
- HM = WATER HOLE
- HF = FILL HOLE

REV	DATE	REVISION	DRANN	CKD	APP	APP



5 cm
0406-225

SCALE 1:500

DRANN	DAS	20-Sep-94
CHECKED	YET	20-9-94
DESIGNED		
DESIGN CKD.		
DESIGN APP.		
PROJECT APP.		

ABERFOYLE RESOURCES LTD.
HELLYER DIVISION

HELLYER MINE
LEVEL PLAN
HORIZON 300mRL

Drawing No.	
REVISION	