


0406-227

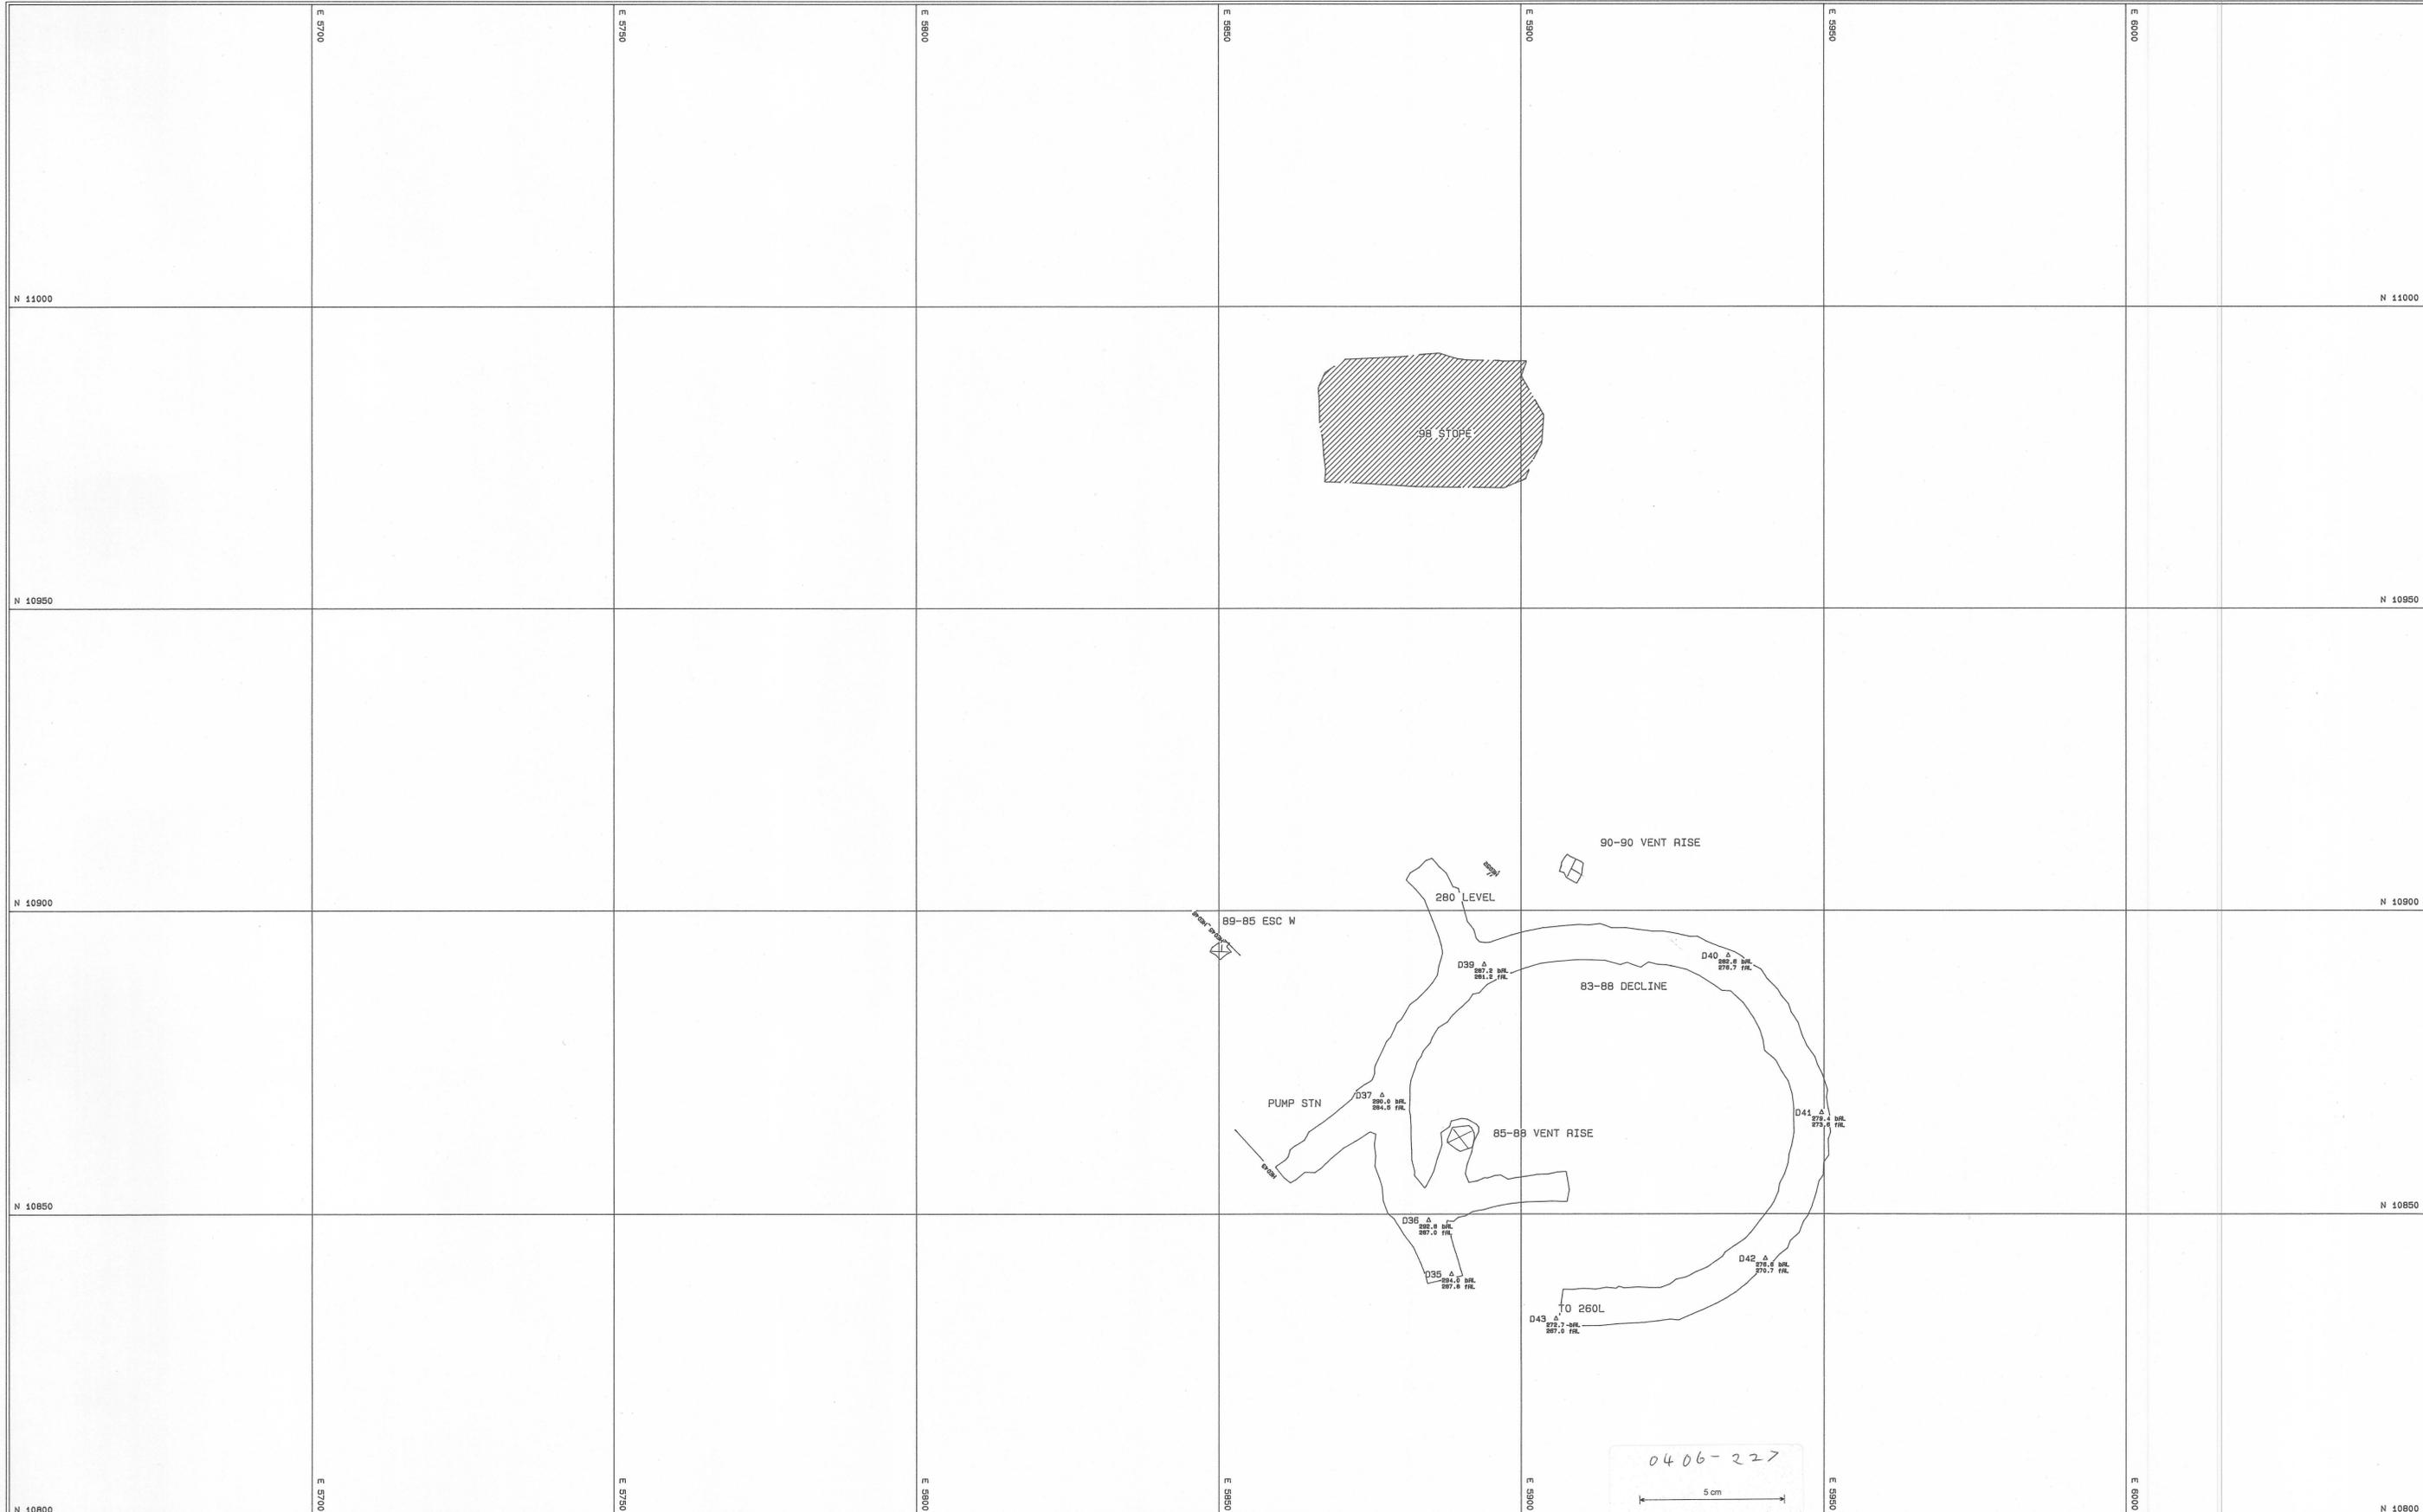

0406-227
5 cm

KEY

- HP = PROBE HOLE
- HA = COMP. AIR HOLE
- HV = VENT HOLE
- HE = ELECTRICAL HOLE
- HM = WATER HOLE
- HF = FILL HOLE

REV	DATE	REVISION	DRAWN	CHKD	APP	APP



SCALE 1: 500

DRAWN	DAS	20-Sep-94
CHECKED	<i>[Signature]</i>	20-9-94
DESIGNED		
DESIGN OKD.		
DESIGN APP.		
PROJECT APP.		

ABERFOYLE RESOURCES LTD.
HELLYER DIVISION

HELLYER MINE
LEVEL PLAN
HORIZON 280mRL

Drawing No. _____
REVISION _____