




0406-237

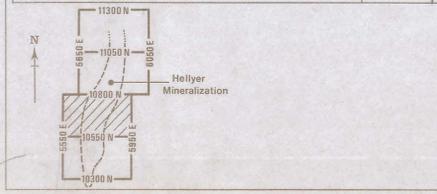

REV	DATE	REVISION	DRAWN	CKD	APP	DIGIT DATE	REV	DATE	REVISION	DRAWN	CKD	APP	DIGIT DATE
2	23.12.98	ADD H&MO (990L TO 400L) HP 027	WJS				12/10/90	Added 73-83 Dip Pass 450L - 400L	GM	MS	MB		
		ADD 80-83 NO 86P MCL	RM				25.8.87	Geology @ 410 RL	MF				
							12.8.87	INCLINE EXTENDED	AJW				
							7.10.87	RISE ADDED	AJW				
							3.11.87	DDM LOCATIONS @ 400L	MF				
							26.9.89	ACTUAL DEVELOPMENT UPDATED	AW				
							2.12.95	Geology @ 440 RL	PC				

SCALE	1:500	Sheet No.	1080-595
DRAWN	AJW	DATE	14-1-87
CHECKED			
DESIGNED			
DESIGN CKD			
DESIGN APP			
PROJECT APP			



Aberfoyle Resources Limited
HELLYER DIVISION

DEVELOPMENT DESIGN
440 LEVEL - 2

DRAWING NO. 5

5 cm