


0406-257

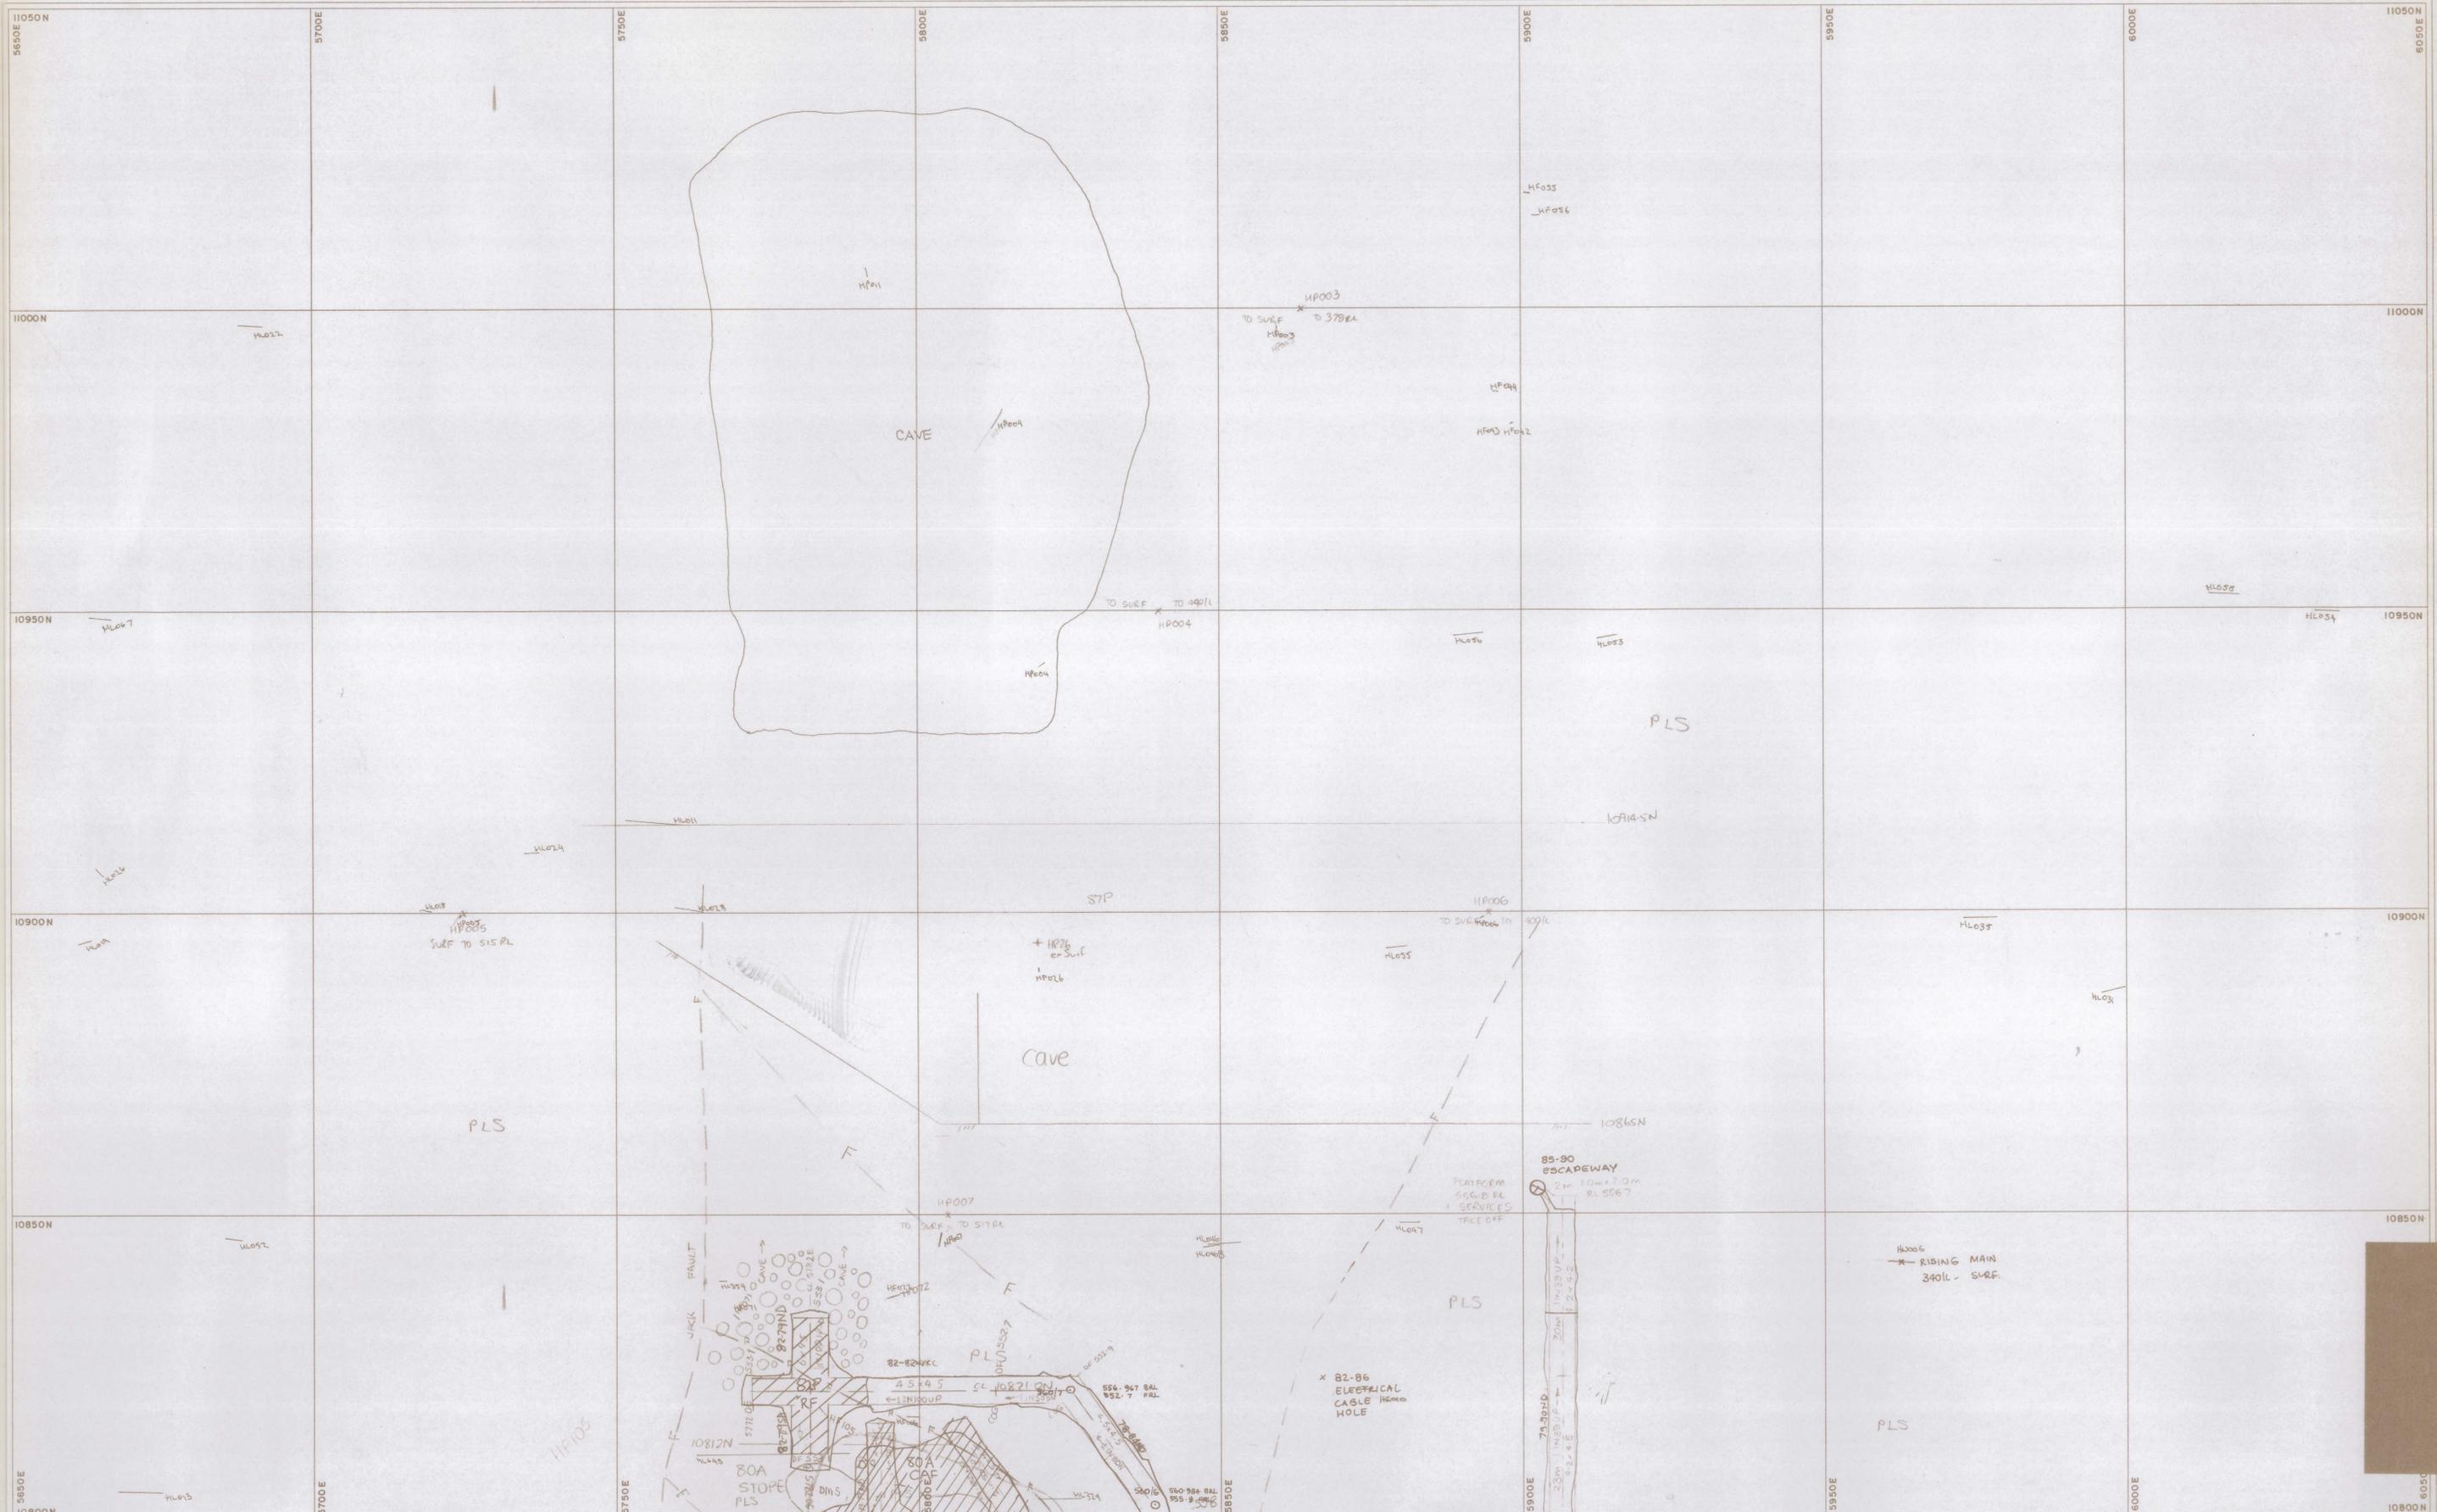

REV	DATE	REVISION	DRAWN	CKD	APP	DIGIT DATE	REV	DATE	REVISION	DRAWN	CKD	APP	DIGIT DATE
5	1-12-97	ADDED 82-82 WXC, 82-78 MD	KOP	TLM			1	27/2/98	78-80ND	AIN	GEM	HJB	
9	29-1-98	CHANGE SIZE 82-82WXC, 82-78NDSD	TLM	JSH	WIN	30048	2	14/7/98	Geology updated	RED			
10	20-3-98	CHANGED GRADE 82-82 WXC 560L	RWJ	TLM	WIN	45045	3	23/9/98	HP003, HP004, HP005, HP006 & HP007 ADDED	AIN	WIN	HJB	
							4	30/3/99	Added HP26	SEN	WIN	HJB	29/9/99
							5	5/2/96	77-79ND, 77-82ND, 78-84ND ADDED	DSG	WIN	HJB	
							6	11-11-97	CHANGE 78-84ND, ADD 81-81W, 81-78N, 81-78S 82P	TLM	DSG	WIN	22/1/99
							7	1-12-97	REMOVED 81-81 WXC, 81-78ND, MODIFIED 78-84ND	KPP	WIN	HJB	02/2/99

SCALE 1:500

SHEET No. 1105-605

Aberfoyle Resources Limited  
HELLYER DIVISION

DEVELOPMENT DESIGN

560 LEVEL - 1

DRAWING No.

