
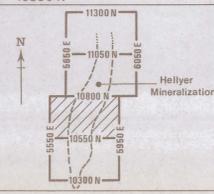


0406-259

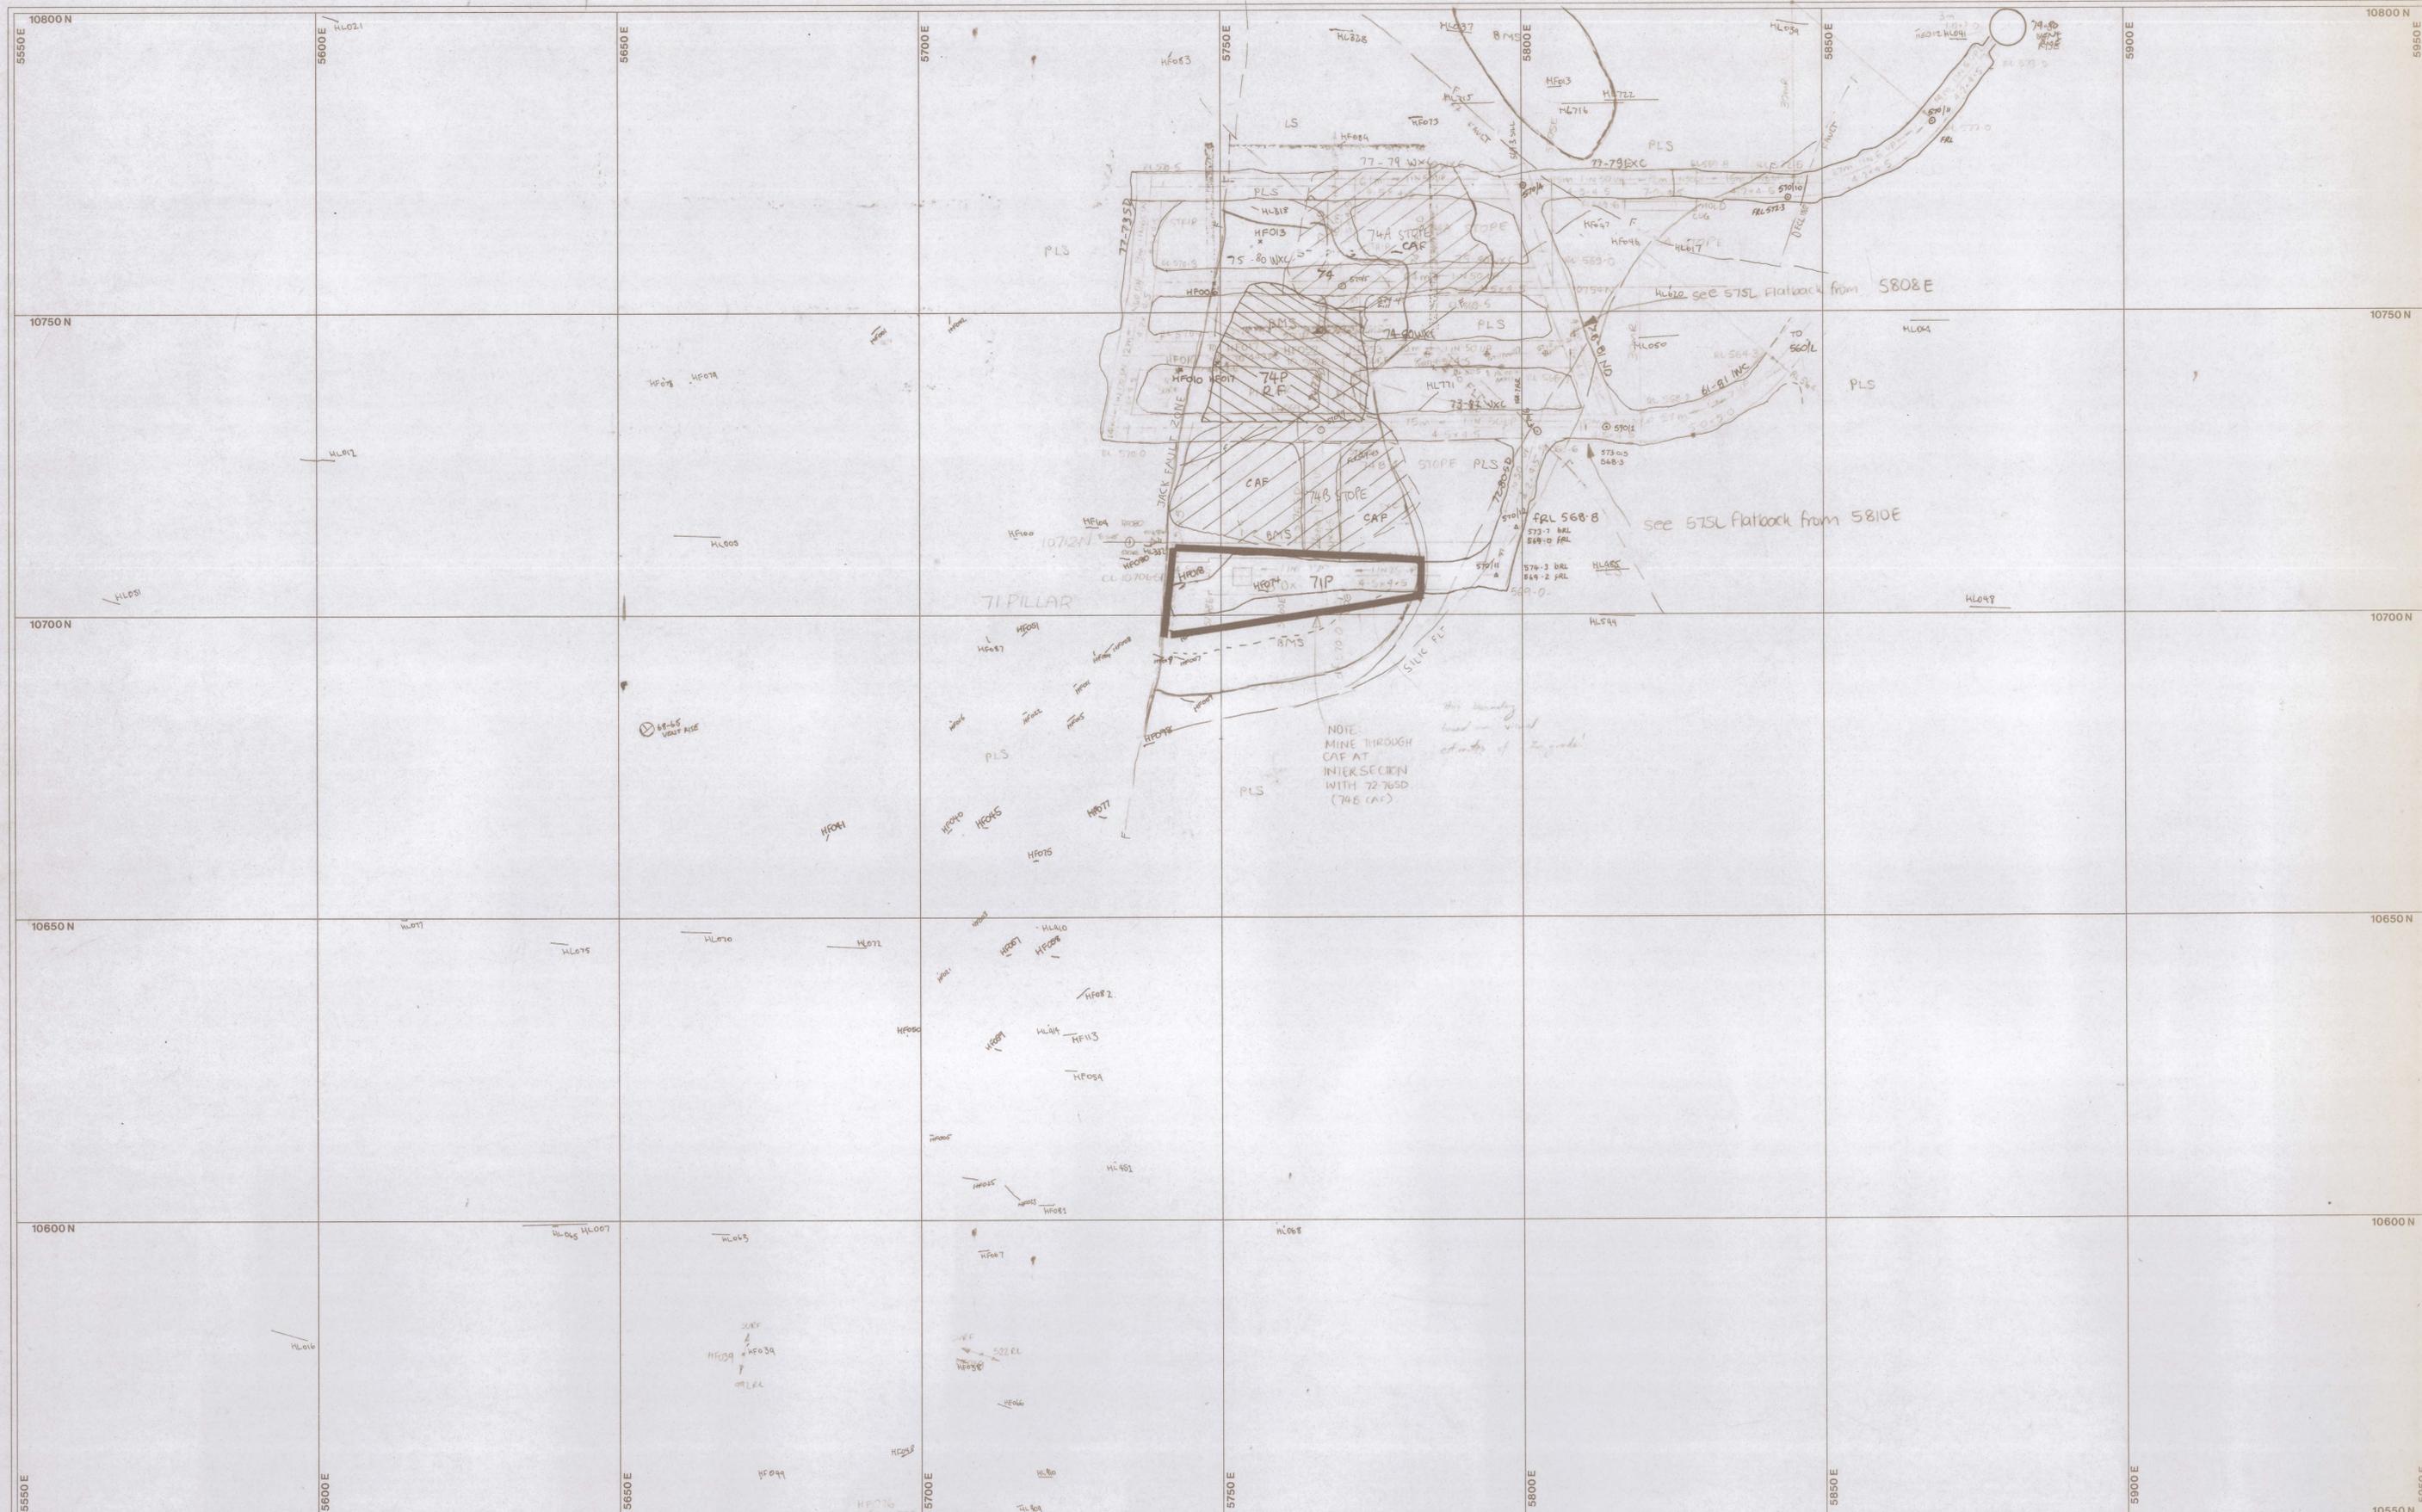

REV	DATE	REVISION	DRAWN	CKD	APP	DIGIT DATE	REV	DATE	REVISION	DRAWN	CKD	APP	DIGIT DATE
16	21/1/93	HFO80 & HFO81 ADDED	AJW	ML			21	20/2/96	GEOLOGY UPDATED	AMM	JF		
17	6/4/93	HFO82 & HFO83 ADDED	AJW	ML			23	4/12/96	DELETED 70-75ND&SD, CHANGED TO 79WXC	TUM	VTO		
18	26/5/94	HFO84 & HFO85 ADDED	AJW	ML			15	30/1/95	HFO86 & HFO89 ADDED	AJW	ML		
22	22/8/96	HFO80 ADDED	JMH	DJA			4	25/2/92	HFO16 ADDED	AMM	ML		
13	4/12/92	72-73SD & 72-73ND DEL., 75-77SD, 77-79SD ADD	AJW	ML			12	14/10/93	HFO87 & HFO88 ADDED	AJW	ML		
10	4/1/92	77-79WXC, 77-79EXC, 78-80WXC, 78-80EXC, 79-80WXC, 79-80EXC	AJW	ML			19	17/1/95	72-80SD EXTENDED & 72-79WXC, 72-79ND, 72-75SD ADD	AJW	ML		
		77-79WXC EXTENDED, 77-73SD ADDED, 78-79ND	ML				11	20/1/92	HFO85 ADDED	AJW	ML		

SCALE 1:500

Sheet No. 1080-595

Aberfoyle Resources Limited
HELLYER DIVISION

PROJECT: DEVELOPMENT DESIGN

DRAWING NO. 570 LEVEL

5 cm

NORTH

70 16/2/96 FLATBACK TO 575L, SEE 570/L