


0406-269

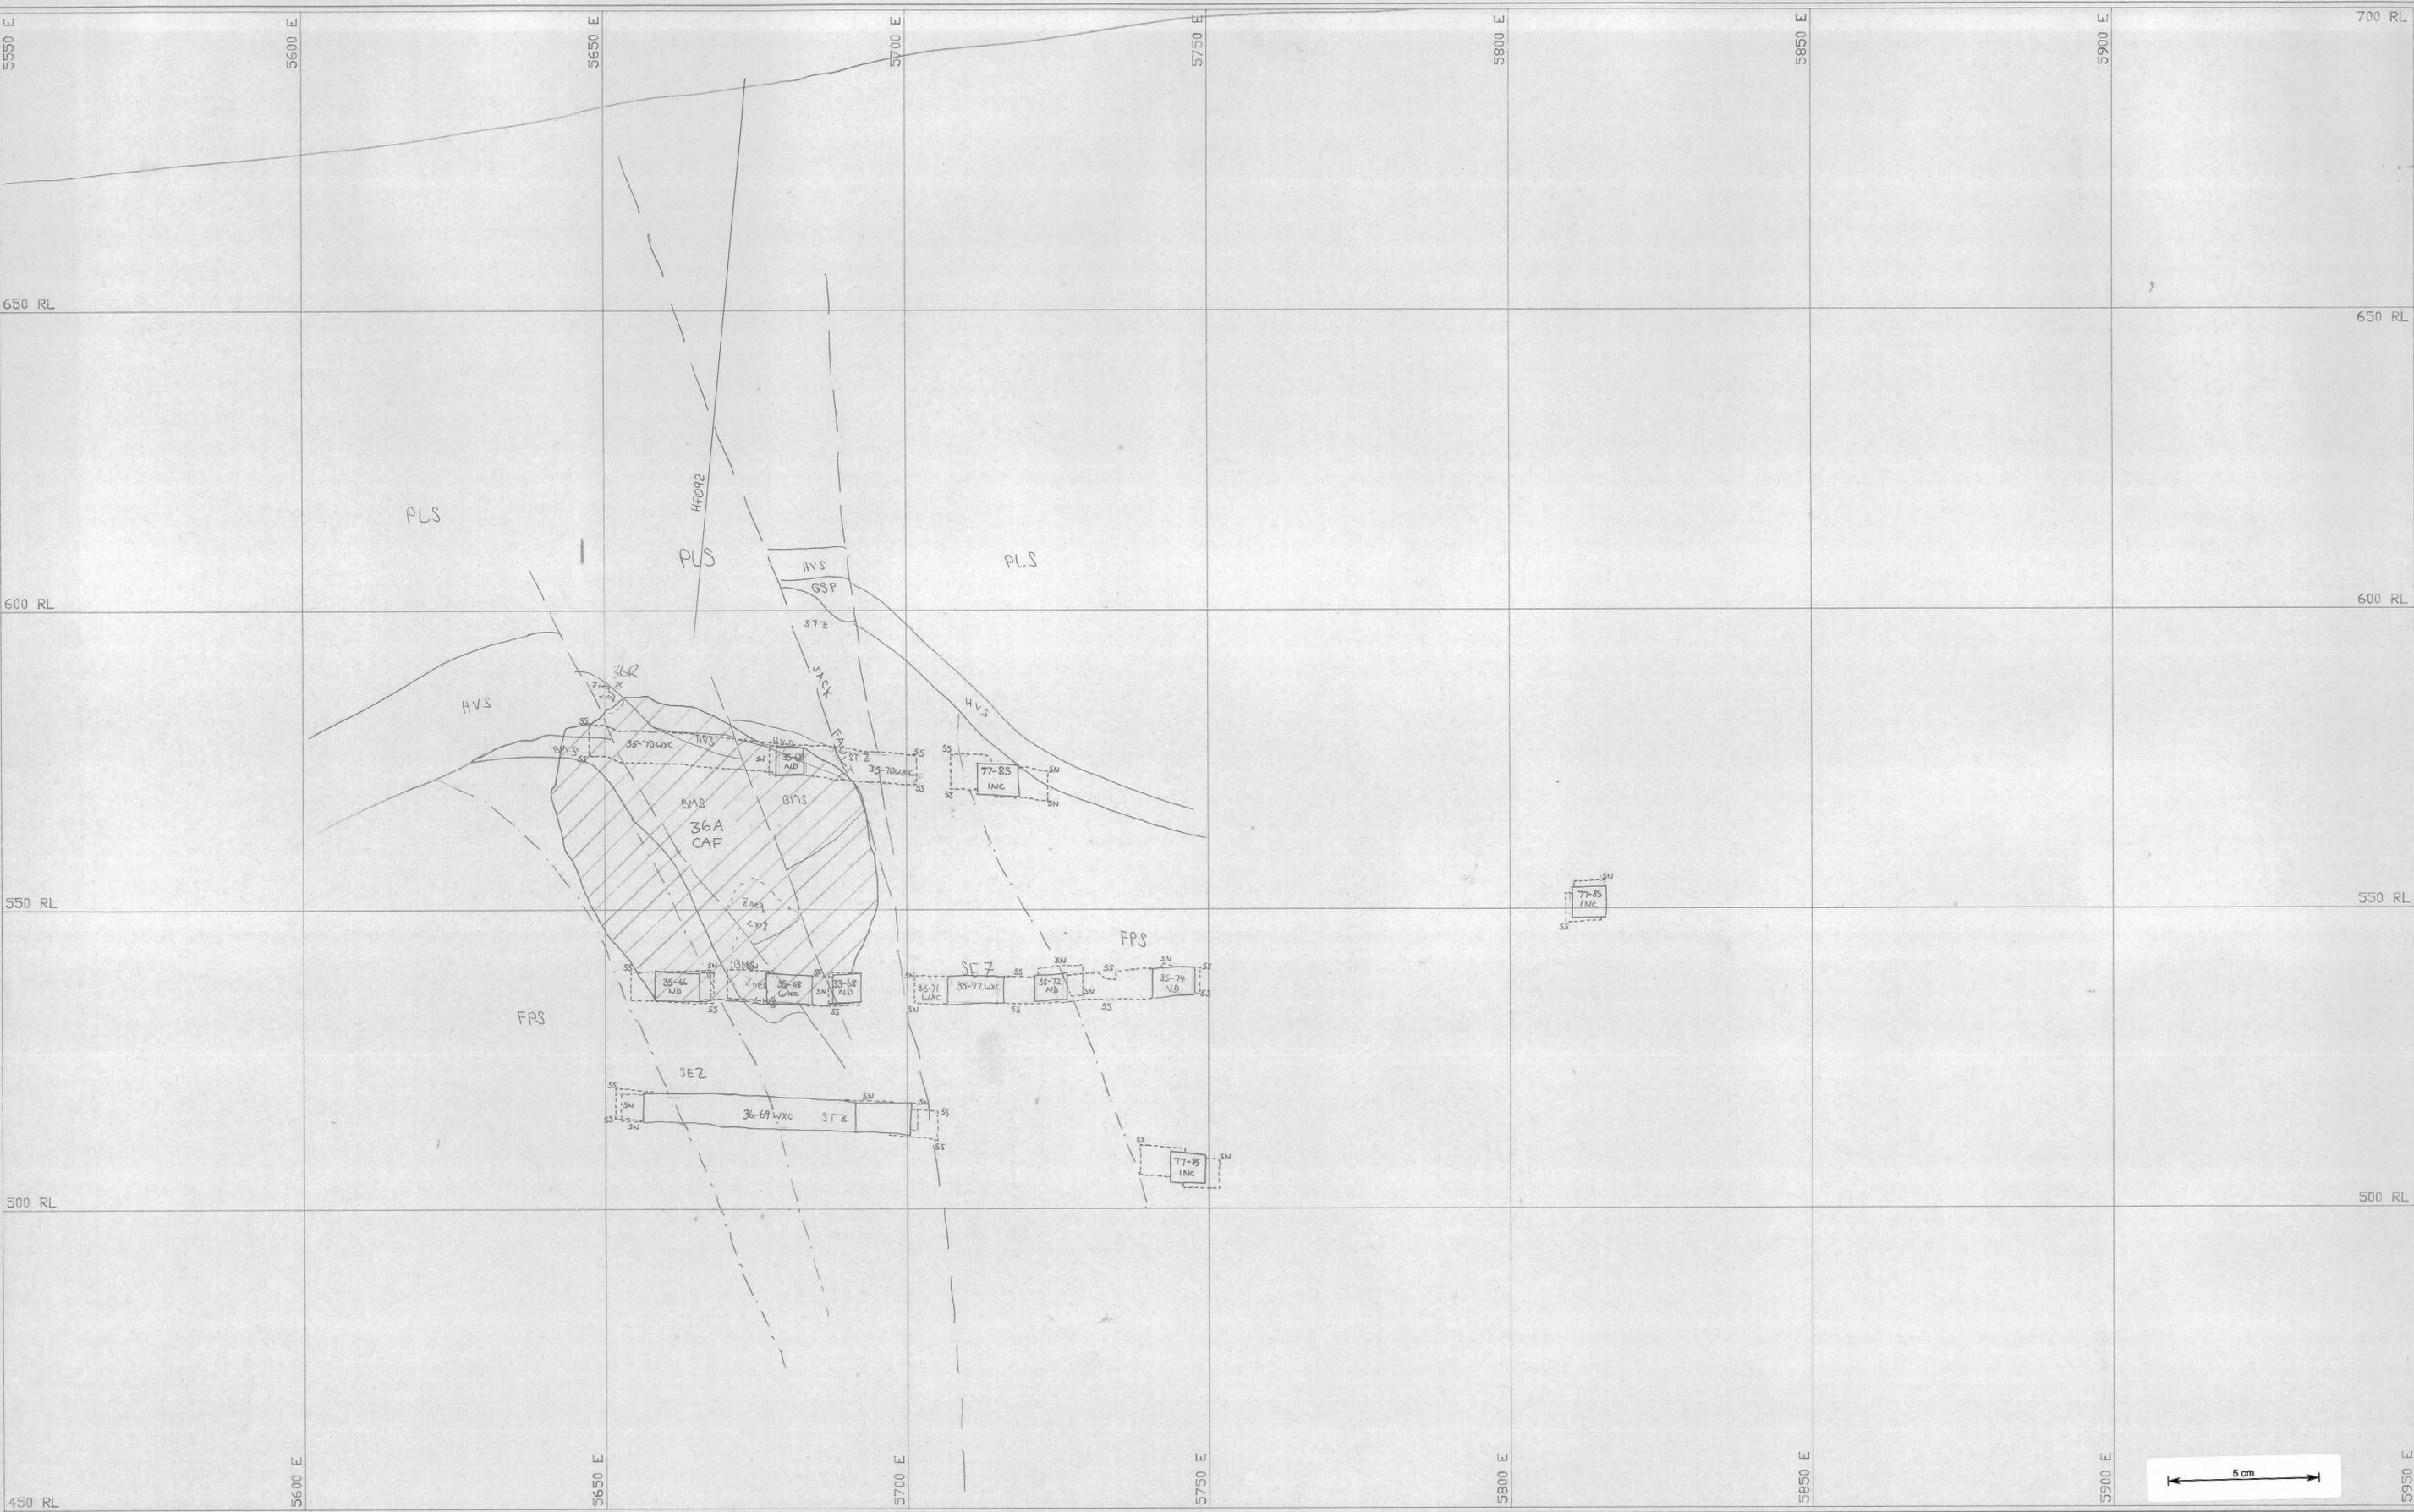

REV	DATE	REVISION	DR	CHK	APP
8	4-8-95	MODIFIED 36A DEVELOPMENT	SS-66 ND/SDOL	WJH	MS
9	12-9-95	35-68 ND, 35-70 WXC	SSOL	ADD	WJH/MS
11	23-5-96	REMOVED 35-70 ND	SSOL		WJH/MS

REV	DATE	REVISION	DR	CHK	APP
10	8-3-96	ADD 35-70 ND	SSOL	40A	STOPE

REV	DATE	REVISION	DR	CHK	APP
1	25-11-91	Geology added			HJK
2	29-11-91	updates to Zone 1			HJK
3	12-8-92	77-85 INC - FISH, BUSH			BR
4	1-12-93	50A REVISION			WJS
5	23/6/94	77-85 INC - 76-77 INC			WJS
6	18/6/95	77-85 INC - 76-77 INC			WJS
7	15/5/95	35-68 ND, 35-68 WXC, 35-68 ND			WJS



REV	DATE	REVISION	DR	CHK	APP
1	25-11-91	Geology added			HJK
2	29-11-91	updates to Zone 1			HJK
3	12-8-92	77-85 INC - FISH, BUSH			BR
4	1-12-93	50A REVISION			WJS
5	23/6/94	77-85 INC - 76-77 INC			WJS
6	18/6/95	77-85 INC - 76-77 INC			WJS
7	15/5/95	35-68 ND, 35-68 WXC, 35-68 ND			WJS



SCALE	1:500
BRAM	
CHECKED	
DESIGNED	
DESIGN CKD	
DESIGN APP	
PROJECT APP	

Aberfoyle Resources Limited
 HELLYER DIVISION
 DEVELOPMENT DESIGN SECTION
10360 N

BRAMING No.	REVISION