


0406-272



8	8-3-96	ADD 37-65 ND SIDE 40A, 37-65 KC	TJM	DTA	MA
9	25-3-96	UPDATED 415V CABLE HEADS	TJM		
10	25-6-96	REMOVE 37-65 ND, ADD 38-70 WXC	JMH	DTA	MA
11	1-8-97	ADD 38-70 WXC	JCS		
12	2-5-98	ADD 38-65 ND	KSP	TWA	CFM

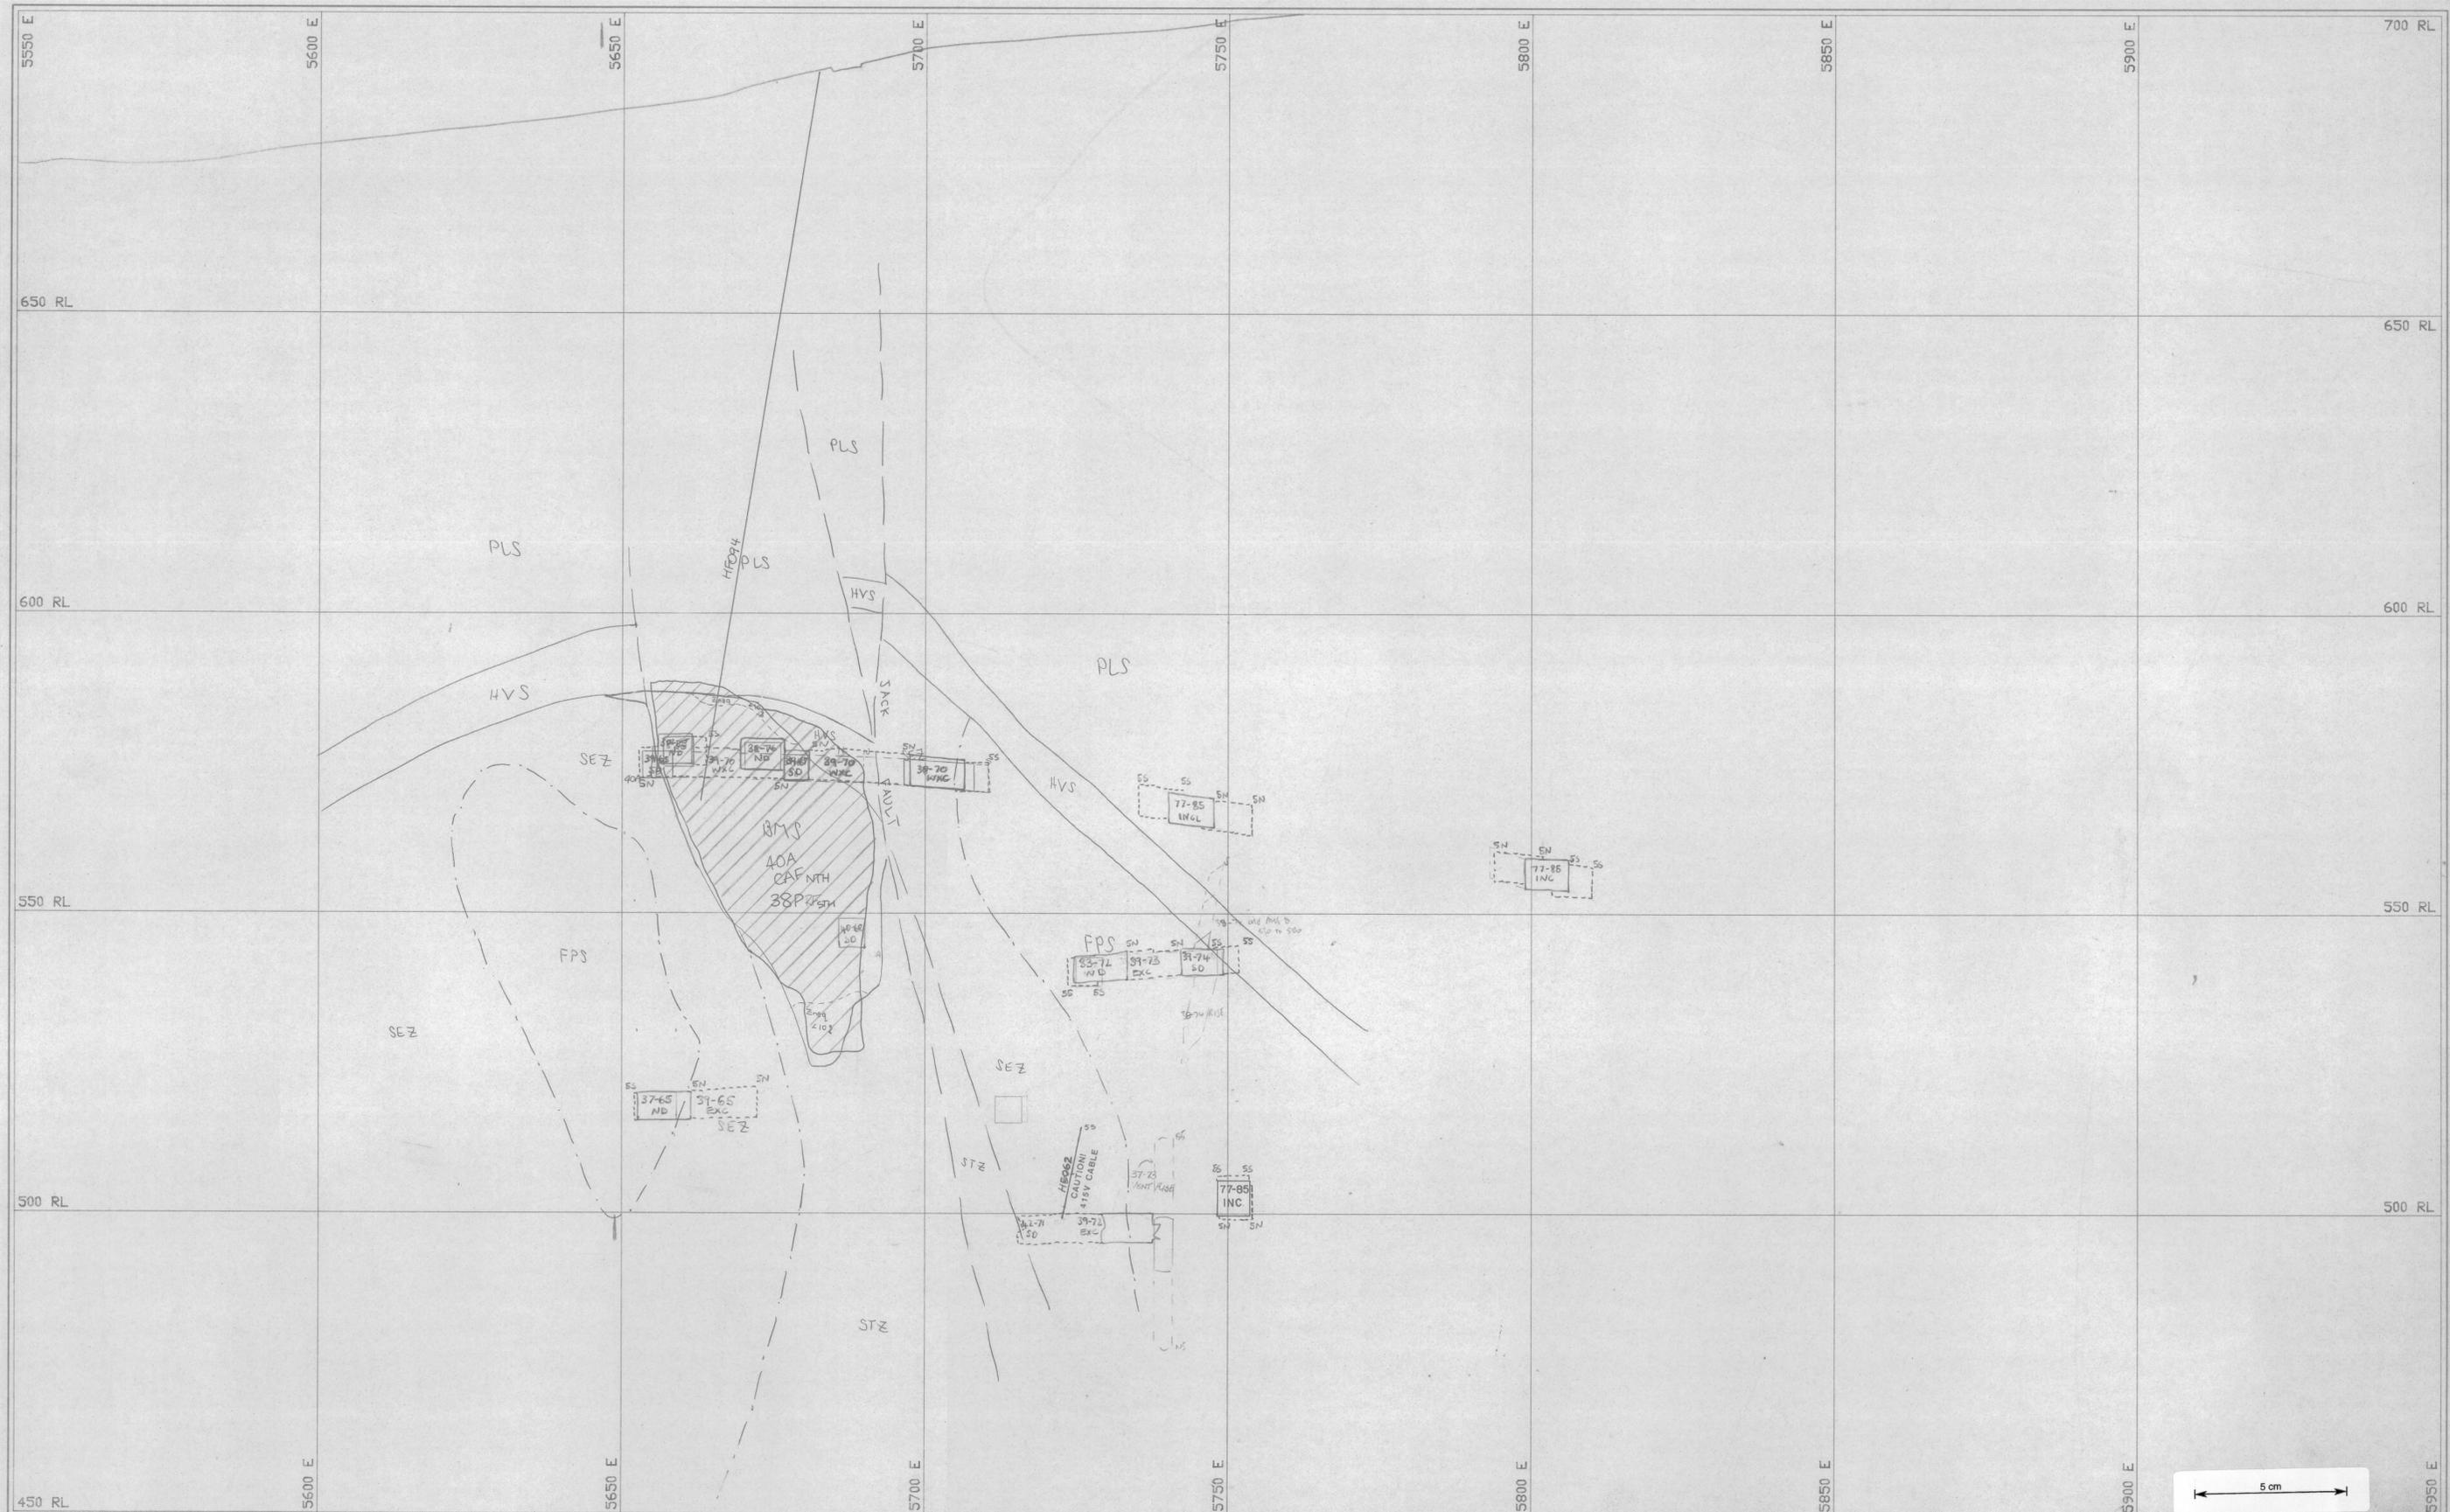

1	25-11-91	Geology added	MSK		
2	21-12-92	updated + 2nd site 2/90	MSK		
3	1-9-93	ADD 515V CABLE 38-70, 37-65	MSK		
4	1-10-93	515V CABLE + 415V	MSK		
5	11-2-94	REMOVE 38-70 WXC	MSK		
6	23-6-94	ADD 38-65 ND	MSK		
7	15-3-94	ADD 38-65 ND, 39-70 WXC, 39-70 ND 5 WXC	TJM		



SCALE	1:500
BRAM	
CHECKED	
DESIGNED	
DESIGN APP	
PROJECT APP	

Aberfoyle Resources Limited
 HELLYER DIVISION
 DEVELOPMENT DESIGN SECTION
10390 N