


96A



REV	DATE	REVISION	DRAWN	CKD	APP	APP
1	6/1/12	Added 240L 230L 210L desc	PR	CGM		
2	26/8/18	Added 93-87ND 230L	VMV	TM	MM	10/9/18

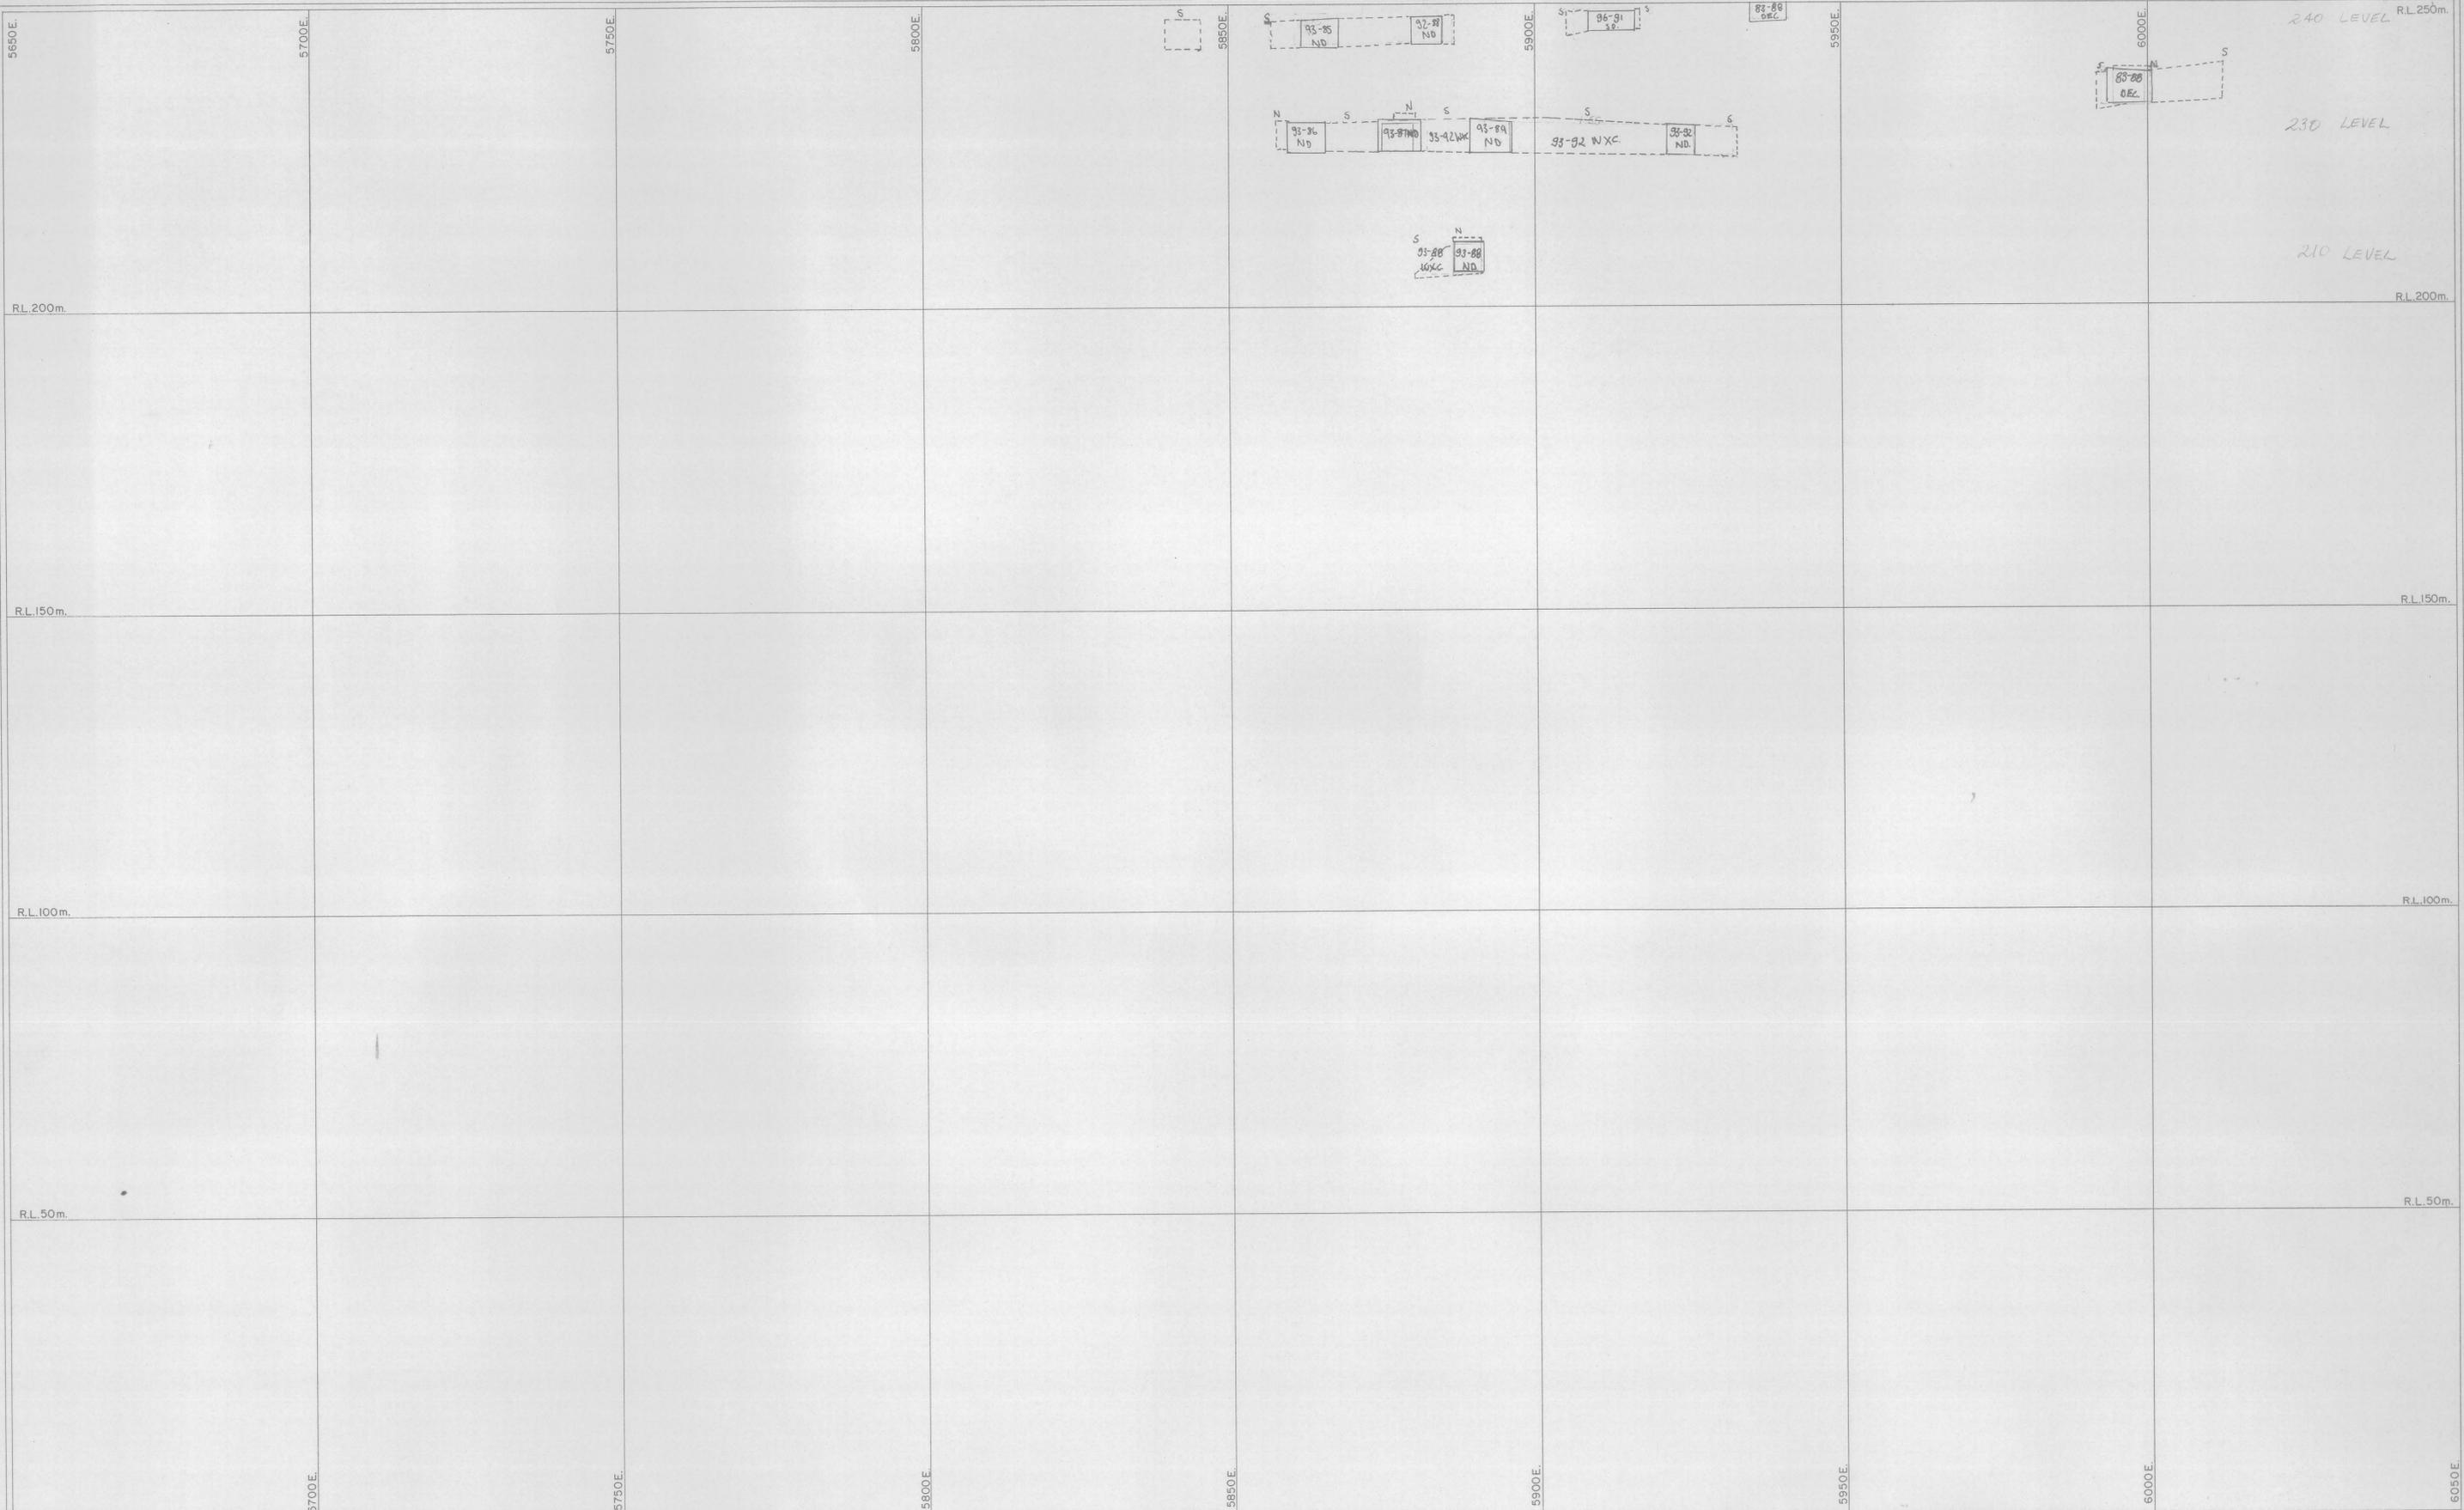

SCALE	1 : 500
SHEET No.	
DRAWN	
CHECKED	
DESIGNED	
DESIGN CKD	
DESIGN APP	
PROJECT APP	

Aberfoyle Resources Limited
HELLYER DIVISION

DEVELOPMENT DESIGN
SECTION 10940N

DRAWING No. 555-9070

5 cm