


9406-9070

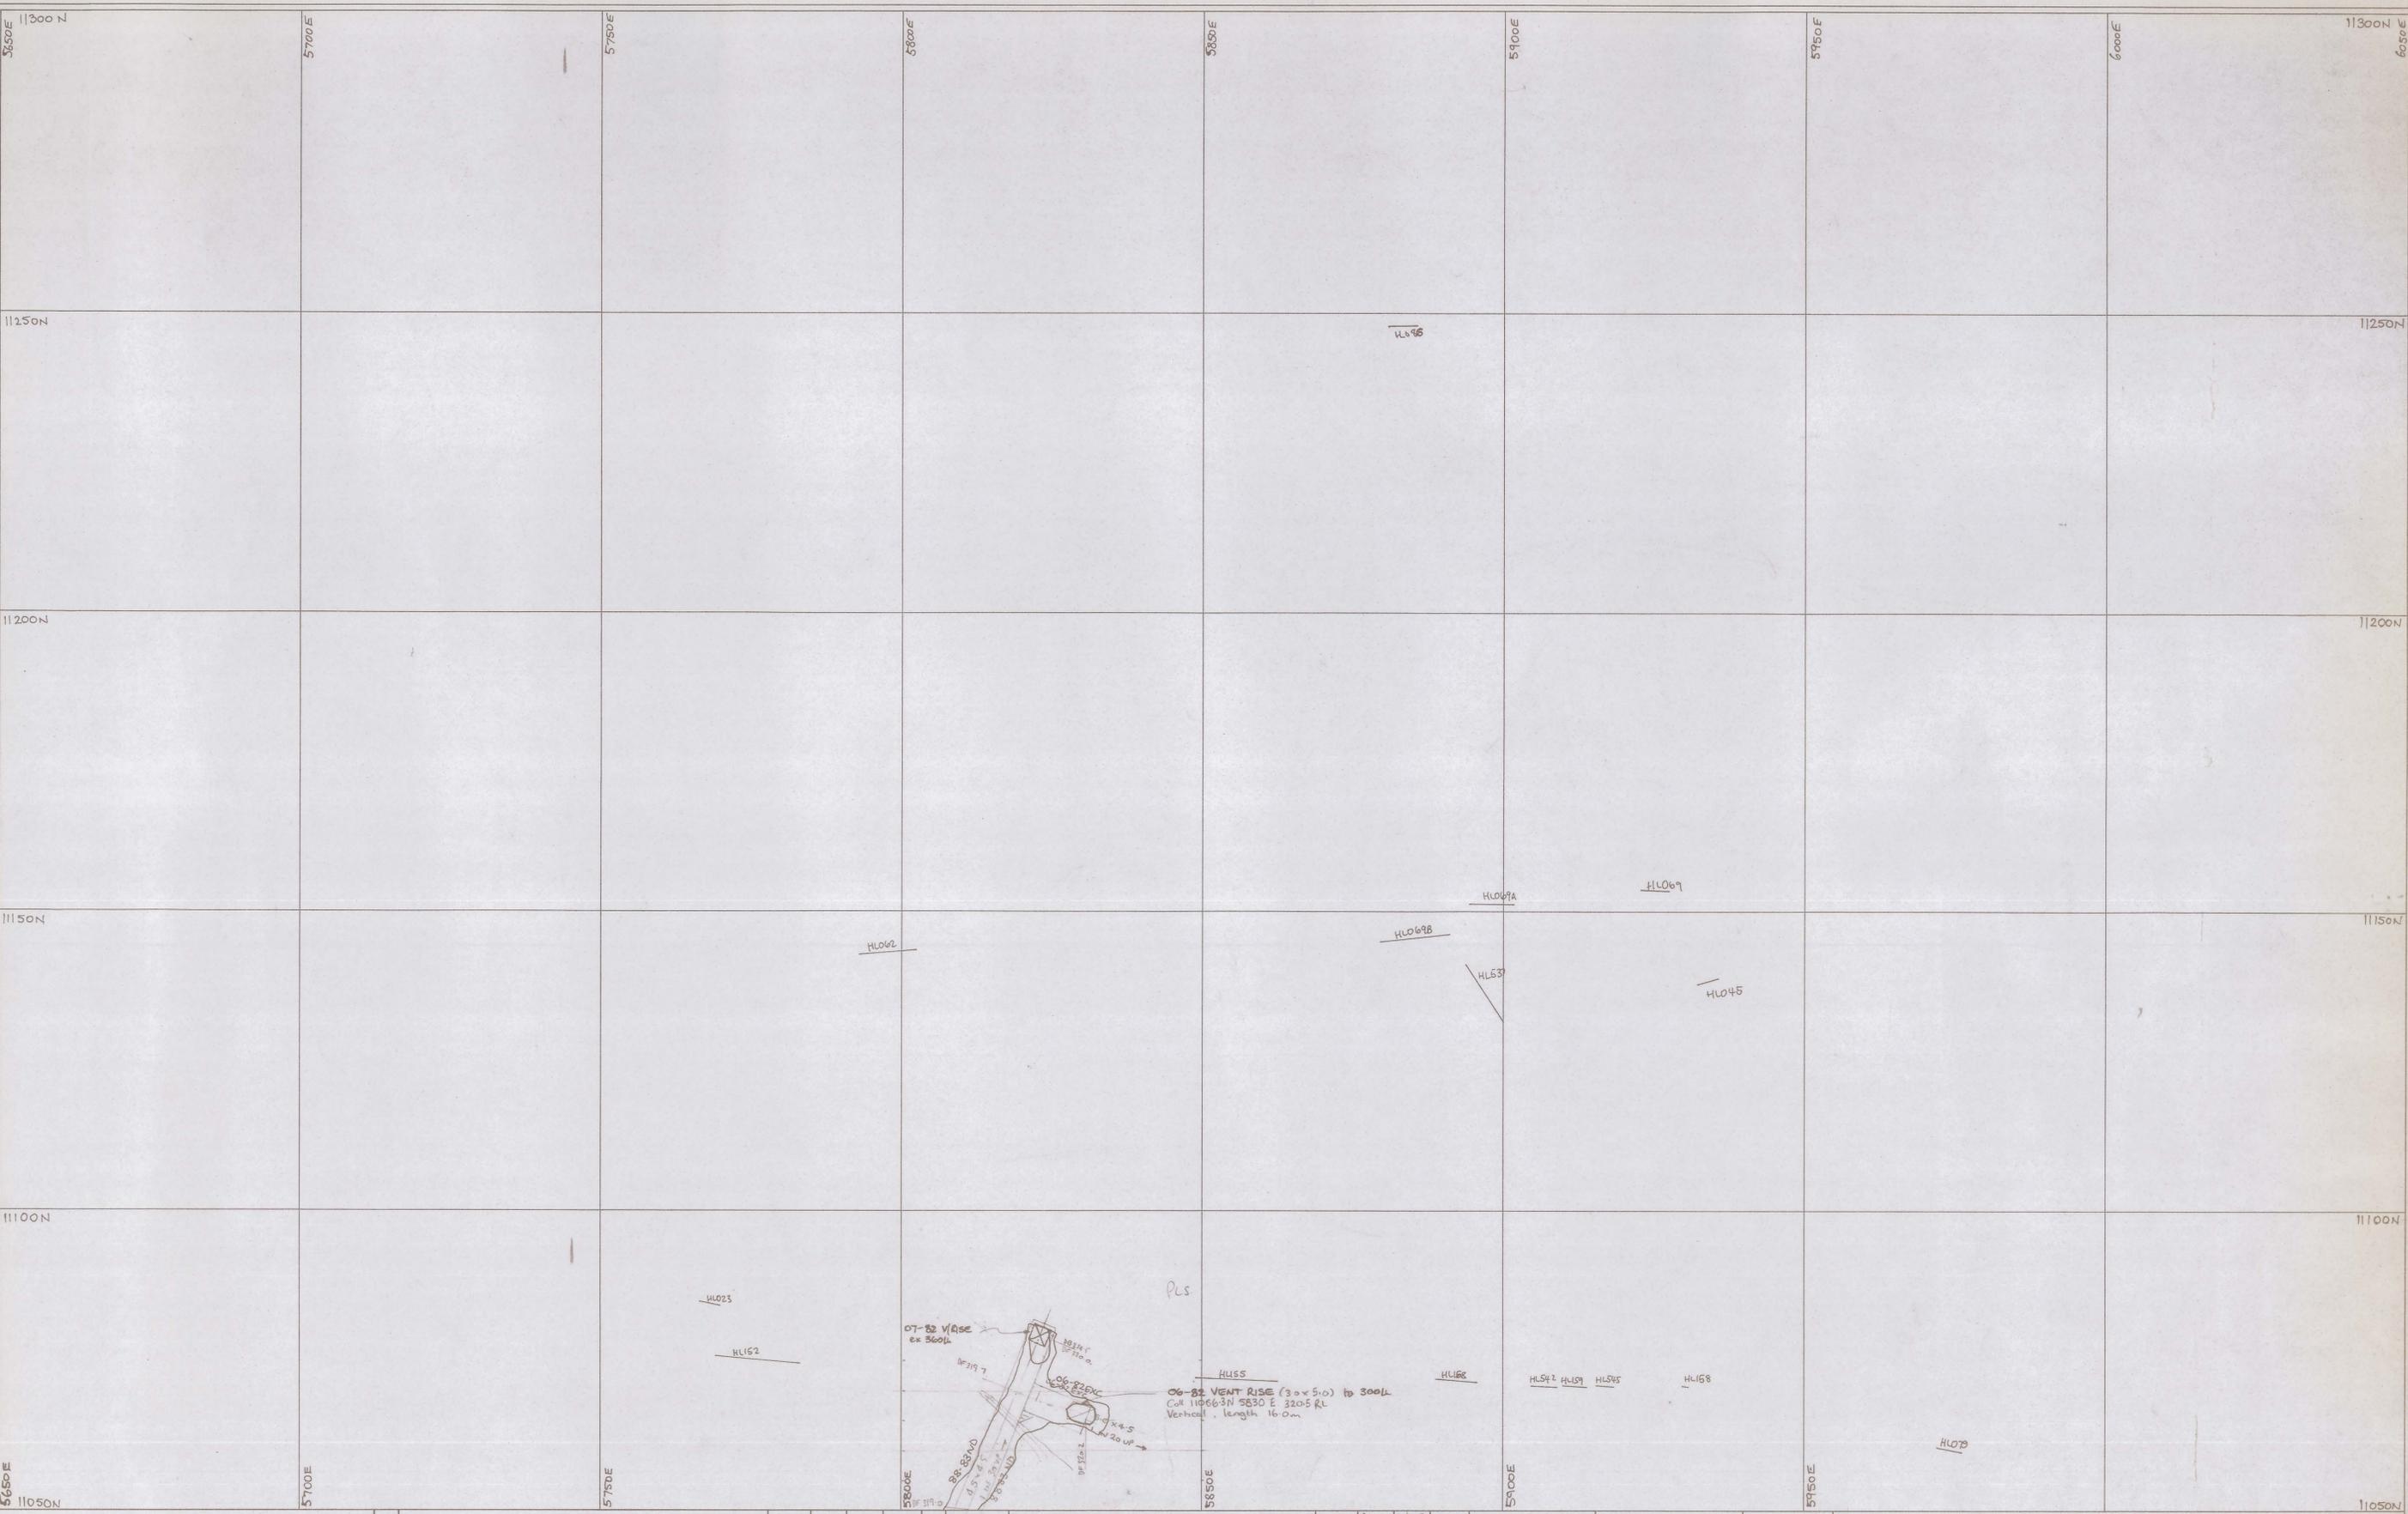

| REV | DATE | REVISION | DRAWN | CKD | APP | DIGIT DATE | REV | DATE | REVISION | DRAWN | CKD | APP | DIGIT DATE |
|-----|----------|---|-------|-----|-----|------------|-----|------|----------|-------|-----|-----|------------|
| 1 | 22/10/90 | Added 88-82 ND DS SWR + DS-82 VR | GCM | ABS | HIB | | | | | | | | |
| 2 | 01/12/90 | Altered 88-82 ND removed 06-81 VR, added 06-82 VR | GCM | ABS | HIB | | | | | | | | |
| 3 | 31/9/91 | Altered 06-82 VR | ML | SM | HIB | | | | | | | | |

SCALE 1:500

SHEET No. 1130-605

DRAWN GCM 22/10/90

CHECKED

DESIGNED

DESIGN CKD

DESIGN APP

PROJECT APP

NORTH

Aberfoyle Resources Limited
HELLYER DIVISION

PROJECT DEVELOPMENT DESIGN

DRAWING No. 320 LEVEL - 2

5 cm