


0406-379

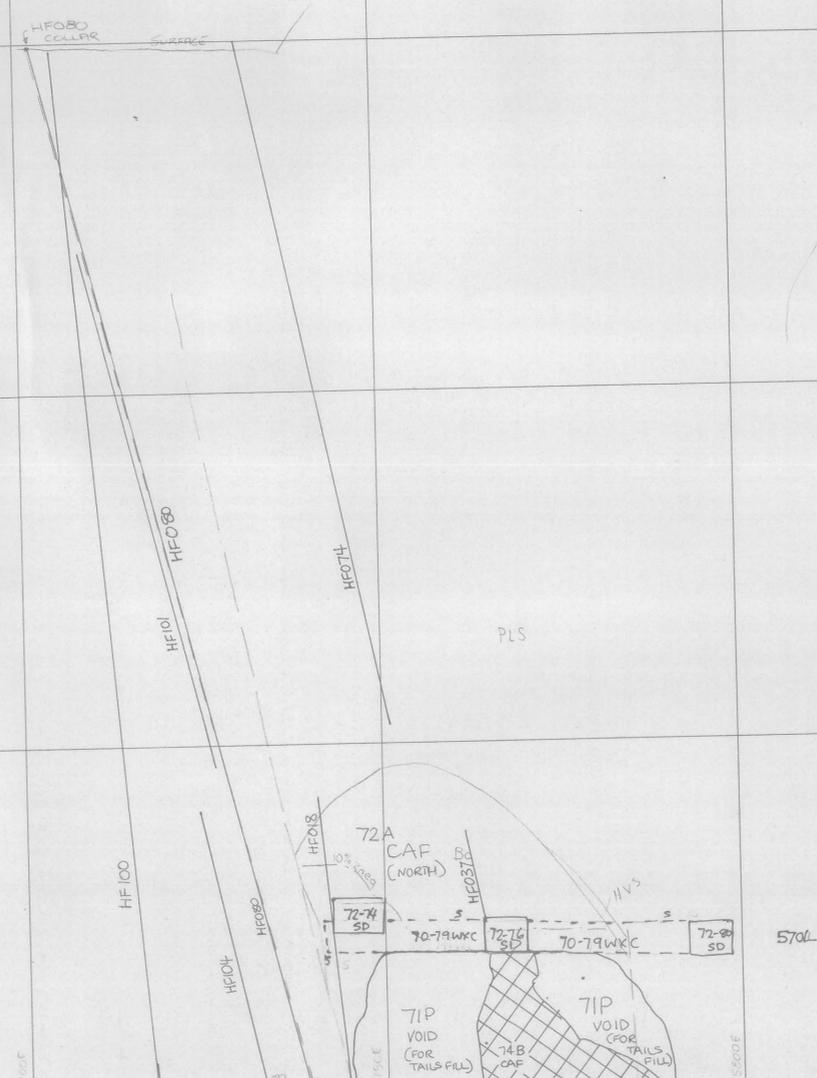

REV	DATE	REVISION	DRAWN	CKD	APP	APP
8	26/3/96	HFO80 FILL HOLE ADDED	JMH	DTA		
9	5/12/96	SHORTENED 70-79WXC STOL FOR TIPWAK TAIL	TAT	VJO		

REV	DATE	REVISION	DRAWN	CKD	APP	APP
1	8/5/92	73-76SD 71-76 EVC STOL ADDED	AMM			
2	1/5/97	GEOLOGY TRACED FROM SECTION DATED 2/10/91	AMM			
3	4/2/93	73-76SD 71-76 EVC STOL DELETED, ADDED 72-76SD	ML	AMM		
4	11/1/95	STOL 72-80 SD, 70-79 WXC & 70-76 ND ADDED	AMM	MHL		
5	16/2/96	STOL 72-74 SD ADDED	JUM			
6	2.2.96	GEOLOGY UPDATED	CSG			
7	22/1/96	74B CAF OUTLINE	DJA	DM		

SCALE 1:500	SHEET No.
DRAWN	
CHECKED	
DESIGNED	
DESIGN CKD	
DESIGN APP	
PROJECT APP	

Aberfoyle Resources Limited
HELLYER DIVISION

DEVELOPMENT DESIGN
SECTION 10710N (UPPER)

DRAWING No. 5

5cm

