


0406_389



0406_389

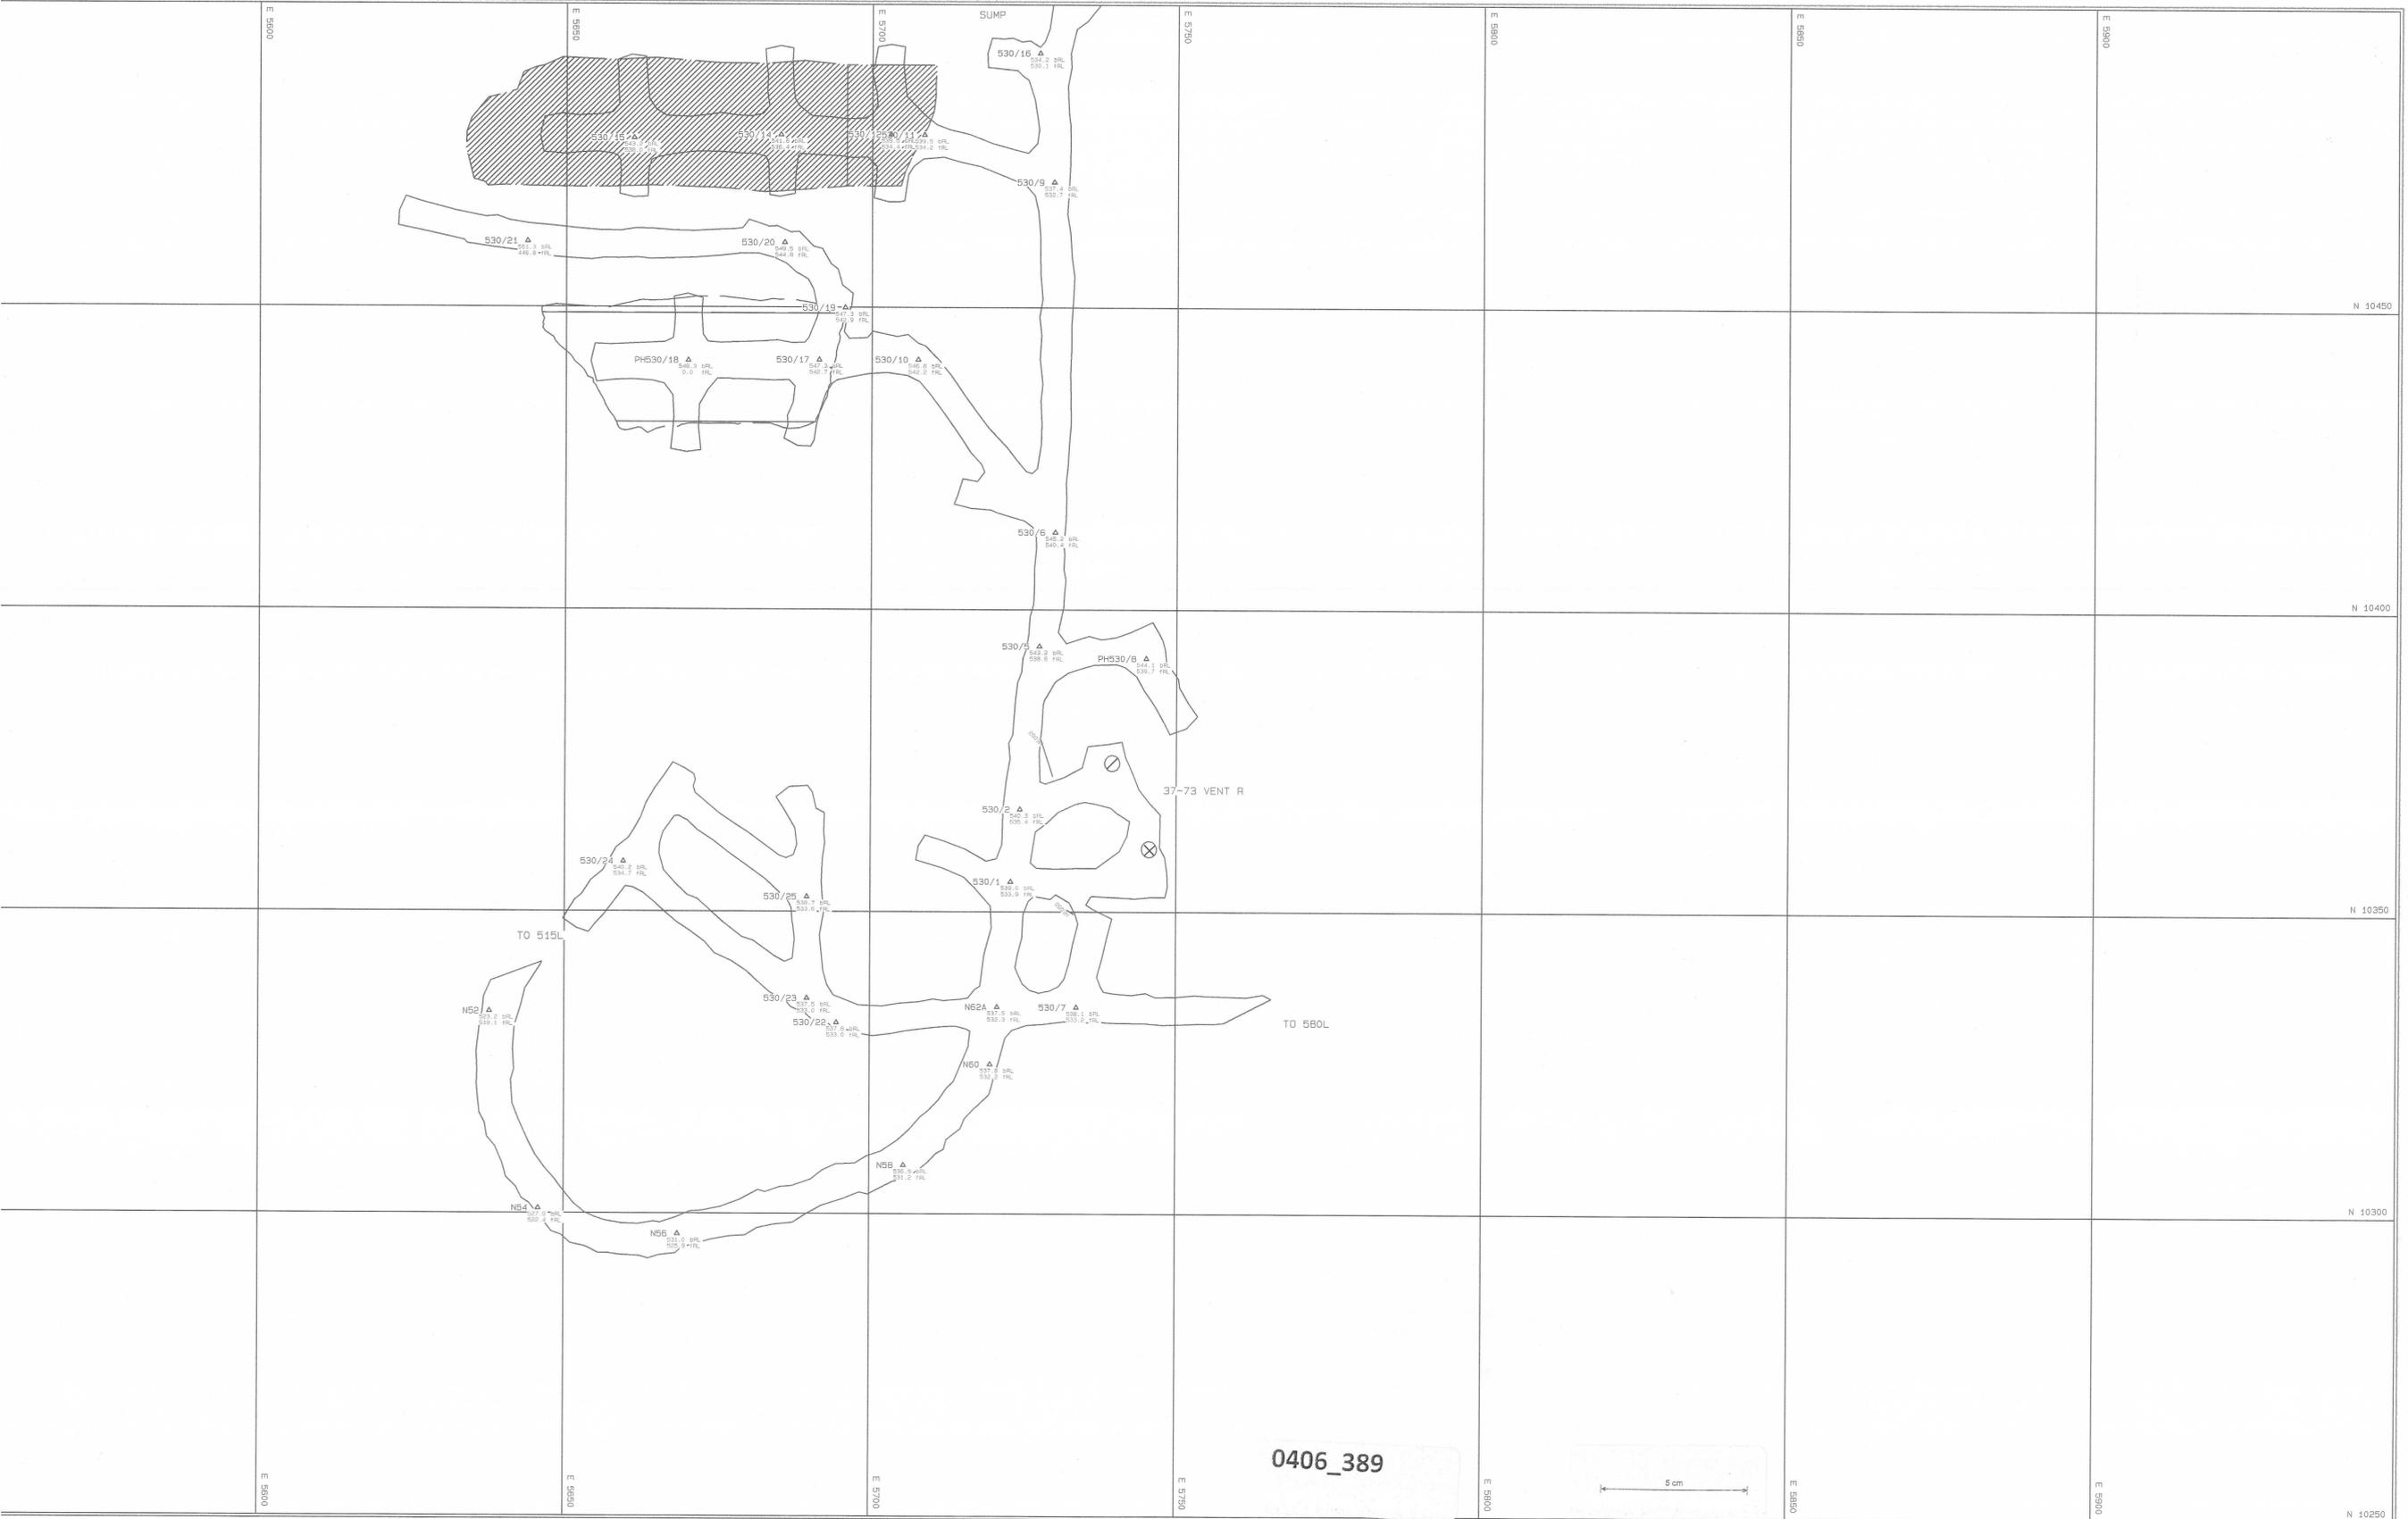

KEY

- HP = PROBE HOLE
- HA = COMP. AIR HOLE
- HV = VENT HOLE
- HE = ELECTRICAL HOLE
- HW = WATER HOLE
- HF = FILL HOLE

REV	DATE	REVISION	DRAWN	CHK	APP	APP



SCALE 1: 500

DRAWN	DAS	8-Feb-95
CHECKED	TJ	
DESIGNED		
DESIGN APP.		
PROJECT APP.		

ABERFOYLE RESOURCES LTD.
HELLYER DIVISION

HELLYER MINE
LEVEL PLAN
HORIZON 530mRL

Drawing No.	
REVISION	