


0406_392



0406_392

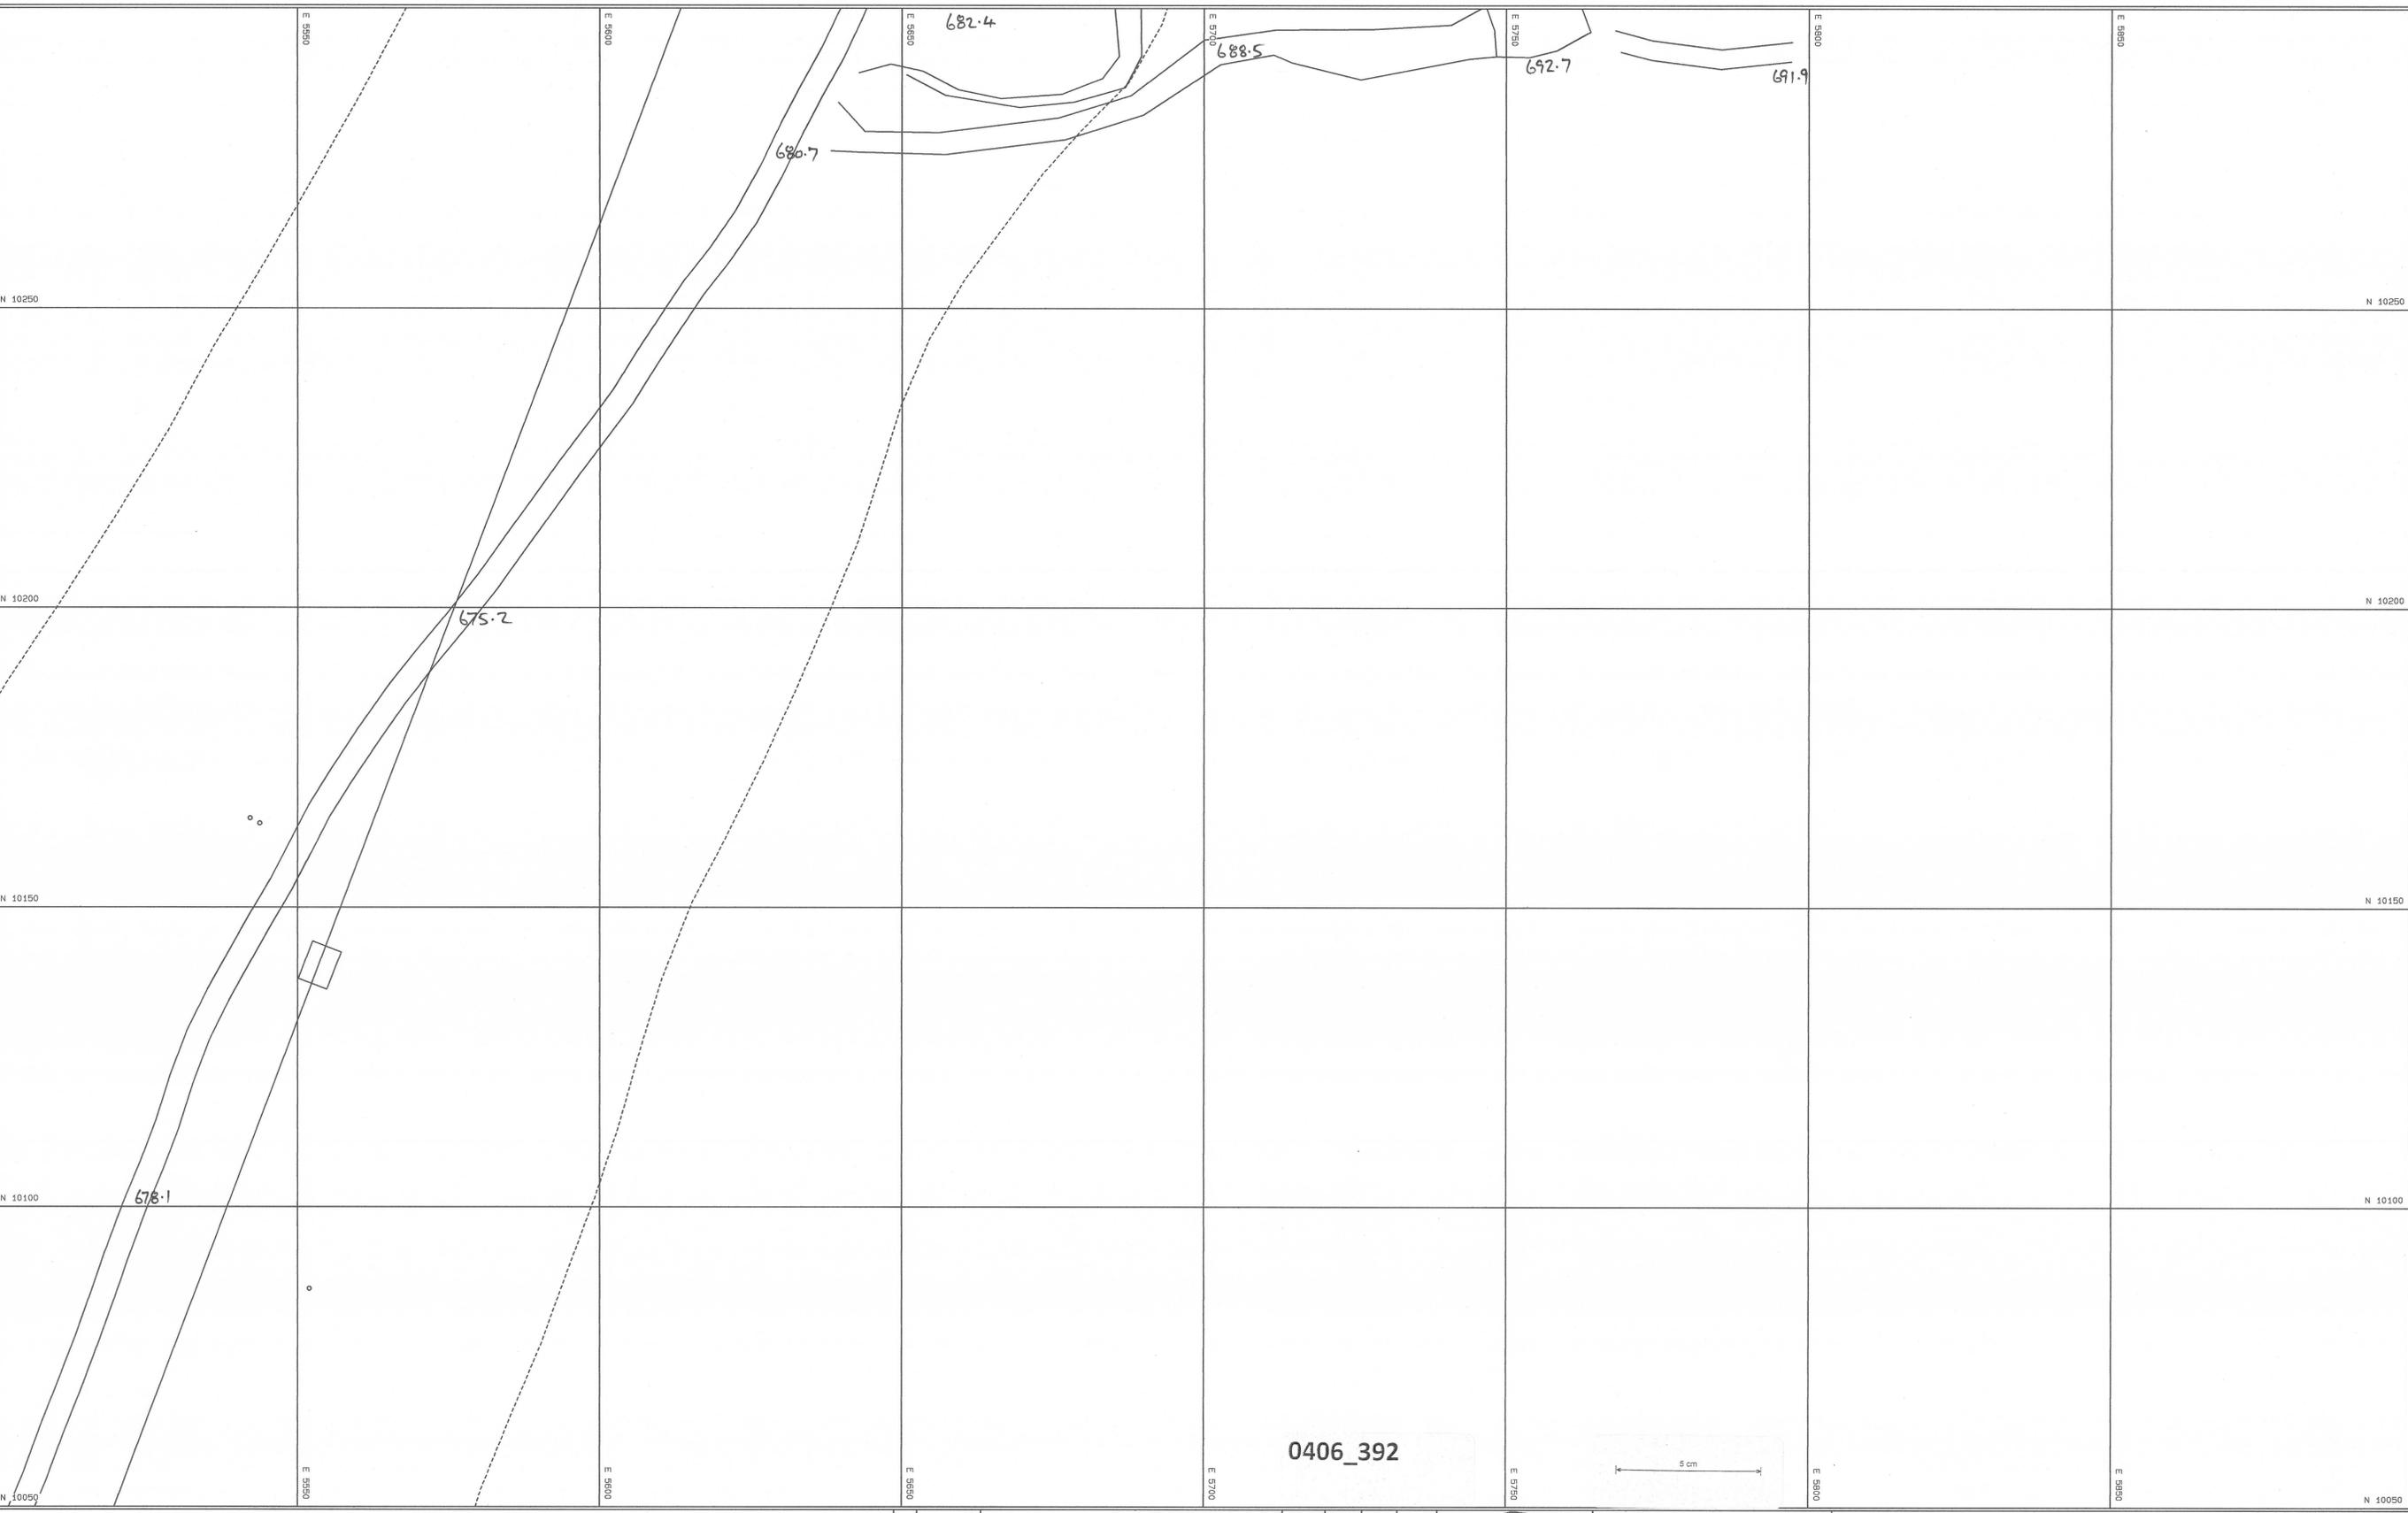

KEY

- HP = PROBE HOLE
- HA = CDM. AIR HOLE
- HV = VENT HOLE
- HE = ELECTRICAL HOLE
- HW = WATER HOLE
- HF = FILL HOLE

REV	DATE	REVISION	DRAWN	CHK	APP	APP



SCALE 1: 500		
DRAWN	DAS	2-May-96
CHECKED	<i>[Signature]</i>	
DESIGNED		
DESIGN CHK.		
DESIGN APP.		
PROJECT APP.		

ABERFOYLE RESOURCES LTD.
HELLYER DIVISION

Aberfoyle Hellyer Mine
Surface Workings
March 1996

Drawing No. _____
REVISION _____