


0406\_409

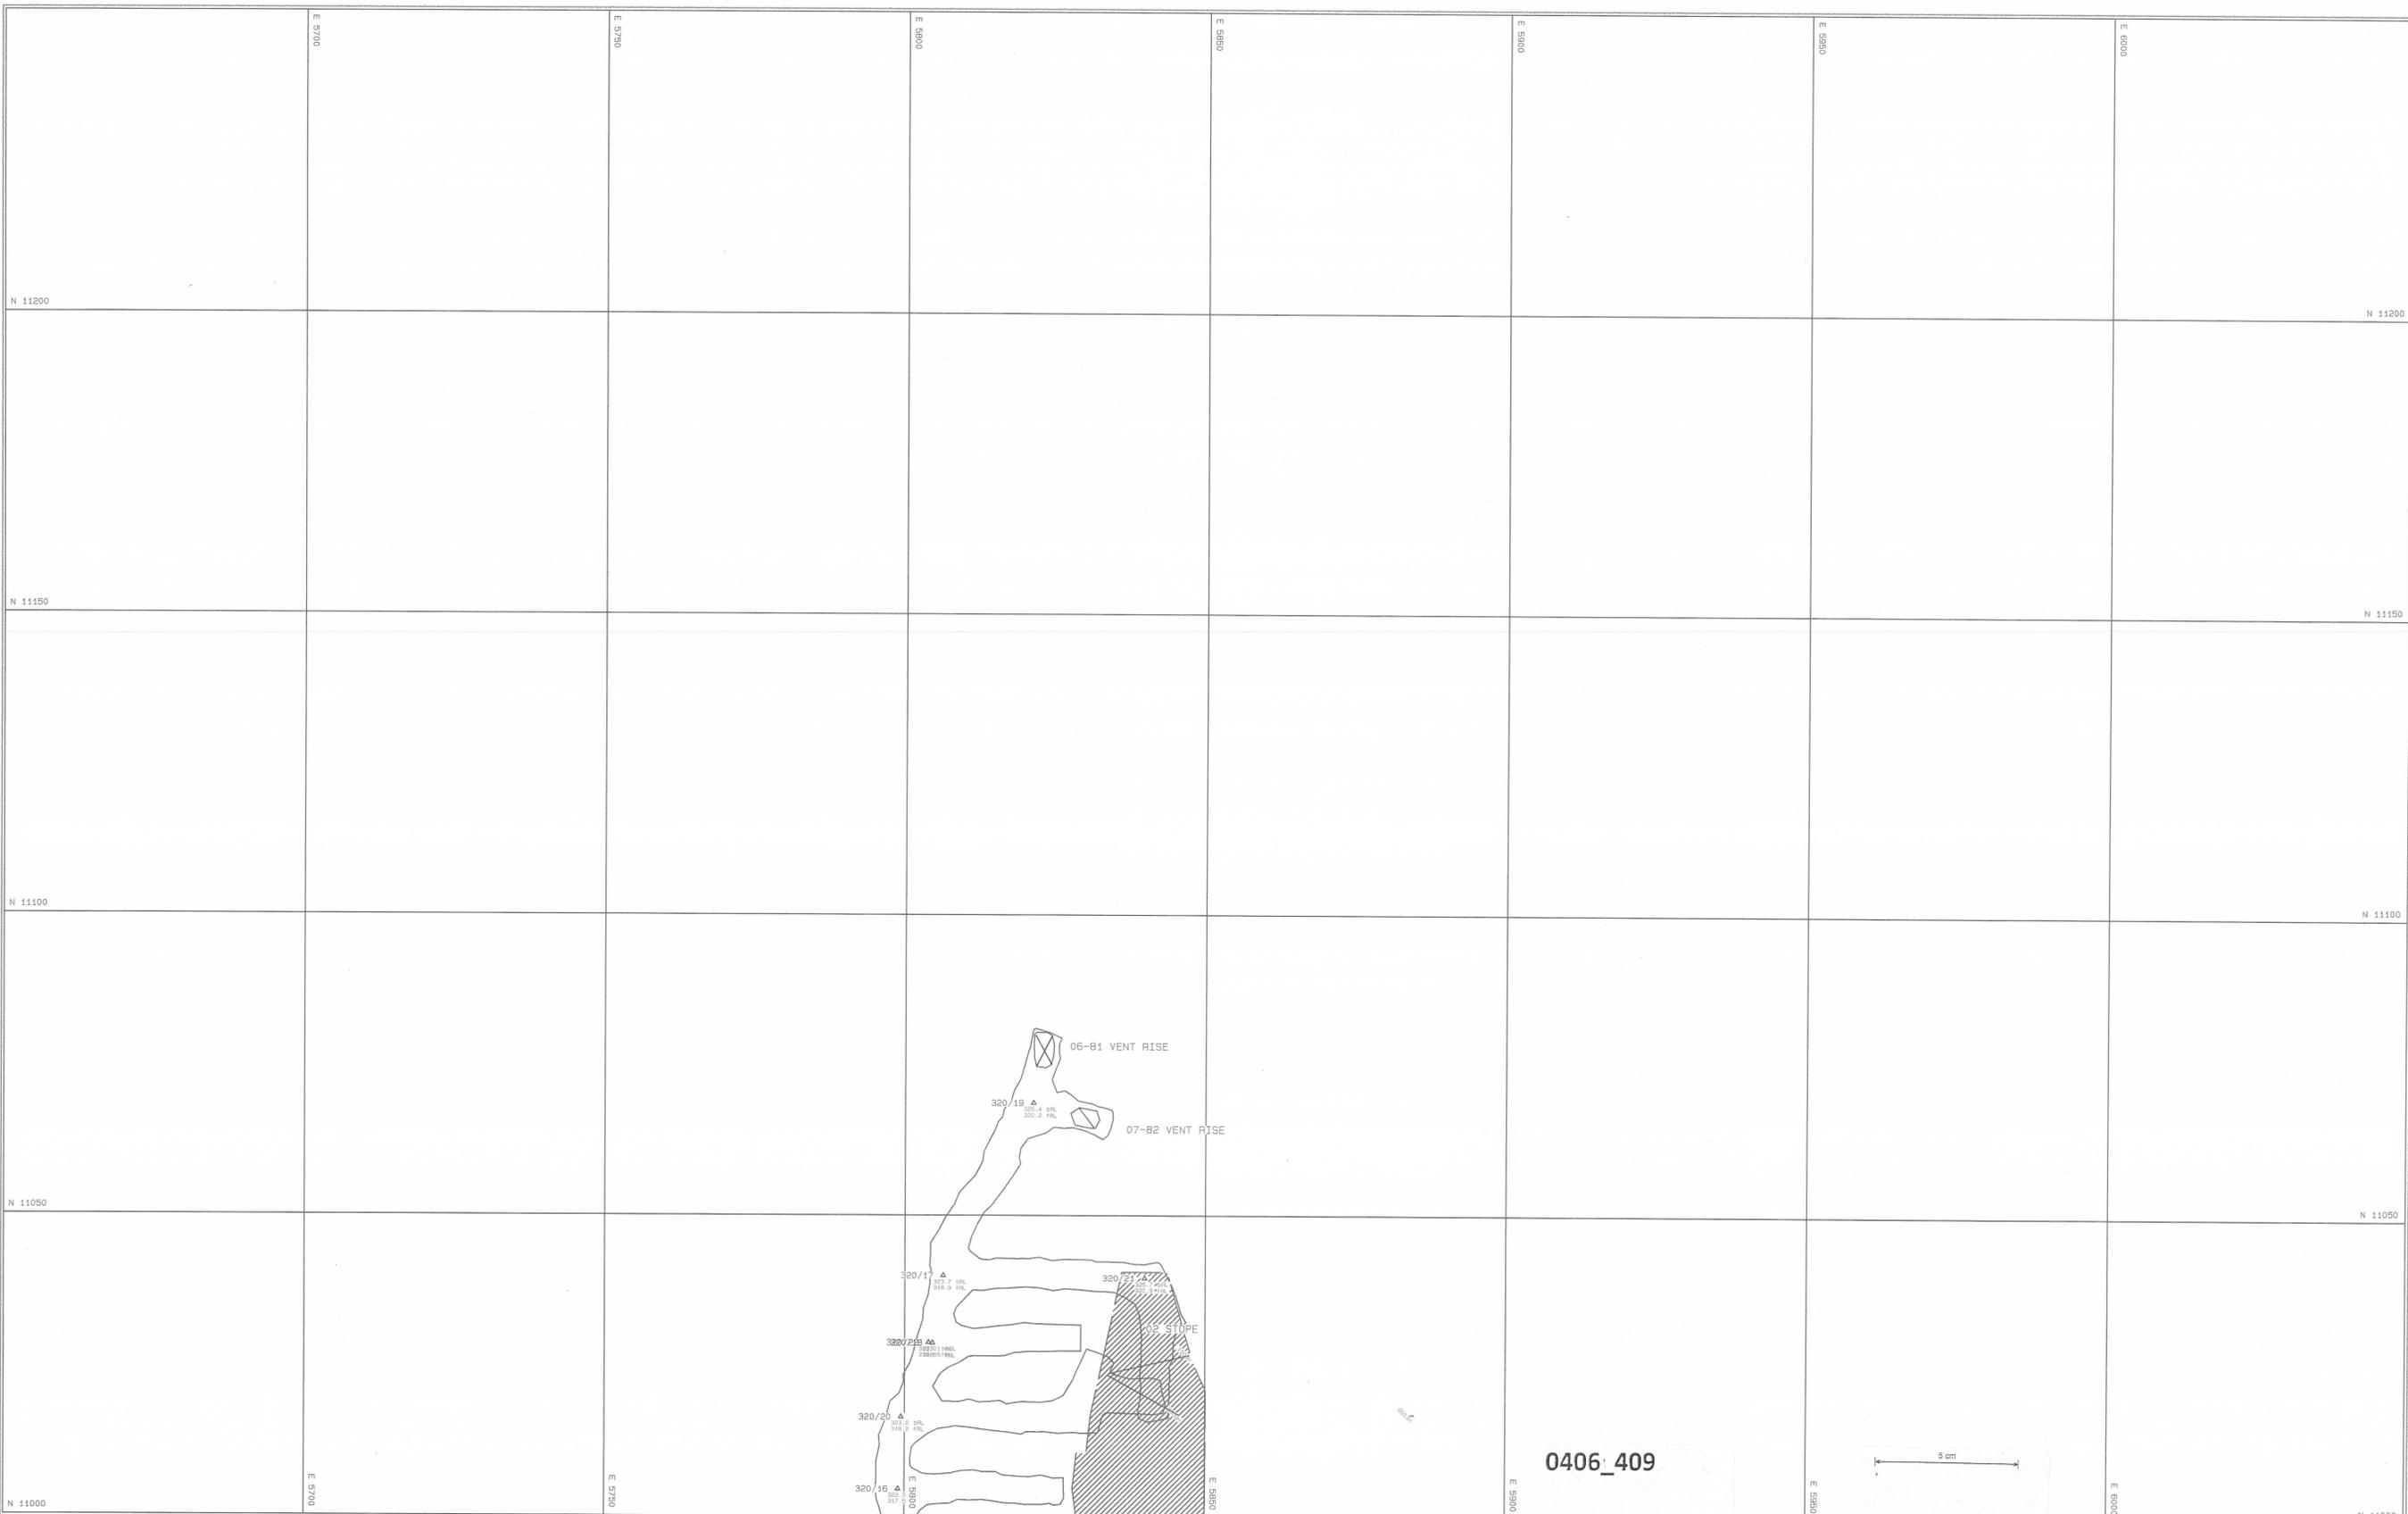

0406\_409

5 cm

KEY

- HP = PROBE HOLE
- HA = COMP. AIR HOLE
- HV = VENT HOLE
- HE = ELECTRICAL HOLE
- HW = WATER HOLE
- HF = FILL HOLE

REV	DATE	REVISION	DRAWN	CHKD	APP	APP



SCALE 1: 500

DRAWN	DAS	8-Feb-96
CHECKED	TJ.	
DESIGNED		
DESIGN CHG.		
DESIGN APP.		
PROJECT APP.		

ABERFOYLE RESOURCES LTD.  
HELLYER DIVISION

HELLYER MINE  
LEVEL PLAN  
HORIZON 320mRL

DRAWING NO.	
REVISION	