


0406_411

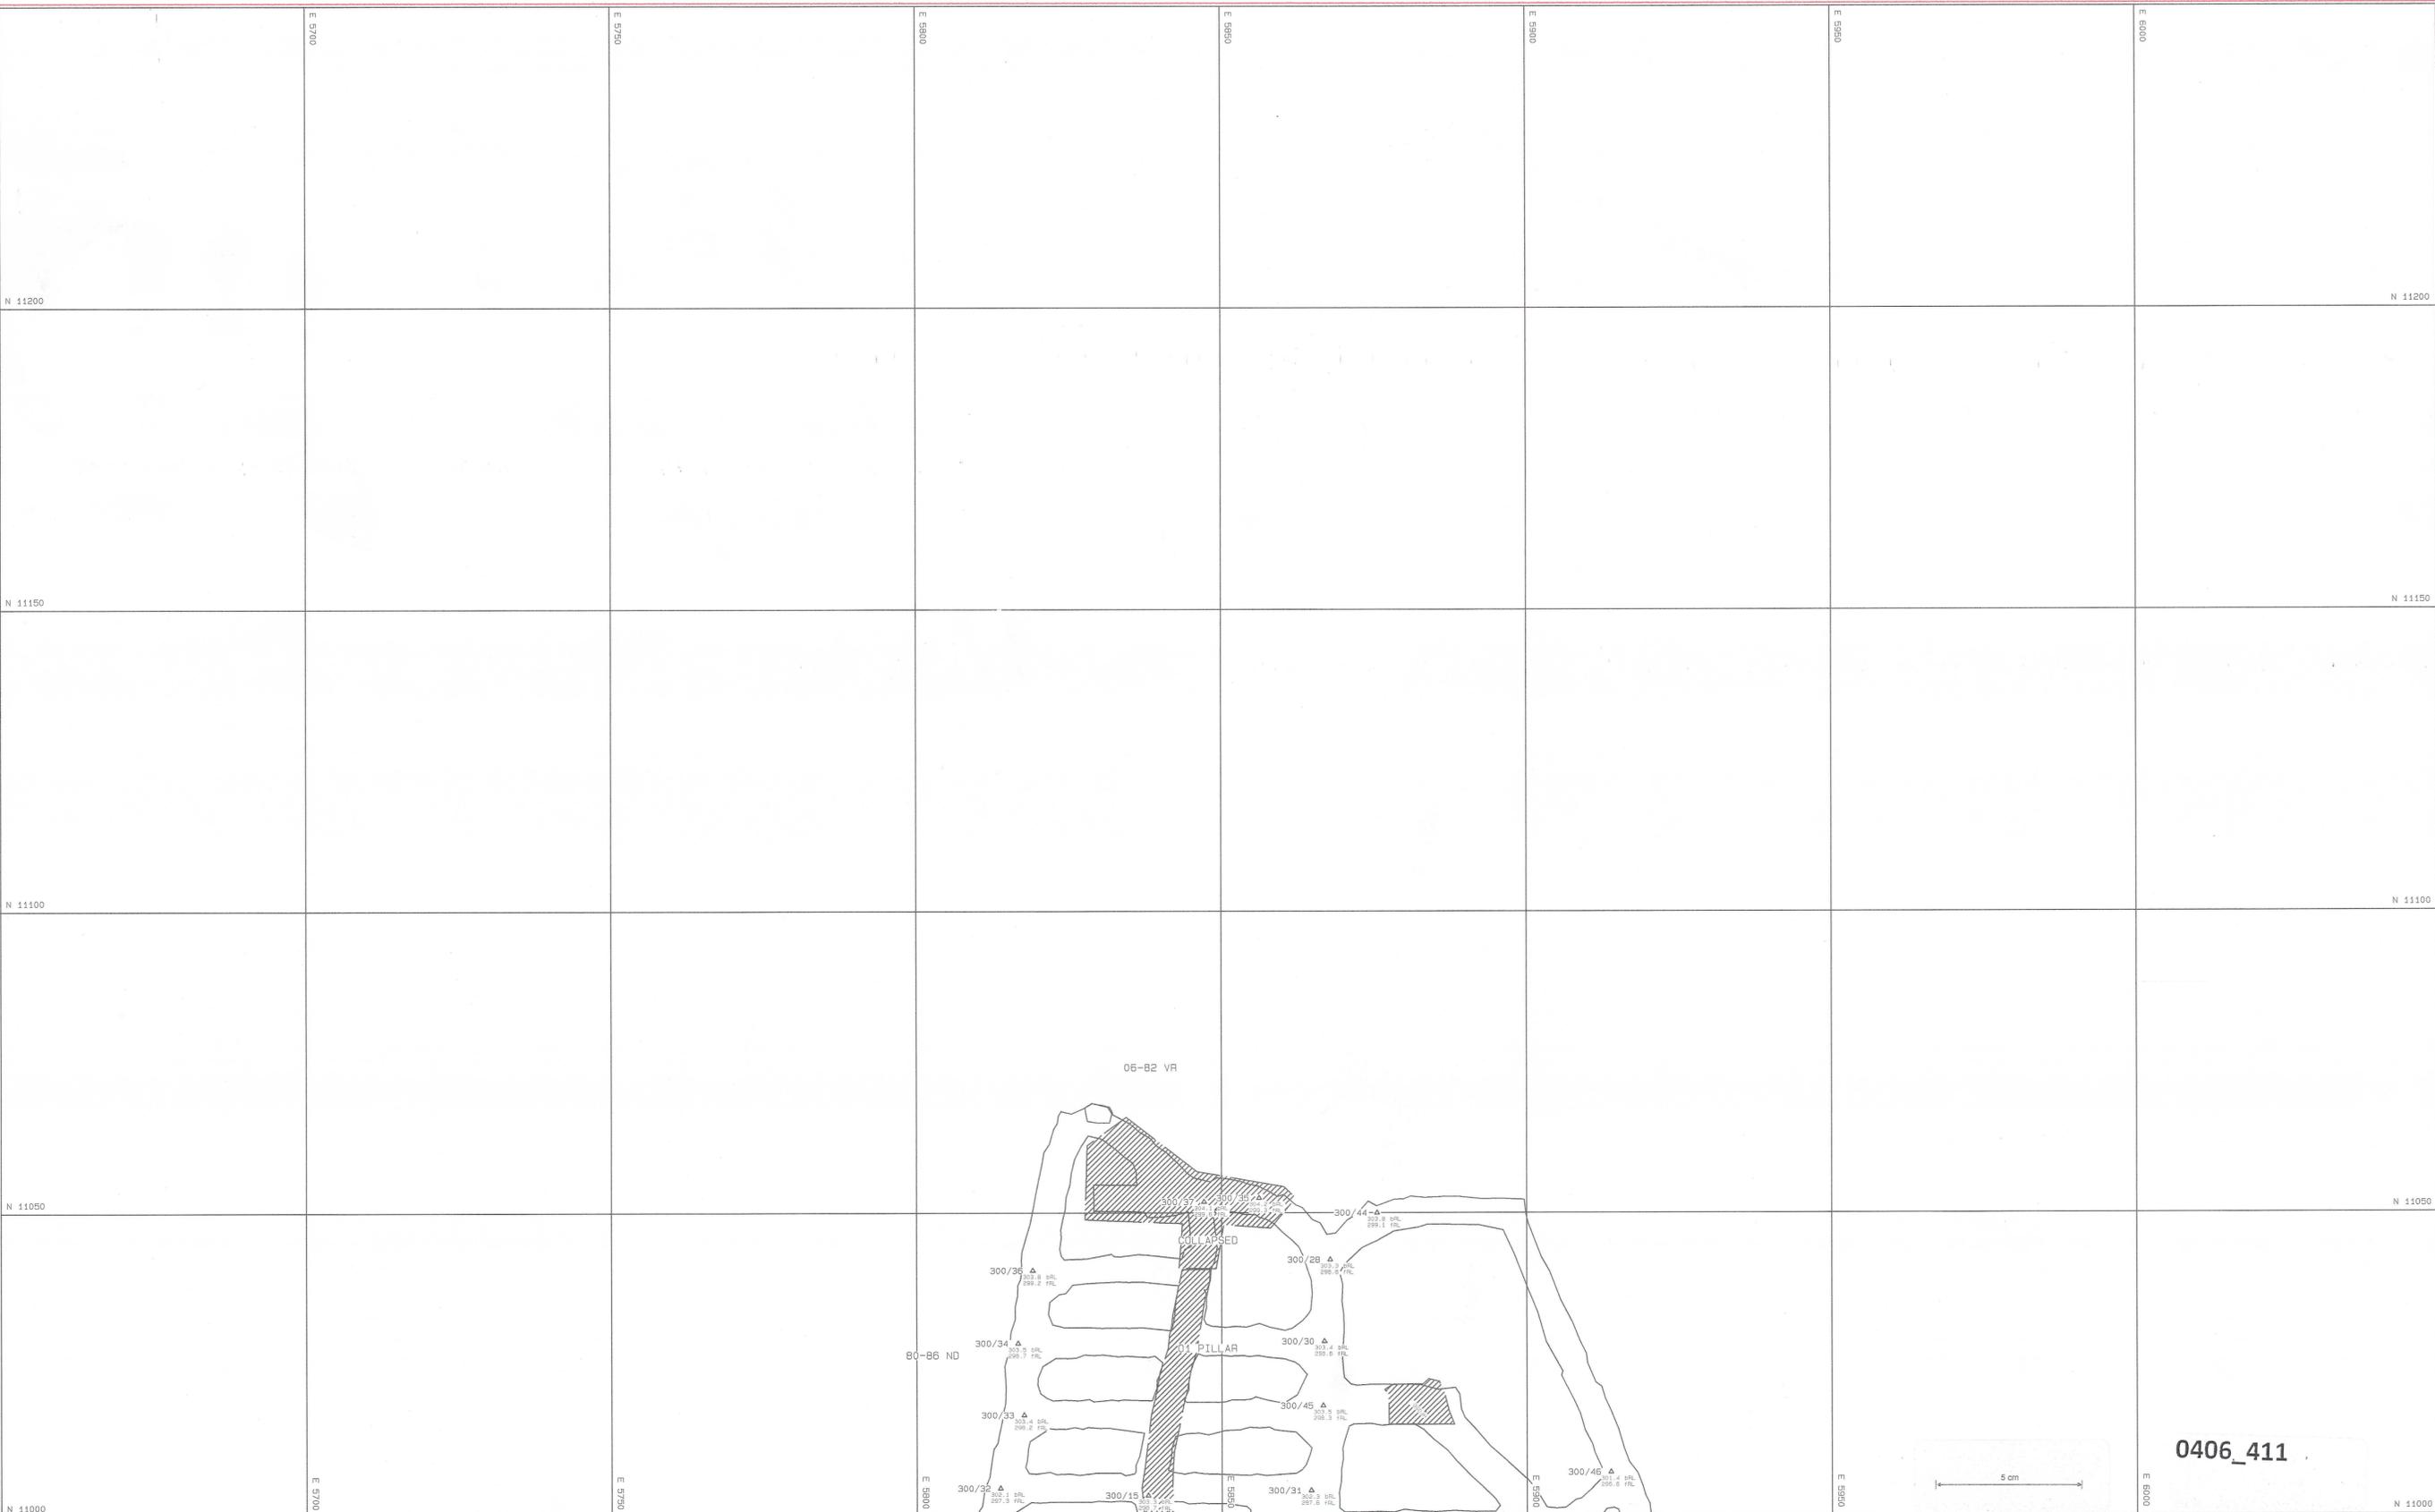

0406_411

KEY

- HP = PROBE HOLE
- HA = COMP. AIR HOLE
- HV = VENT HOLE
- HE = ELECTRICAL HOLE
- HW = WATER HOLE
- HF = FILL HOLE

REV	DATE	REVISION	DRAWN	CKD	APP	APP



SCALE 1: 500

DRAWN	DAS	8-Feb-96
CHECKED	<i>[Signature]</i>	
DESIGNED		
DESIGN CKD.		
DESIGN APP.		
PROJECT APP.		

ABERFOYLE RESOURCES LTD.
HELLYER DIVISION

HELLYER MINE
LEVEL PLAN
HORIZON 300mRL

Drawing No.
REVISION