


NOTES
 COORDINATE DATUM PLANE BASED ON
 AMG (AGD66) AT SPM 8856
 E 482534.294
 N 5289013.161
 RL 99.95
 SCALE FACTOR OF 1.00042017 APPLIED ABOUT
 SPM 8856 TO BRING AMG COORDINATES
 TO PLANE MEASURES
 CONTOUR LEVEL DATUM AHD (TAS)

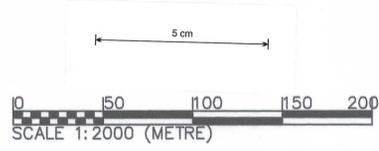

SURVEY RESOURCES
 (A.B.N. 42 316 275 625)
 26 Holbrook St. Inveresk
 PO Box 1192
 Launceston
 Tasmania 7250

Authorised
 Land, Engineering
 & Mining Surveyors

Telephone: (03) 6331 5721
 Facsimile: (03) 6331 5741
 Email: admin@surveyresources.com.au

SCALE:	1:2000 AT A1
DRAWN:	NP
DESIGNED:	
DATE:	11.12.2012
APPROVED:	

KIMBOLTON COAL NL
 MRT RETURN 2012
 AS AT 15/10/2012
 HAMILTON, TAS

REFERENCE:
06.010
 (GCV65)