


Hole location map
1971

0415_029

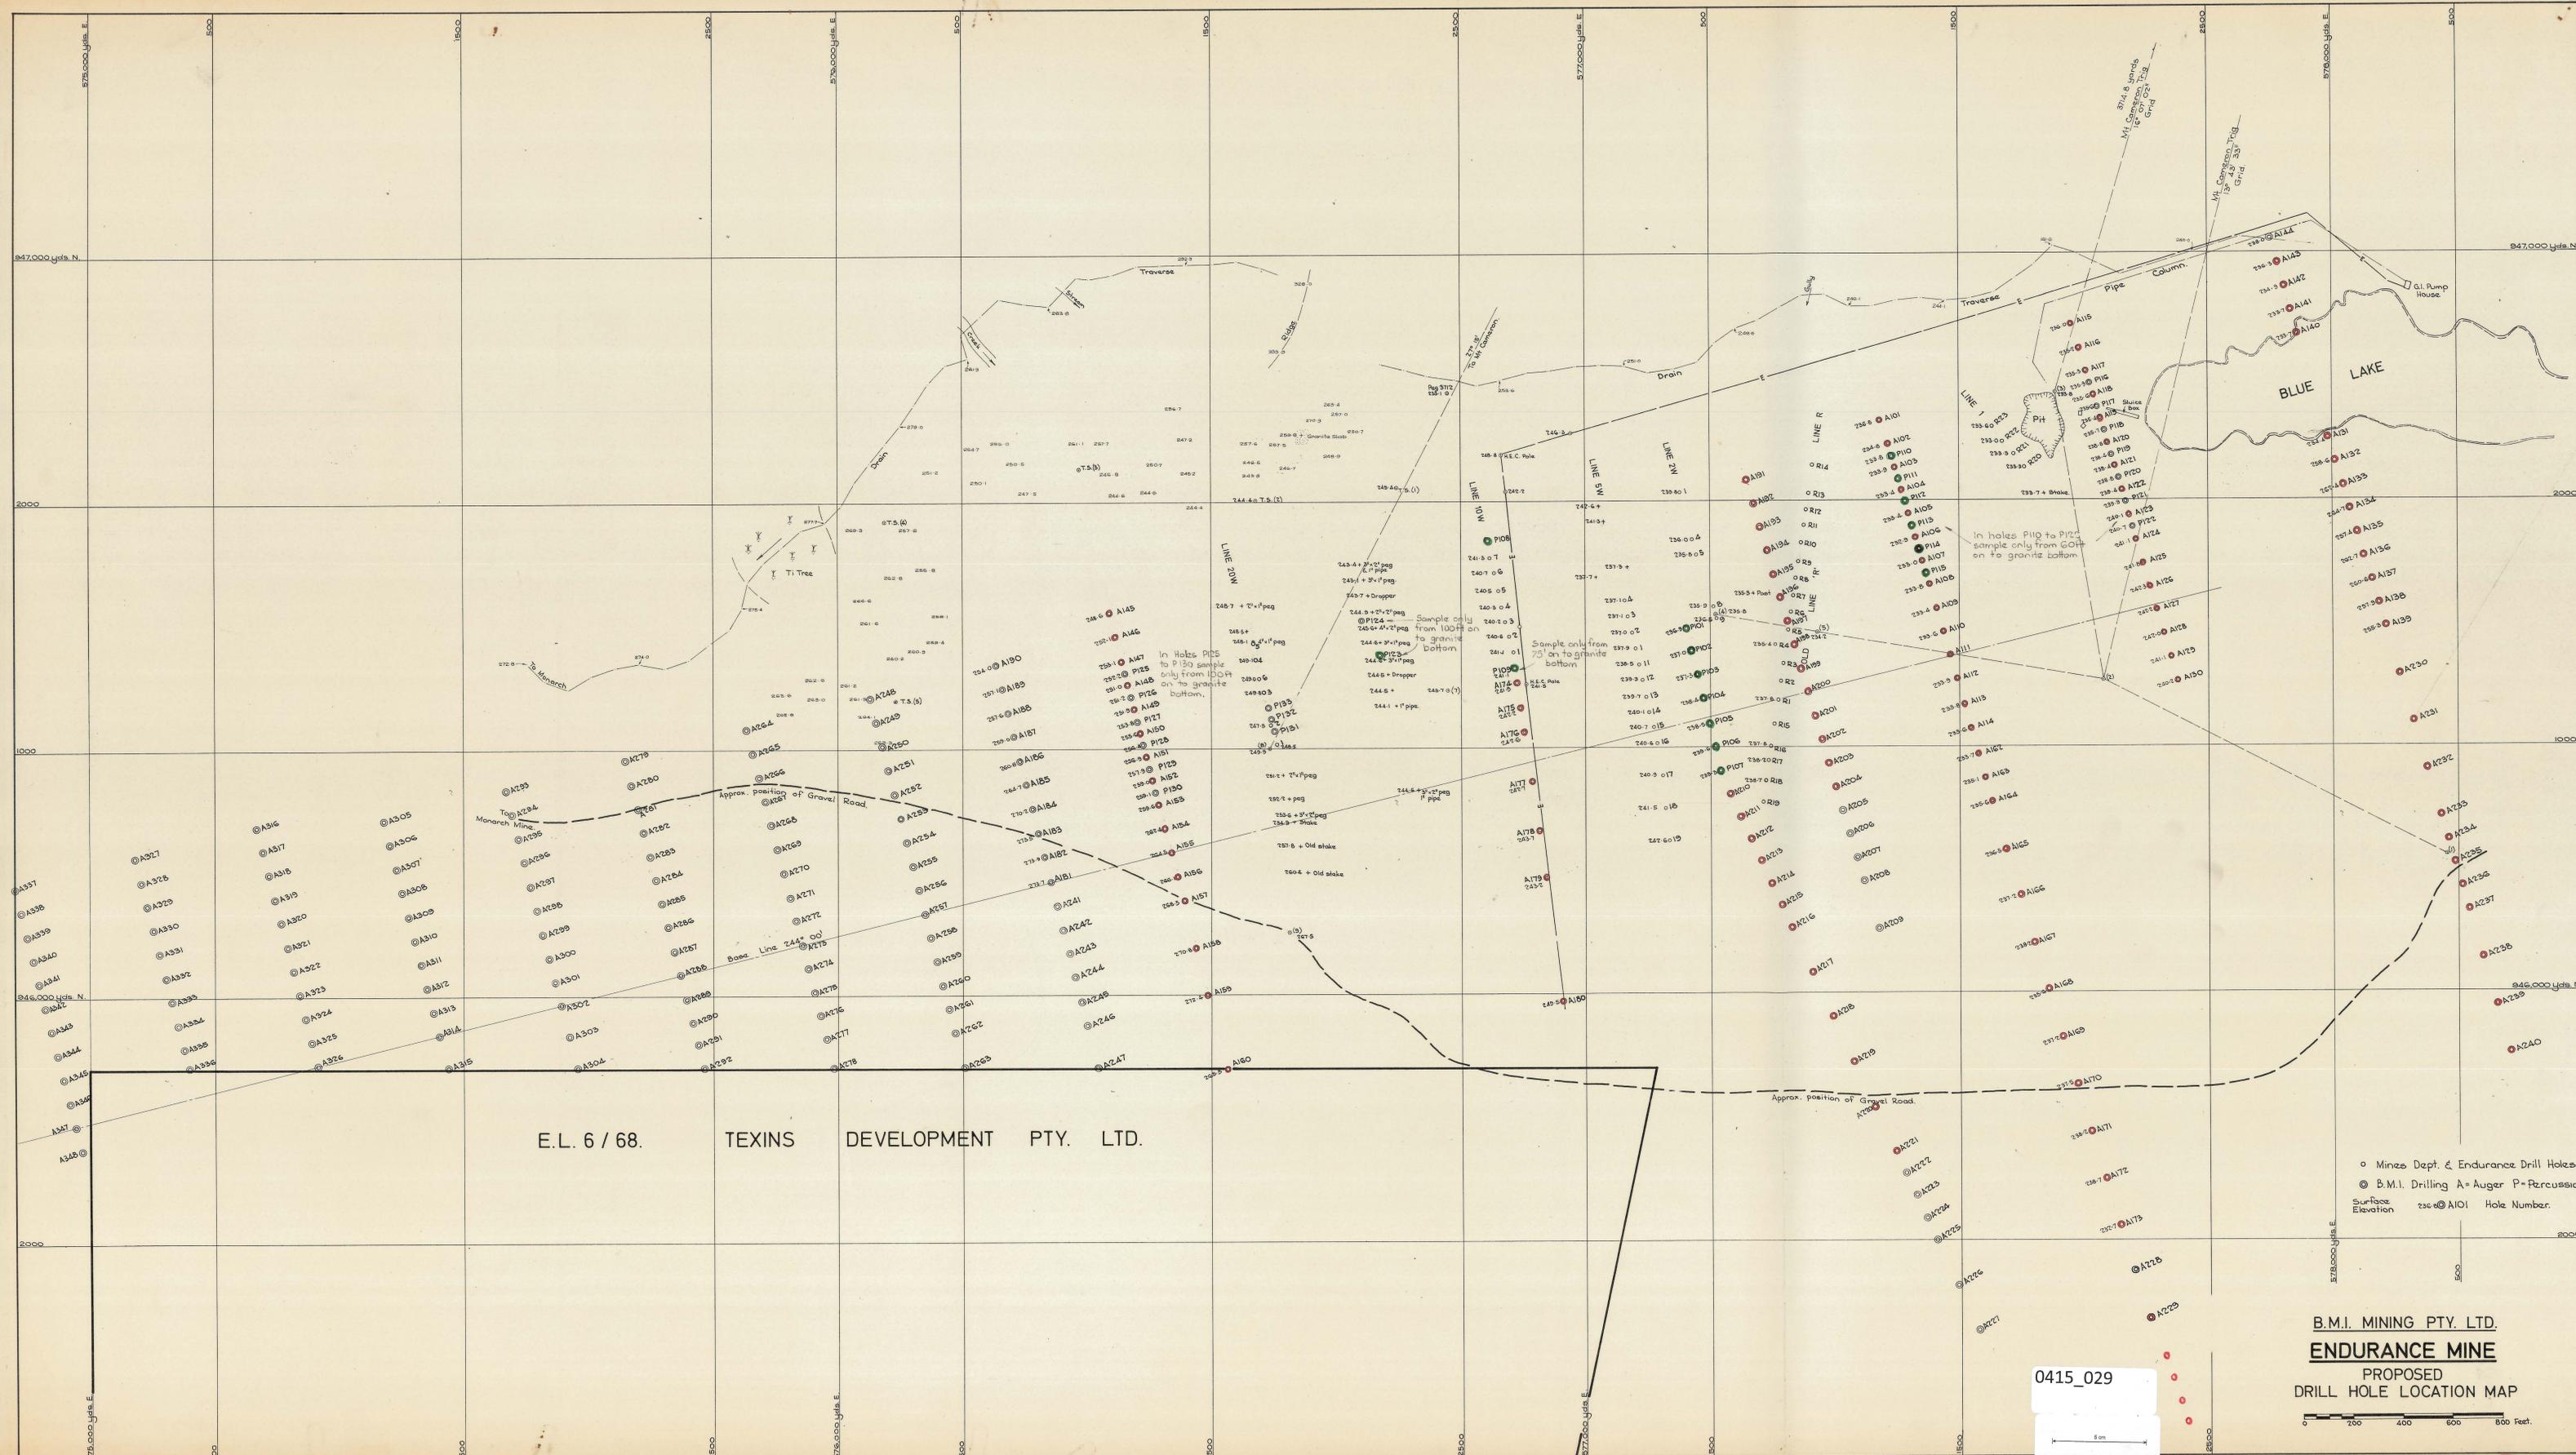

E.L. 6 / 68. TEXINS DEVELOPMENT PTY. LTD.

B.M.I. MINING PTY. LTD.
ENDURANCE MINE
 PROPOSED
 DRILL HOLE LOCATION MAP

0415_029

0 200 400 600 800 Feet

○ Mines Dept. & Endurance Drill Holes
 ● B.M.I. Drilling A = Auger P = Percussion
 Surface Elevation 236 @ A101 Hole Number.