


LINE 21

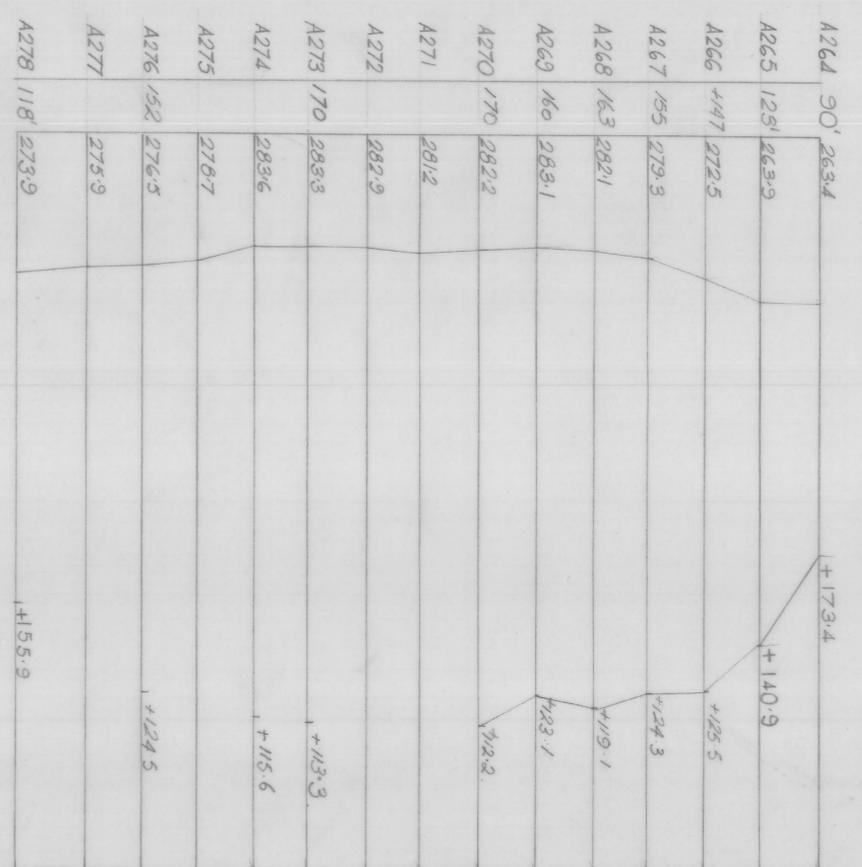

LINE 22

Datum 60.00

DRILLING PROGRESS
ENDURANCE MINE
CROSS SECTION

WEEK ENDING: 17-11-70

Scales: Vert. 1" = 40'-0"
Hor. 1" = 200'-0"

