




LINE 10W

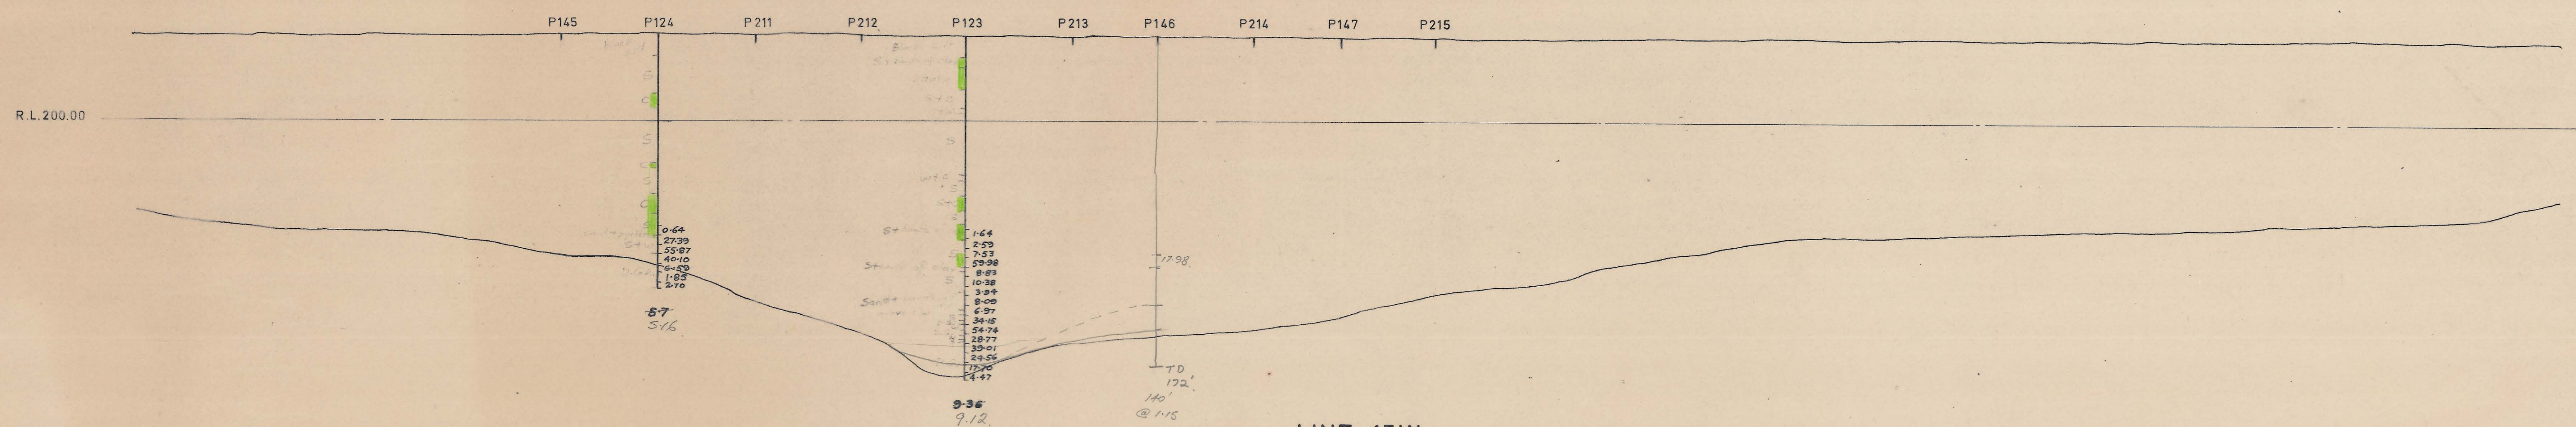

LINE 15W

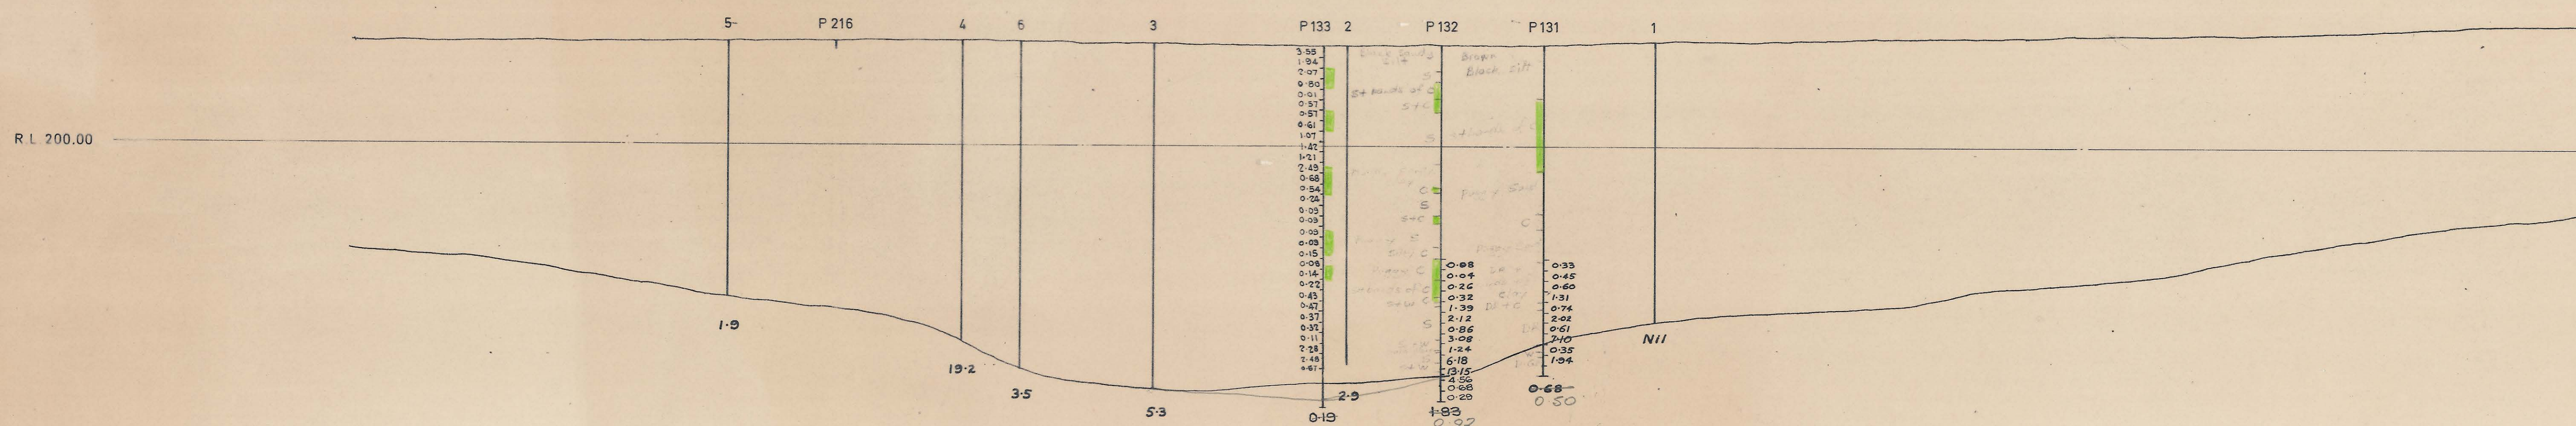

LINE 20W

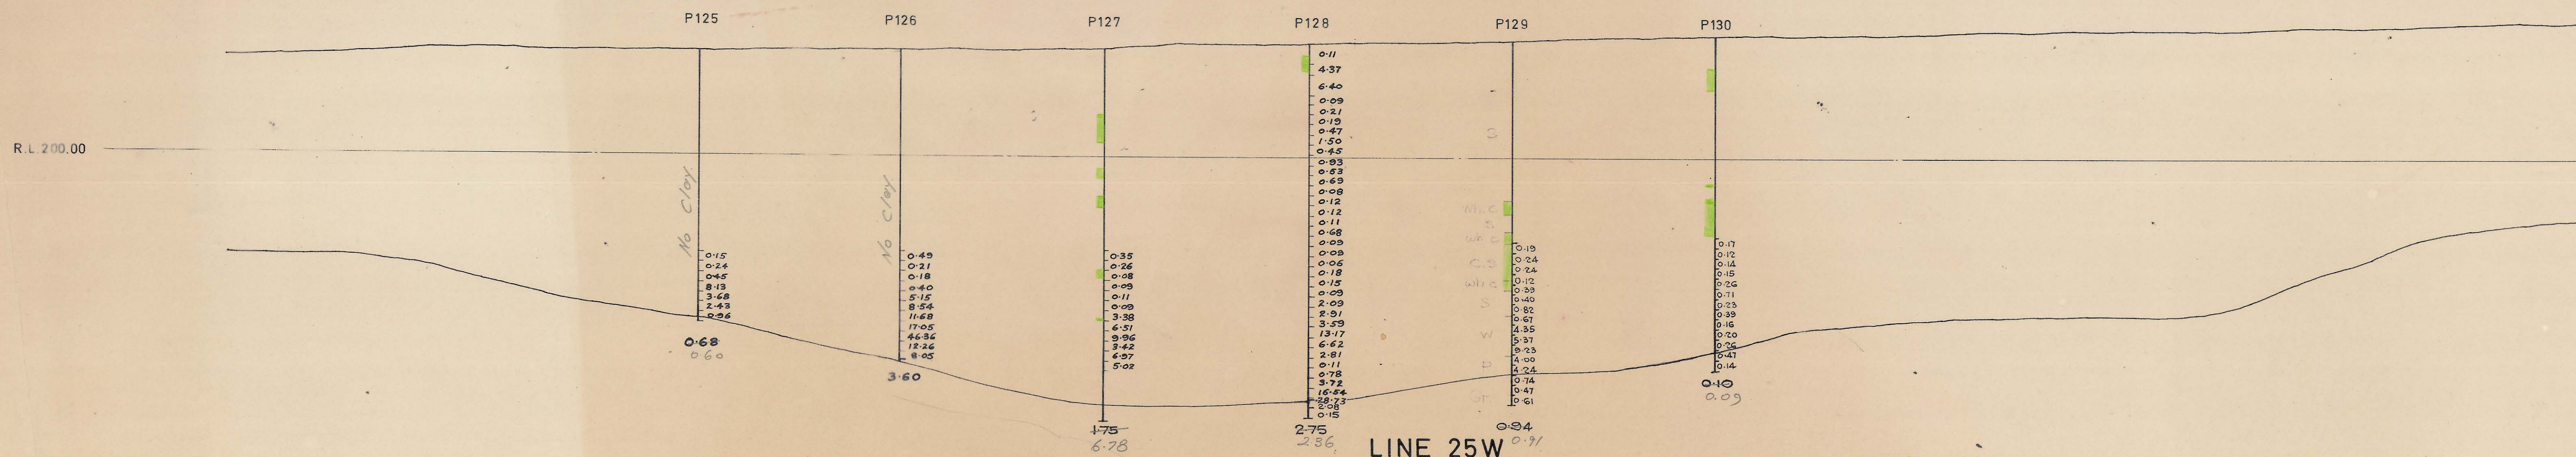

LINE 25W

0415_047

5 cm

B.M.I. MINING PTY. LTD.
ENDURANCE MINE

CROSS SECTIONS
SHEET 2

SCALE 1IN. TO 40 FT.

MARCH 1972

0415_047

0415_047