


61

0415_058

5 cm
0415-058

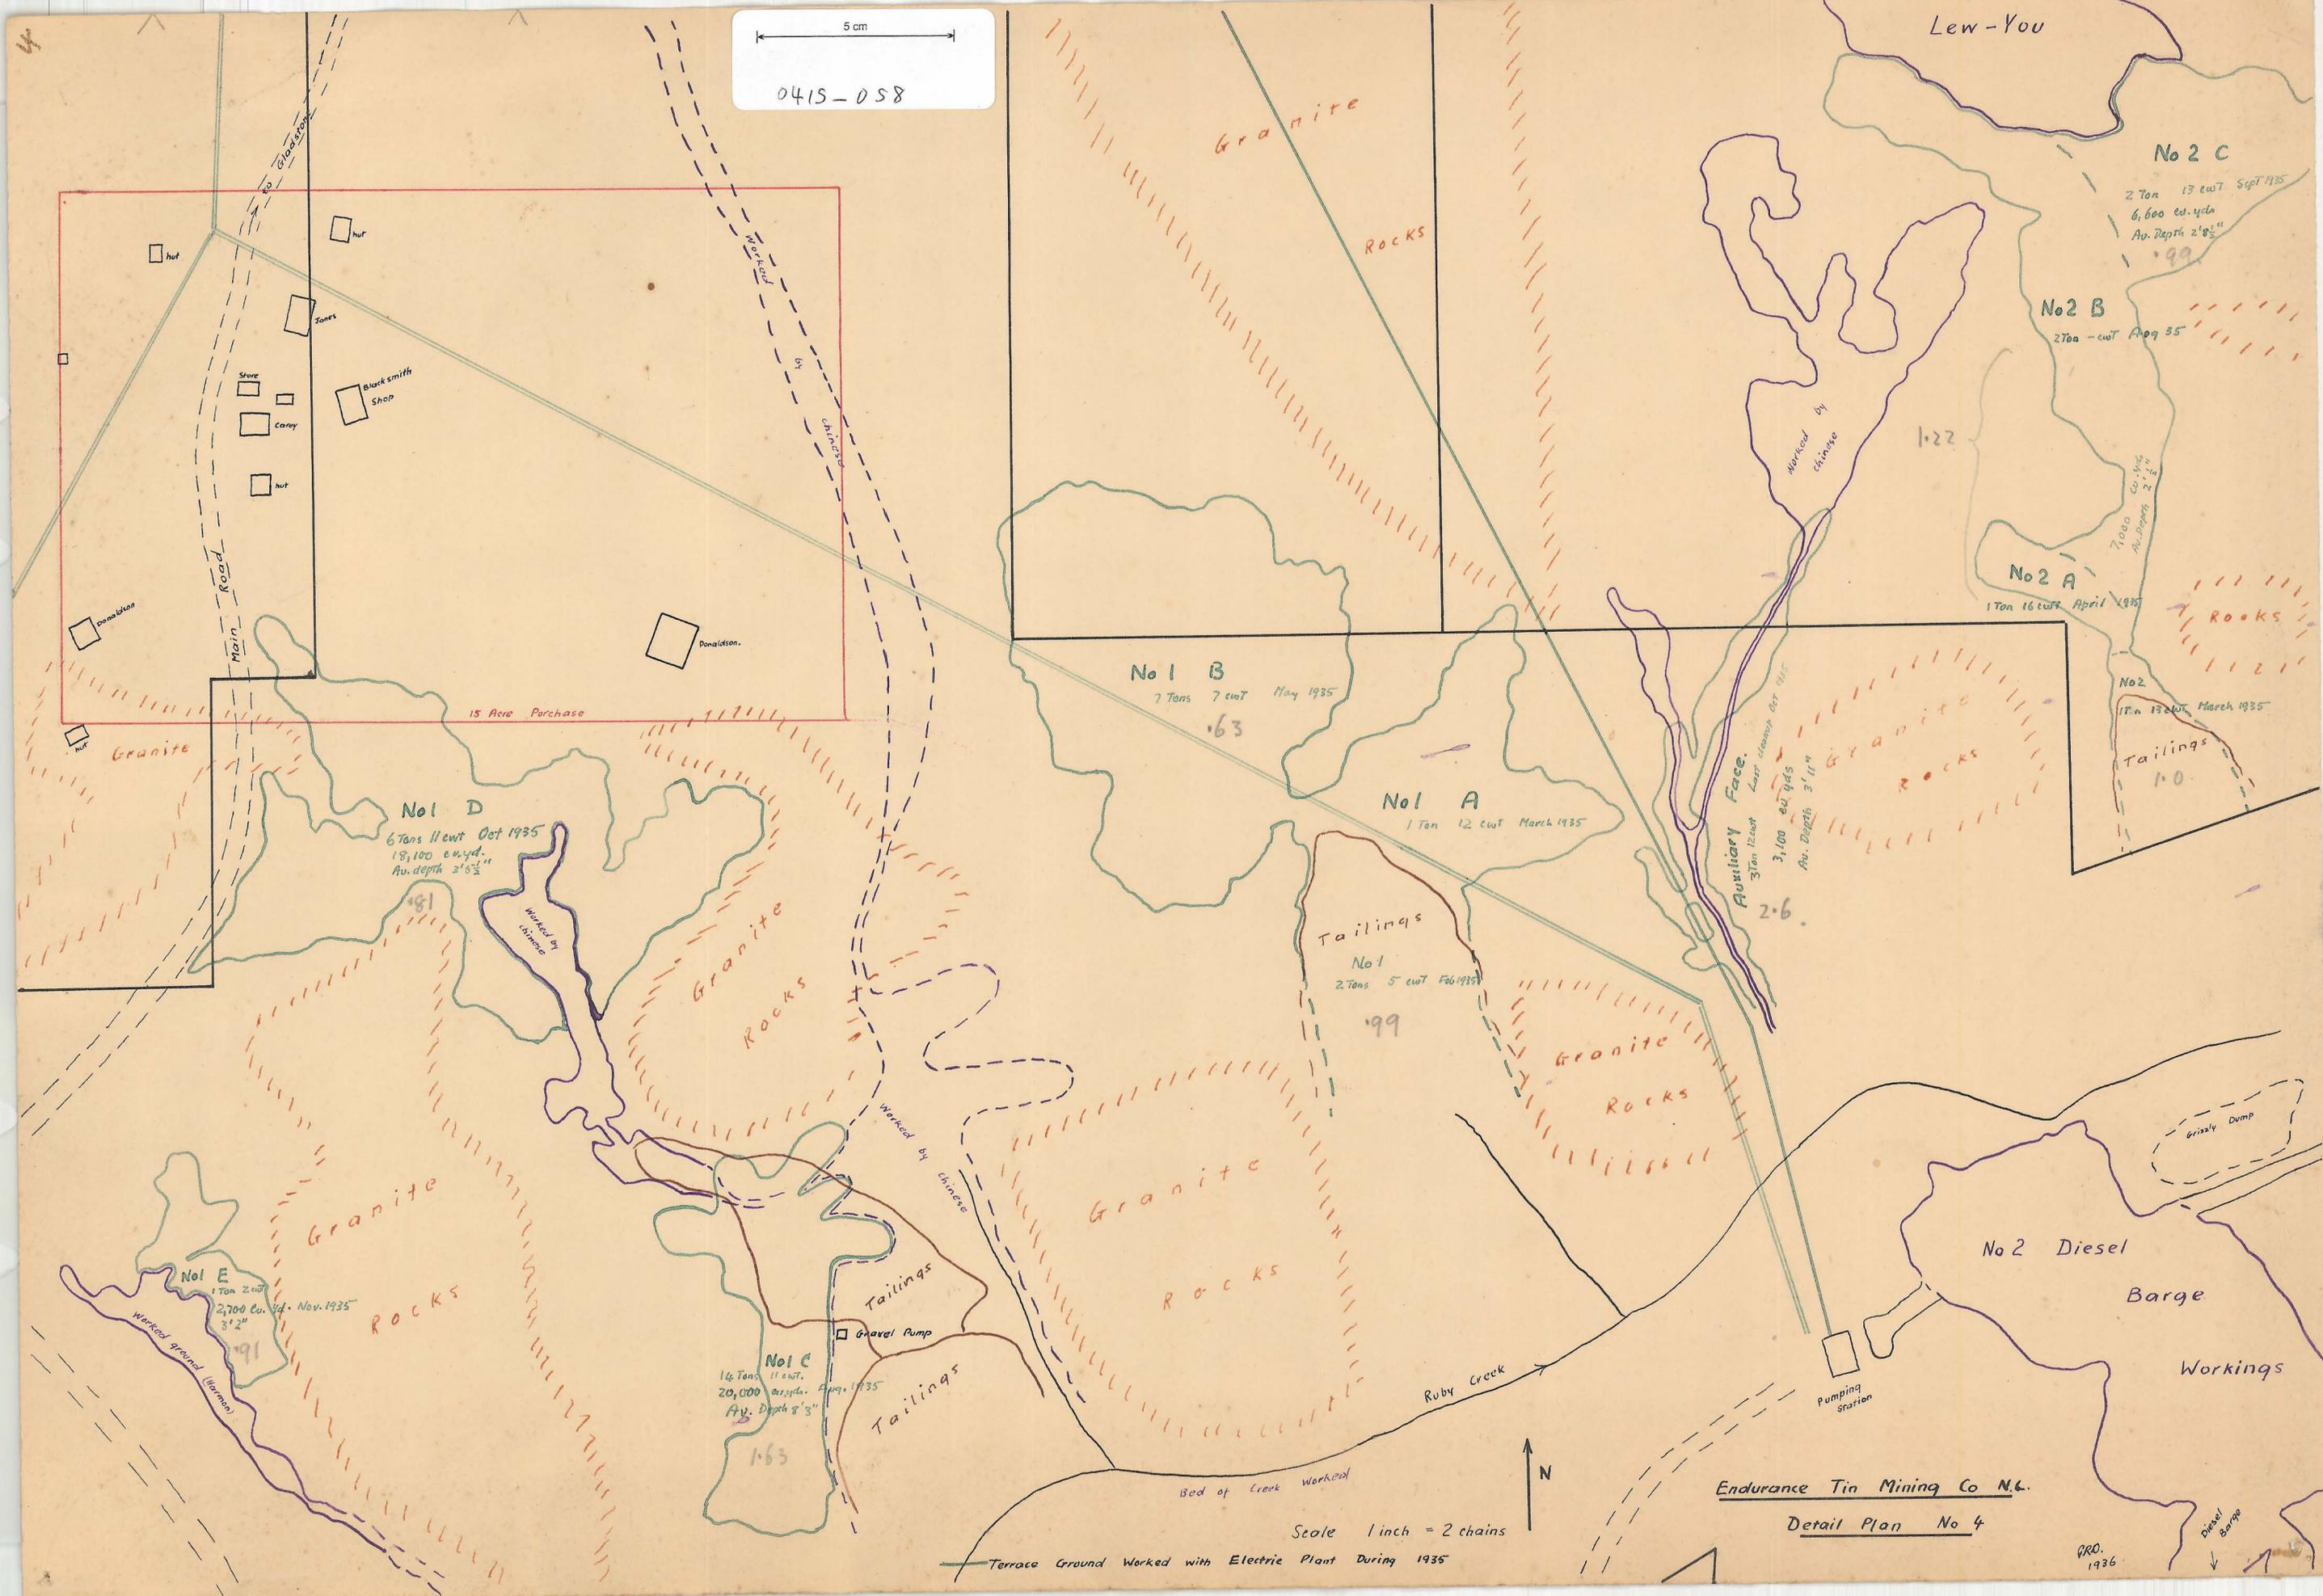

Scale 1 inch = 2 chains
Terrace Ground Worked with Electric Plant During 1935

Endurance Tin Mining Co N.G.
Detail Plan No 4

PRO.
1936