


Old Clifton

Worked to false bottom on Southern Side

Marked to false bottom

Pan Slashed away

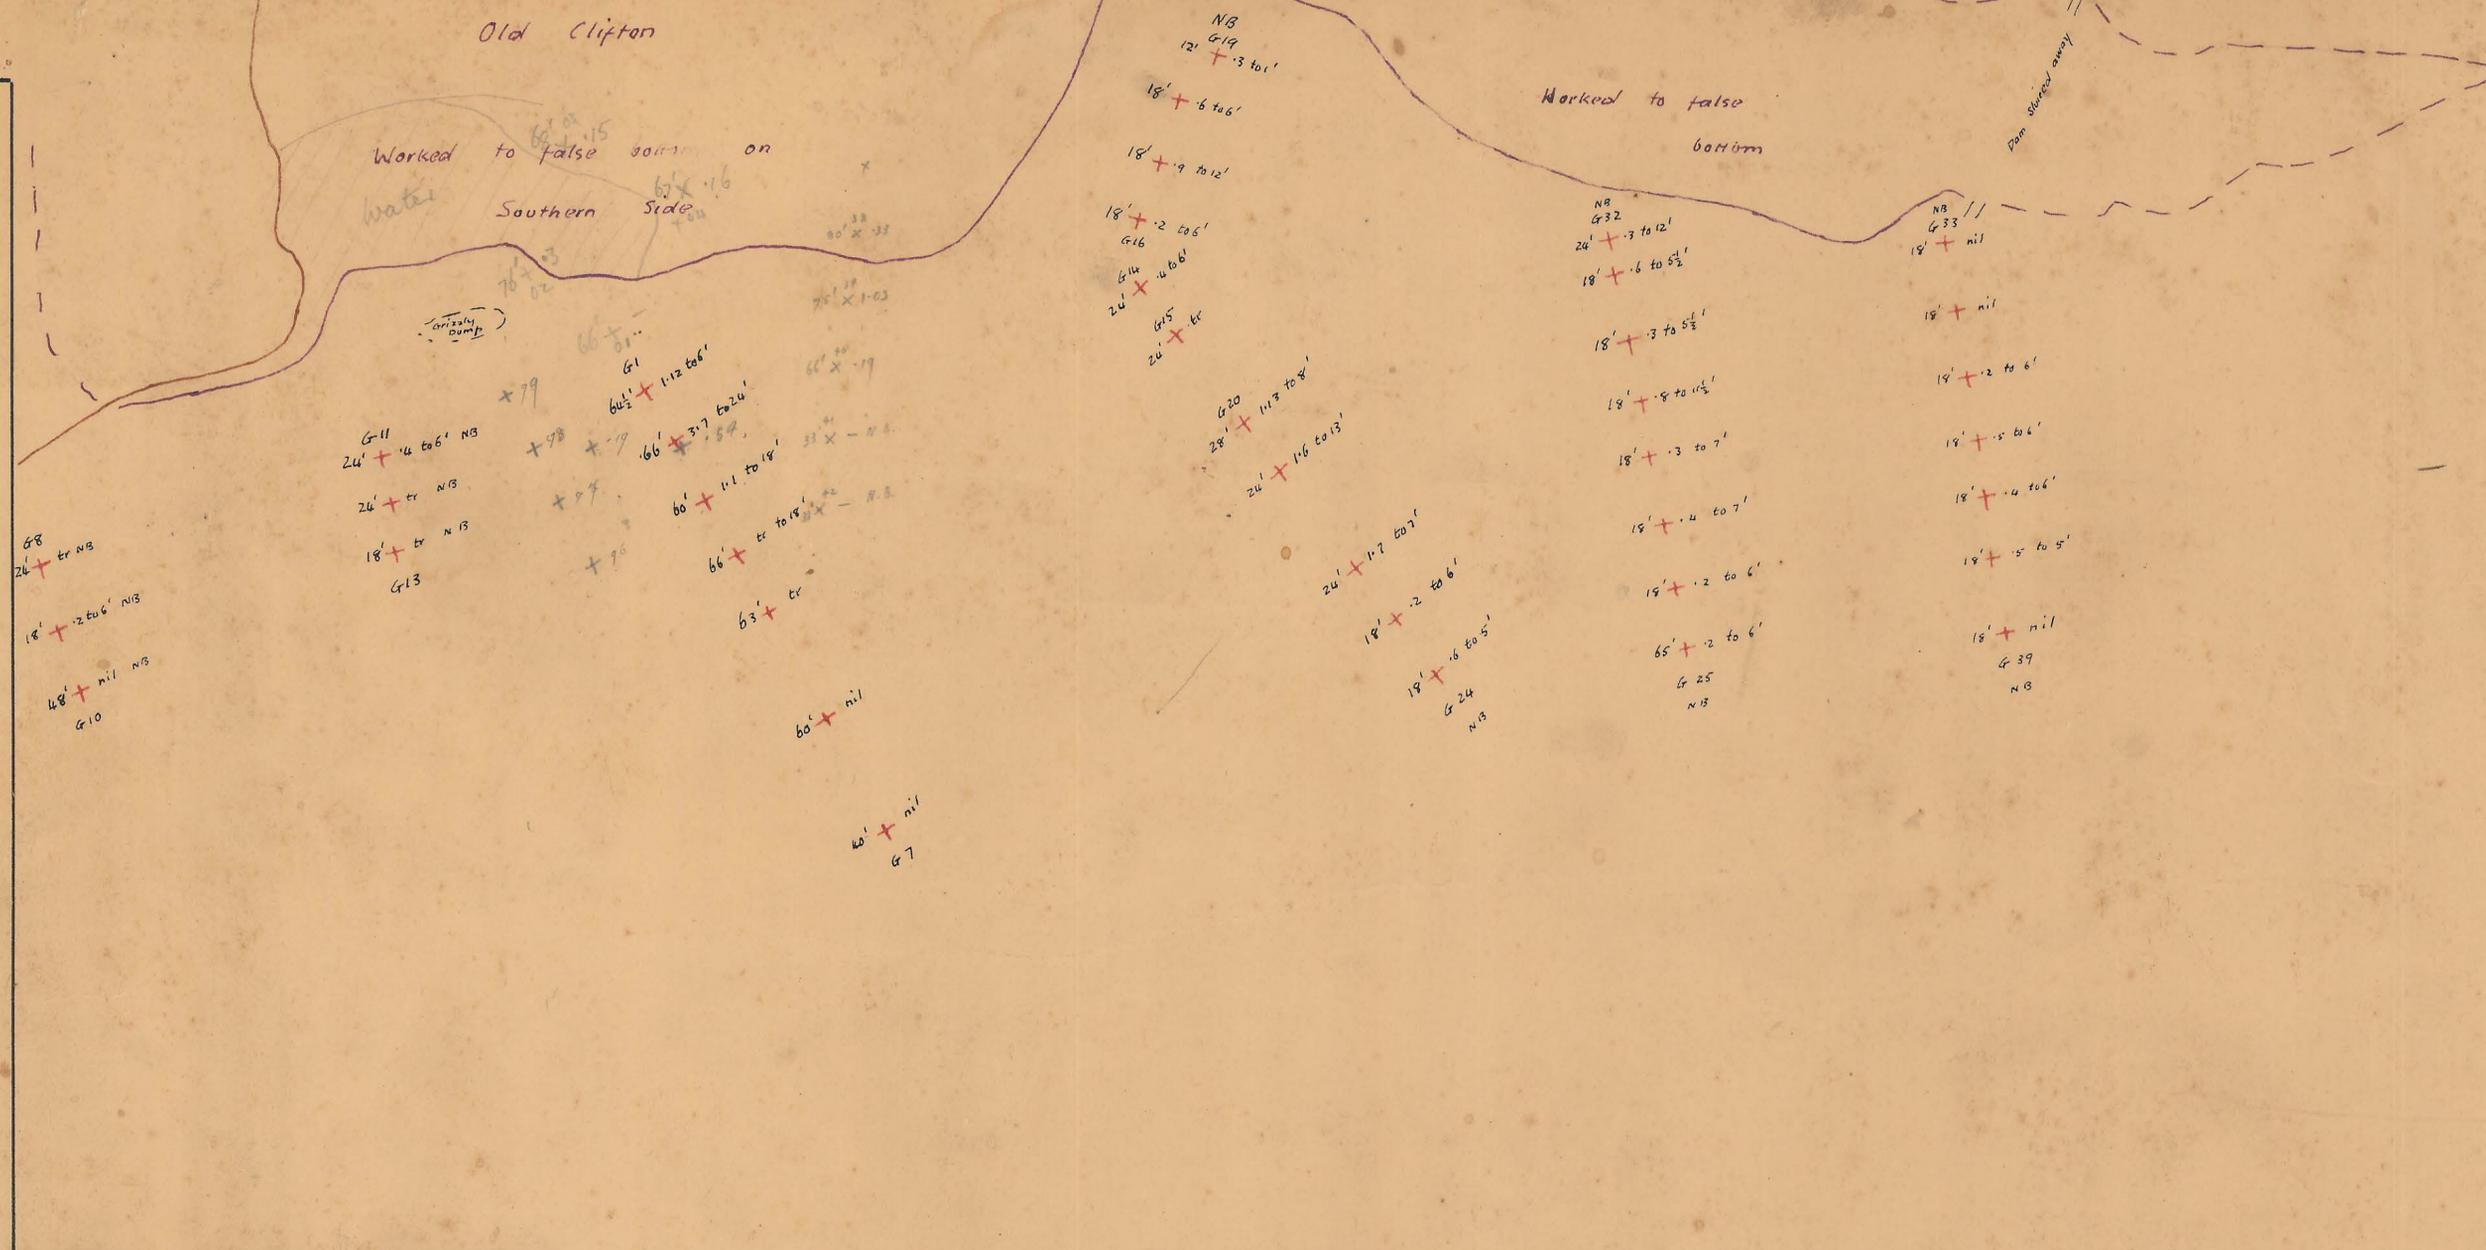

G8
24' + tr NB
18' + .2 to 6' NB
48' + nil NB
G10

G11
24' + .4 to 6' NB
24' + tr NB
18' + tr NB
G13

G1
60 1/2' + 1.12 to 6'
G12
66' + 3.7 to 24'
66' + 1.1 to 19'

66' + tr to 18'

63' + tr

60' + nil

60' + nil
G7

NB
G14
12' + .3 to 1'
18' + .6 to 6'
18' + .9 to 12'
18' + .2 to 6'
G16
24' + .4 to 6'
G15
24' + tr

G20
28' + 1.17 to 8'
24' + 1.6 to 13'

24' + 1.7 to 7'

18' + .2 to 6'

18' + .6 to 5'
G24
NB

NB
G32
24' + .3 to 12'
18' + .6 to 5 1/2'

18' + .3 to 5 1/2'

18' + .8 to 1 1/2'

18' + .3 to 7'

18' + .4 to 7'

18' + .2 to 6'

65' + .2 to 6'
G25
NB

NB
G33
18' + nil

18' + nil


18' + .2 to 6'

18' + .5 to 6'

18' + .4 to 6'

18' + .5 to 5'

18' + nil
G29
NB

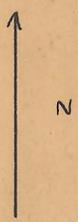

0415_060

Endurance Tin Mining Co NL

Detail Plan No 5

scale 1 inch = 2 chains

1:1584

5 cm

+ "G" Bores J. Carey. Aug 1935.

o Bores by J. Carey before 1935



5 more bores all false

6/20/1936

0415_060

62