


5 cm

0415_062

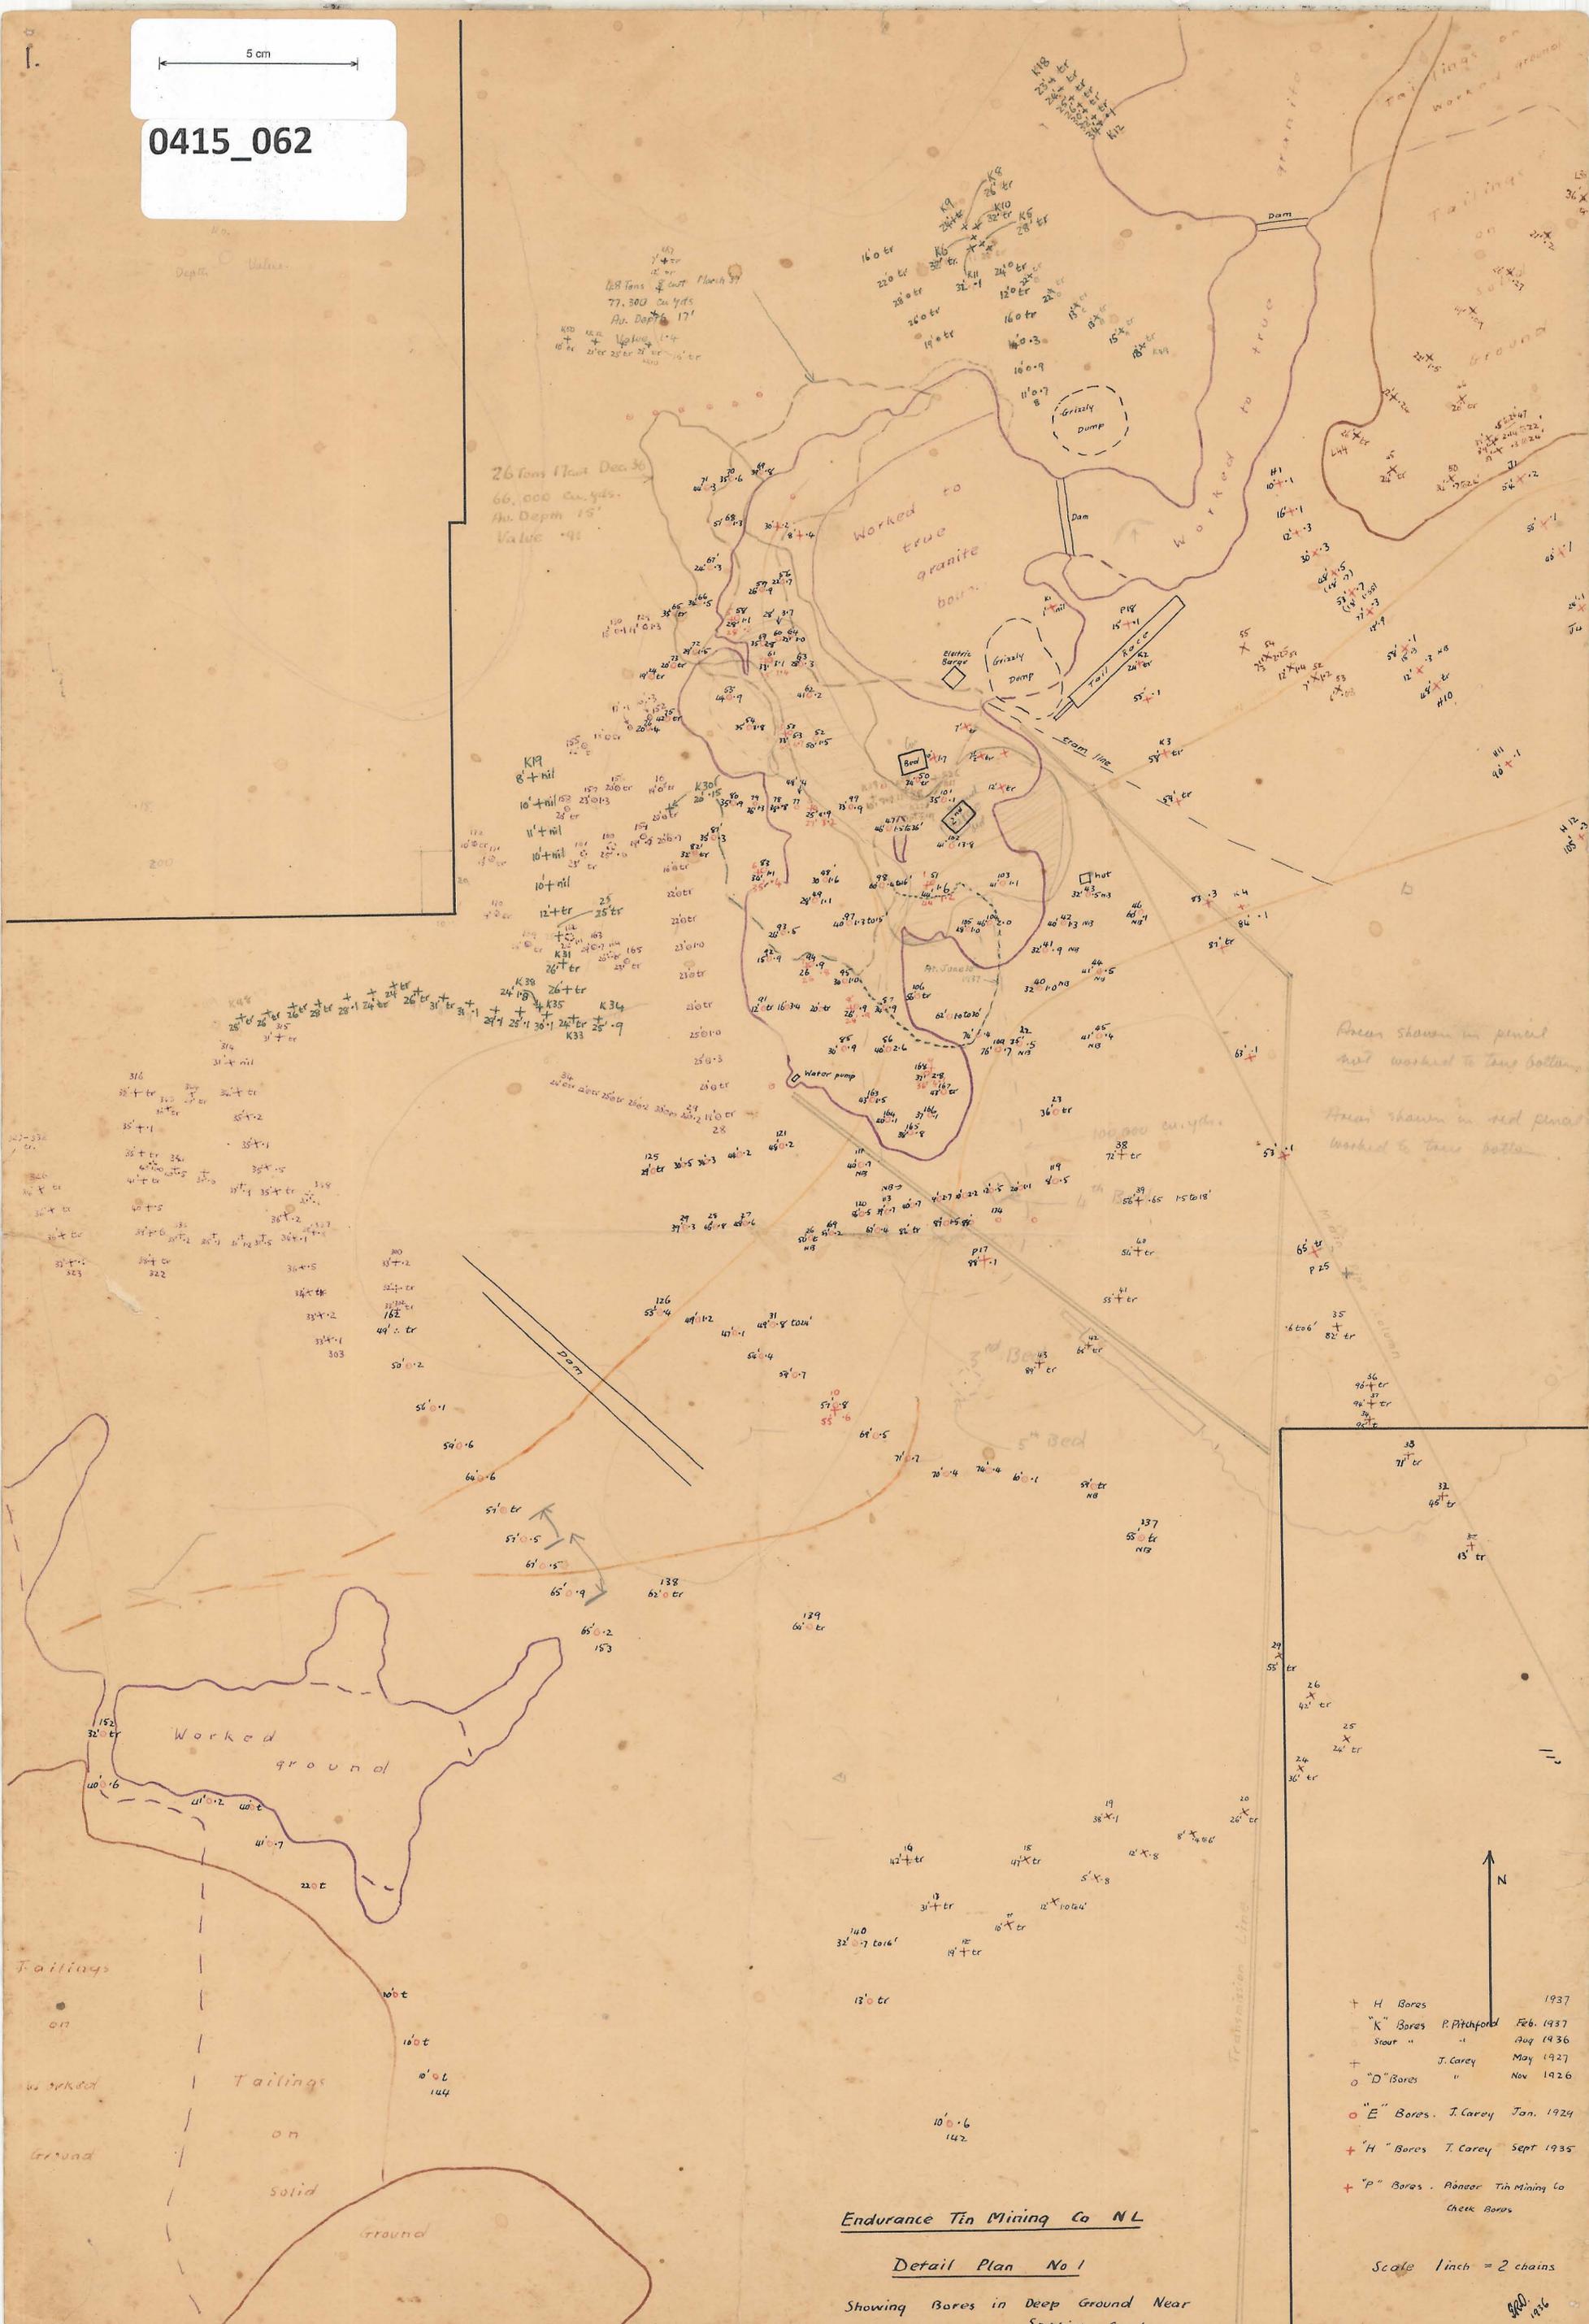

Area shown in pencil
not worked to true bottom

Area shown in red pencil
worked to true bottom

- + H Bores 1937
- + K Bores P. Pitchford Feb. 1937
- + Saur " " Aug. 1936
- + J. Carey May 1927
- + "D" Bores " Nov 1926
- + "E" Bores J. Carey Jan. 1929
- + "H" Bores J. Carey Sept 1935
- + "P" Bores Pioneer Tin Mining Co
Chick Bores

Endurance Tin Mining Co NL

Detail Plan No 1

Showing Bores in Deep Ground Near Sapphire Creek

Scale 1 inch = 2 chains

1936