



0415\_064



0415\_064

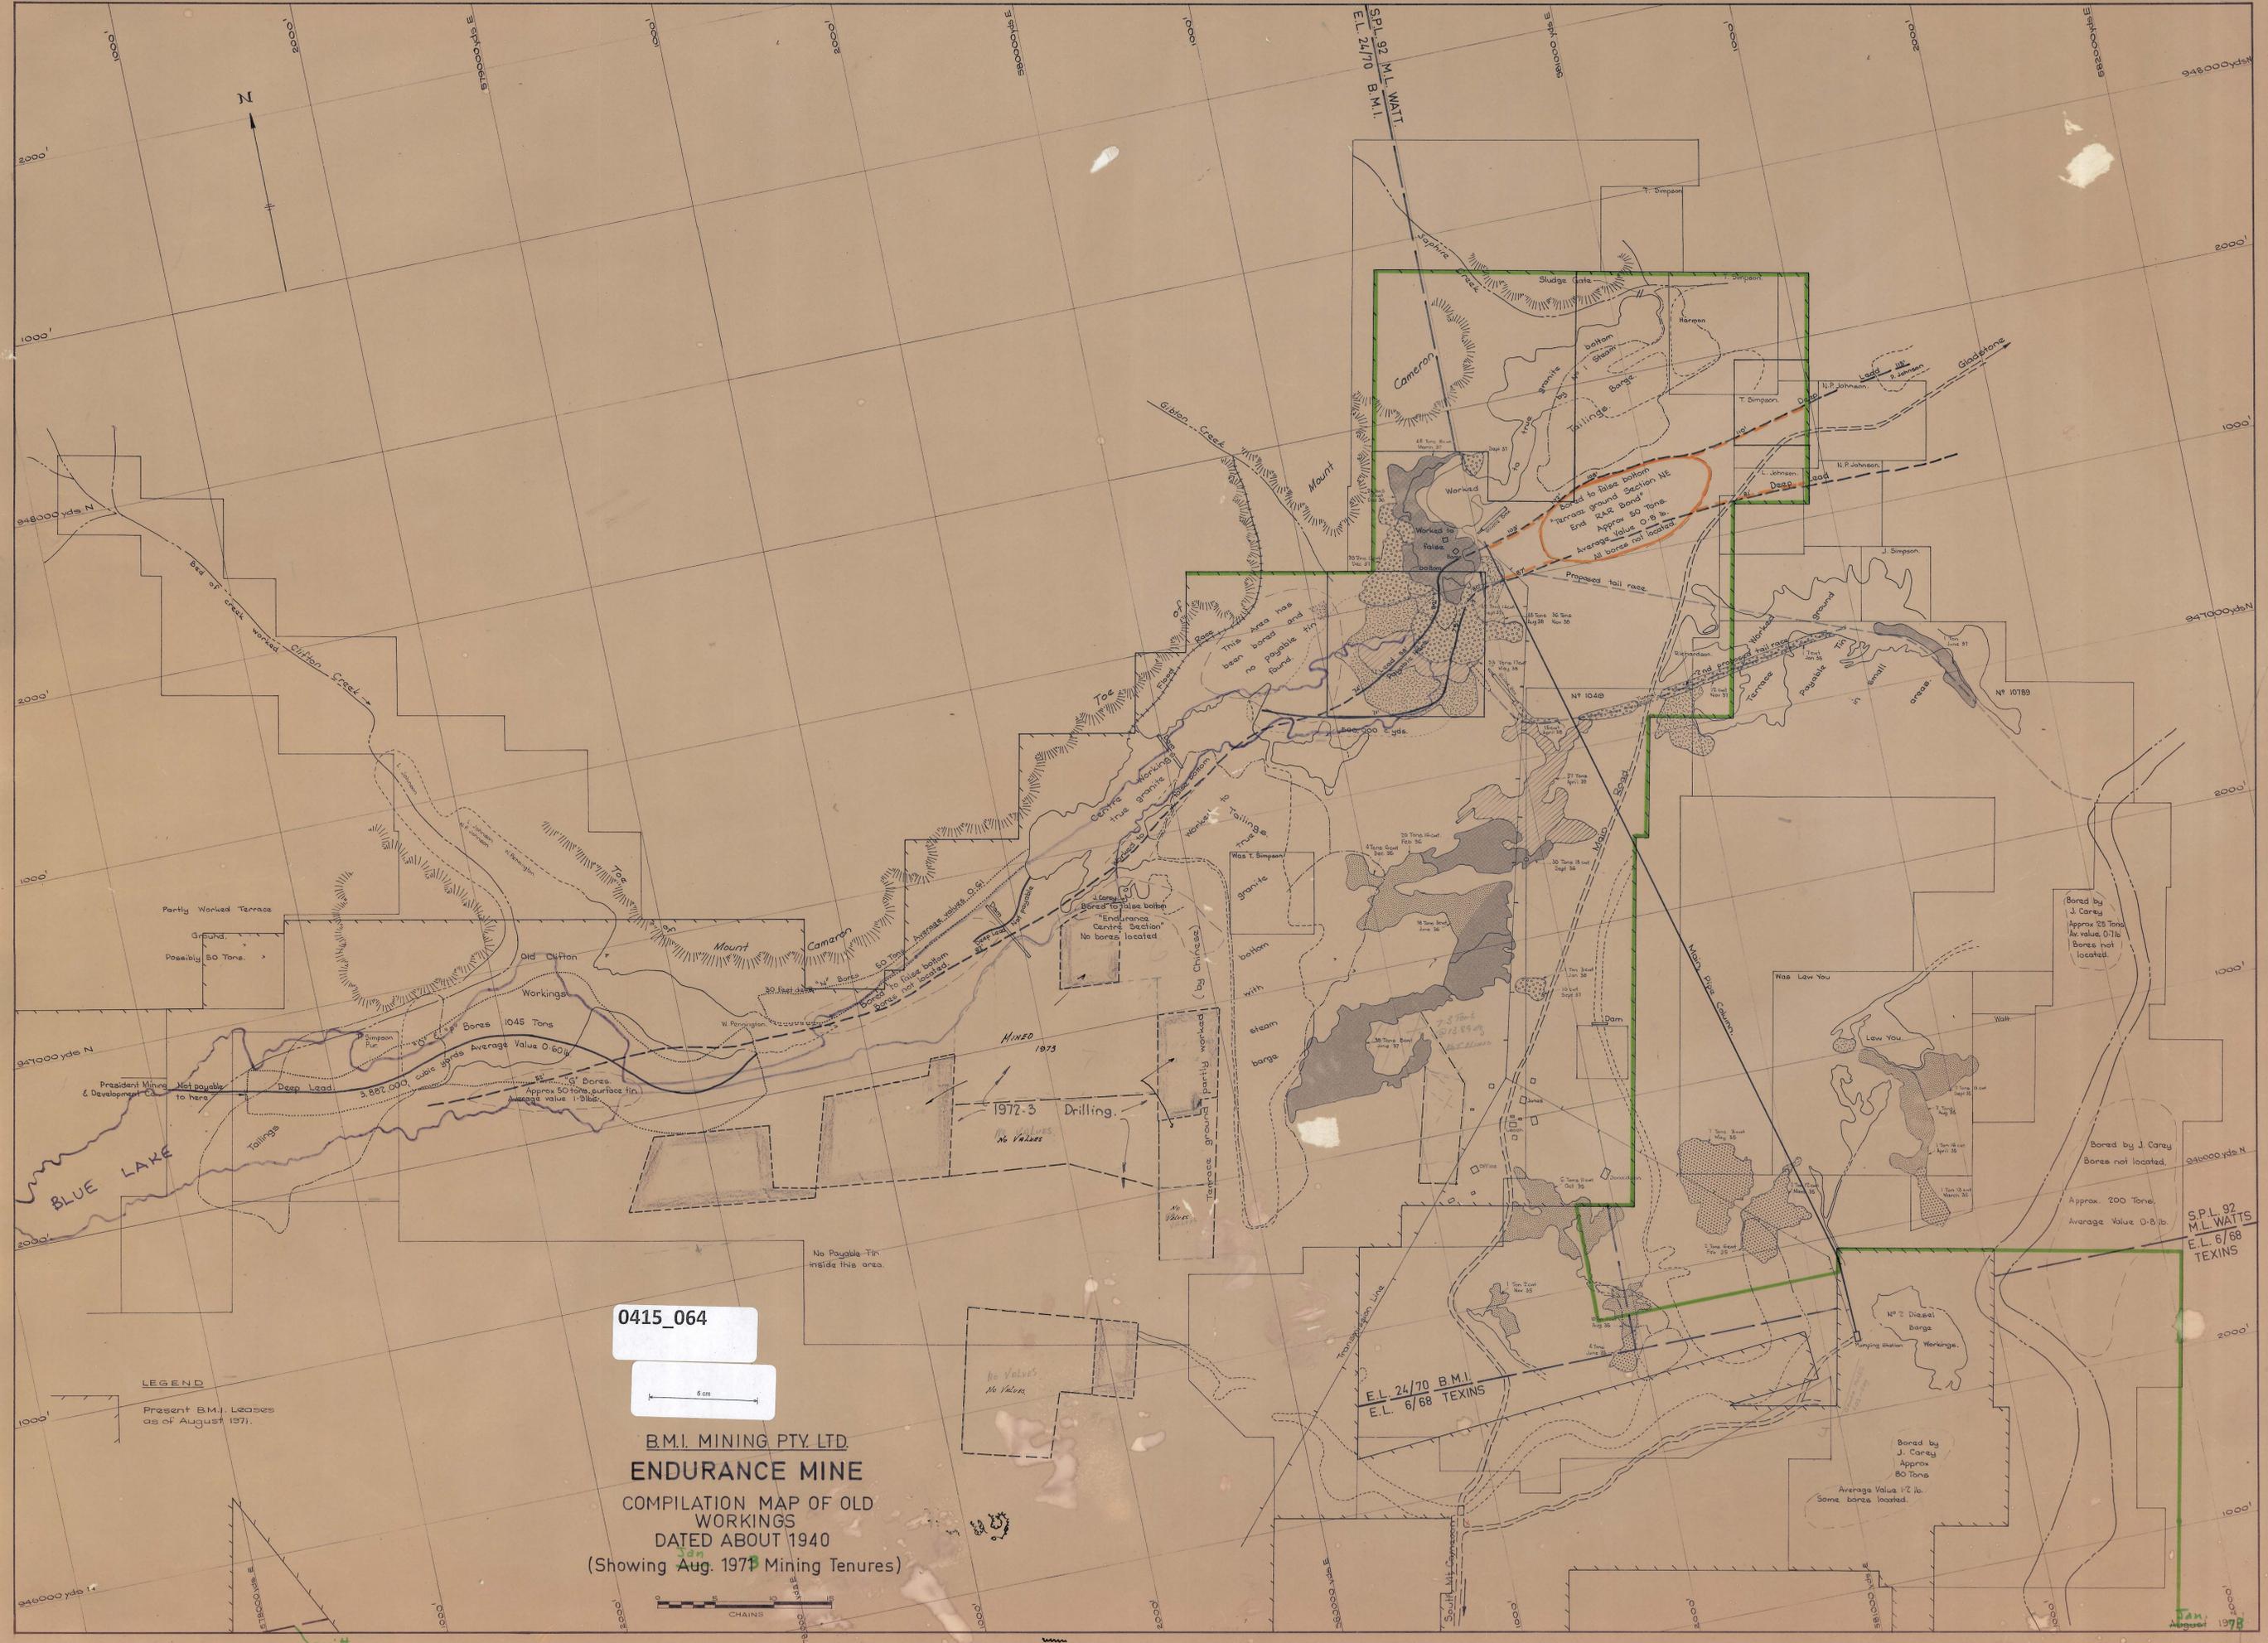

**B.M.I. MINING PTY. LTD.**  
**ENDURANCE MINE**  
 COMPILATION MAP OF OLD WORKINGS  
 DATED ABOUT 1940  
 (Showing Aug. 1973 Mining Tenures)

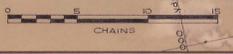

**LEGEND**  
 Present B.M.I. Leases as of August 1971.

Bored to false bottom  
 Approx ground Section NE  
 End Approx 50 Tons  
 Average Value 0.8 lb  
 All boro not located

1972-3 Drilling  
 No Values

S.P.L. 92  
 M.L. WATTS  
 E.L. 6/68  
 TEXINS

1973