
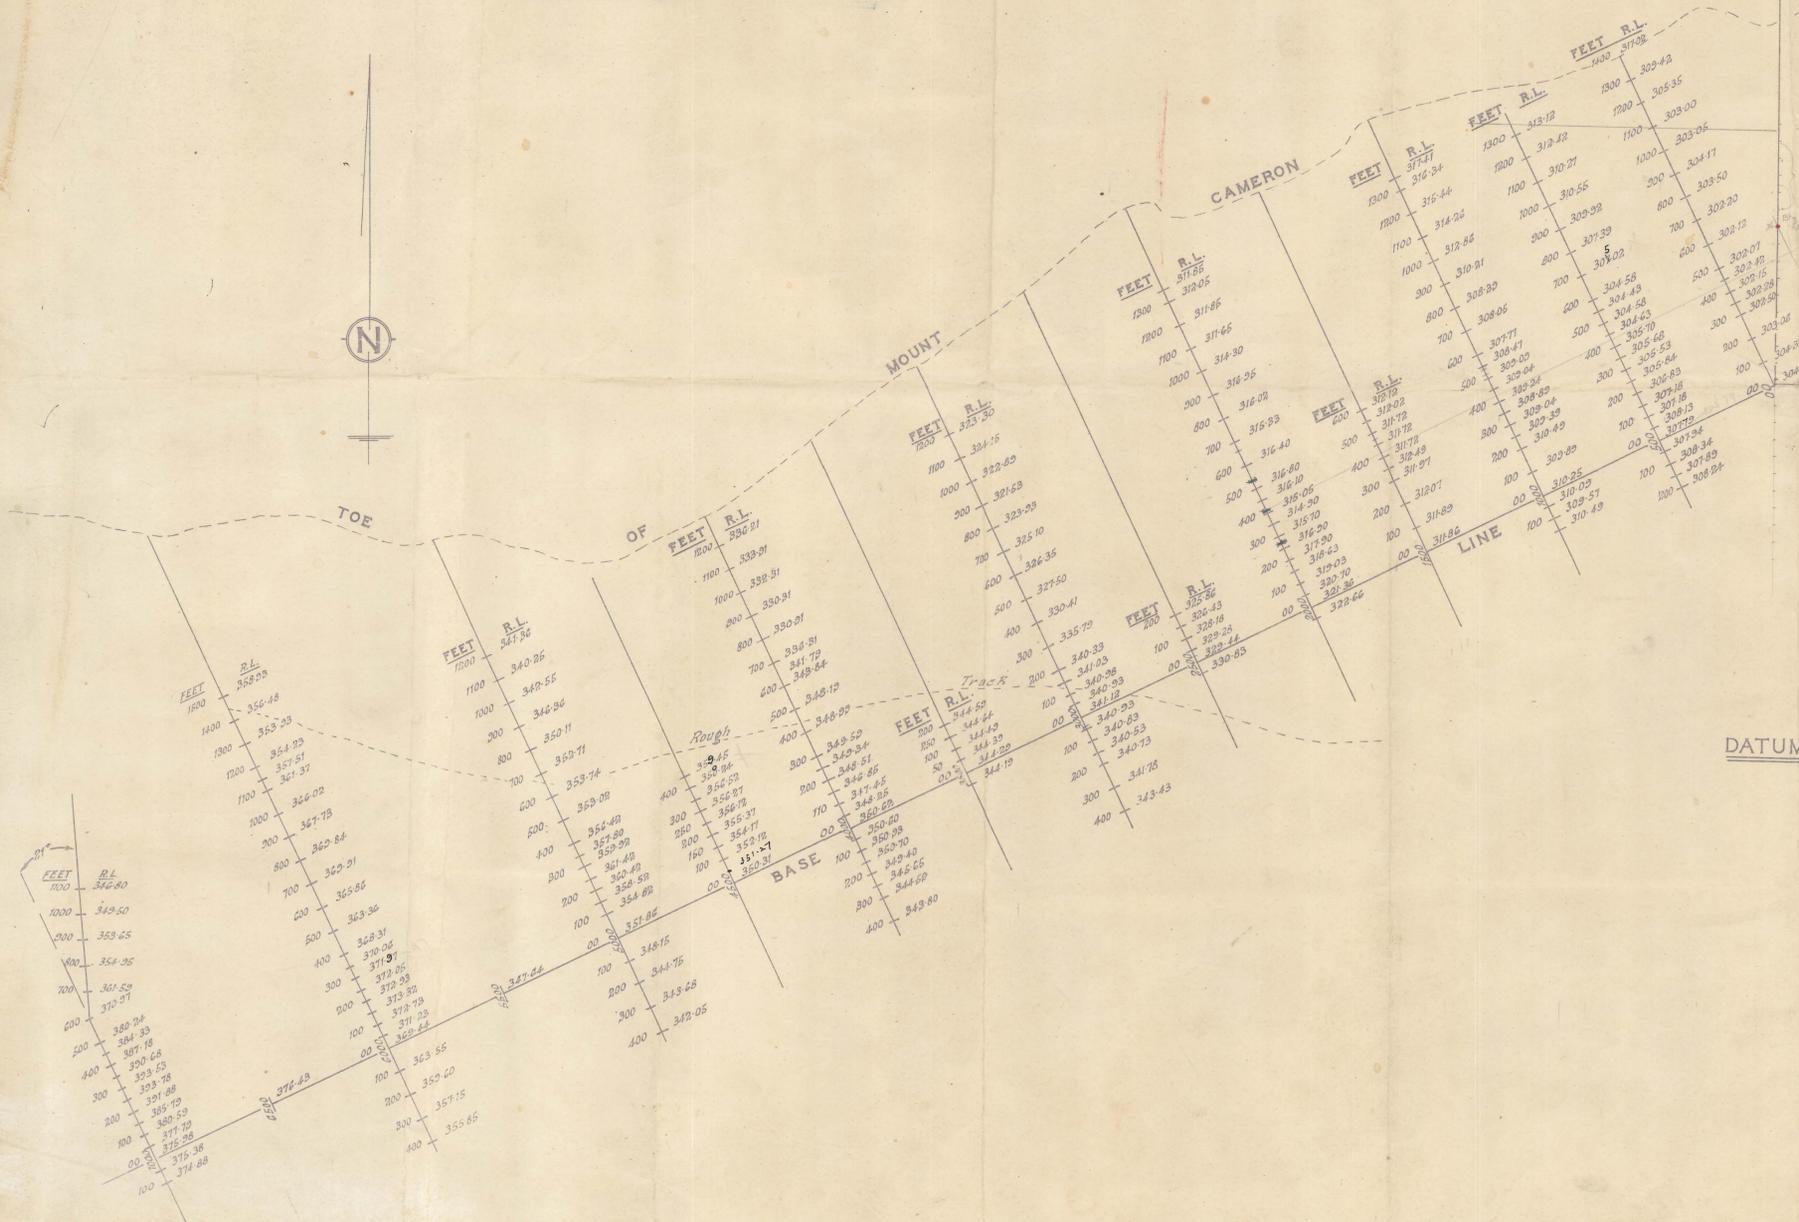


ENDURANCE TIN MINING CO. N.L.
SOUTH MOUNT CAMERON

PLAN SHOWING LEVELS TAKEN OVER AREA
TO S. W. OF LEASE 42M
51


SCALE 300 FEET TO AN INCH

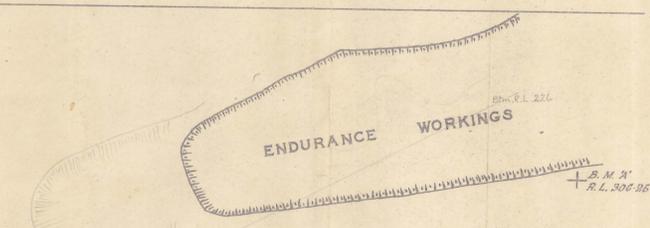

DATUM FOR LEVELS B.M. A 306.25'

R. Campbell
AUTHORISED SURVEYOR
March 1952

0415_068

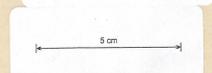

0415_068