



0415_077

801
72

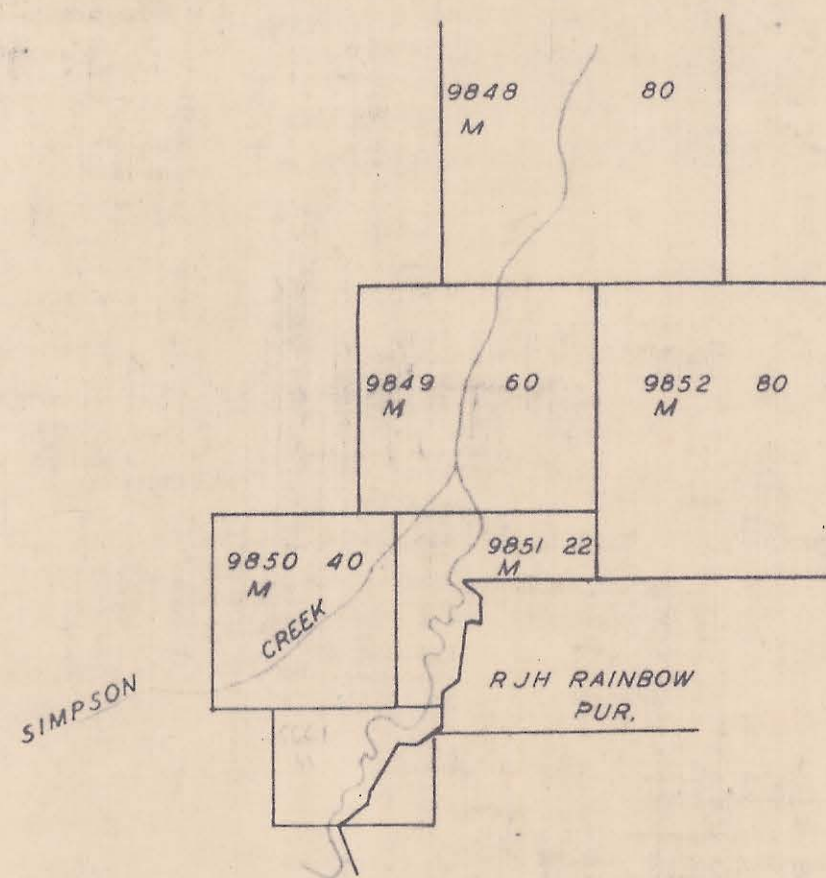

LOCALITY PLAN
SCALE 1 INCH = 20 CHAINS

previously 5633

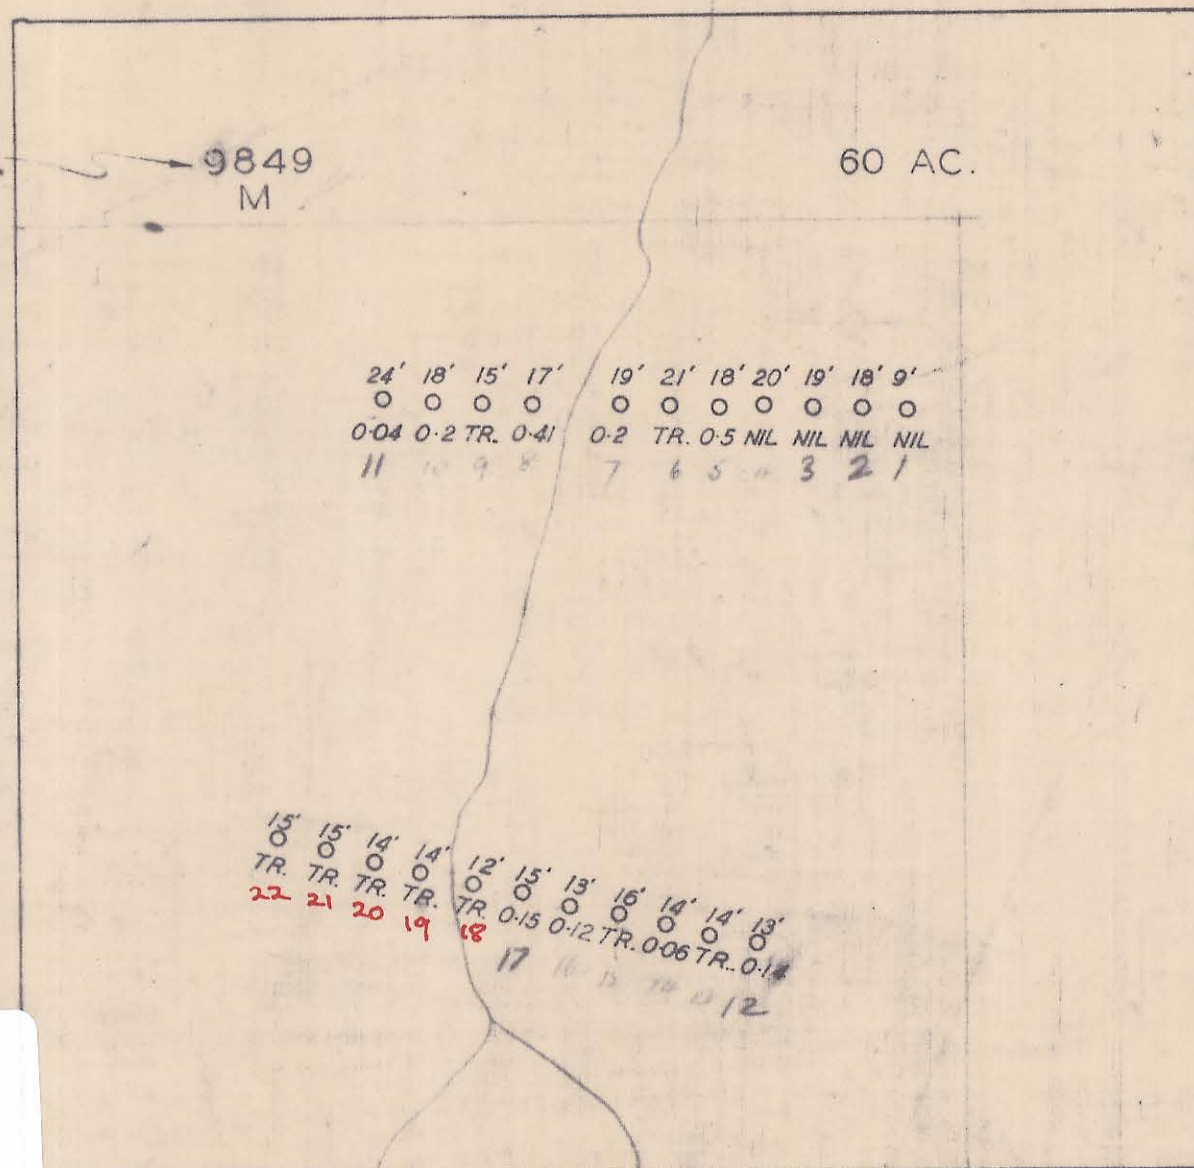

0415_077

5 cm

SKETCH PLAN
BORING SOUTH BOOBYALLA

VICINITY SIMPSON CREEK
SCALE 1 INCH = 5 CHAINS

Bored by H. Cox - Endurance Tin Mining Co. May 6 - 16th 1940.

1940