


BORE LINE 20W

Bore No	Depth	Value
1-275N	131	Nil
2-407N	152	.18
3-539N	169	.33
4-671N	134	1.20
5-737N	120	.12
6-605N	158	.22

BORE LINE R

Bore No	Depth	Value
R7	85'	.68
R8	87'	.5L
R9	87'	1.72
R10	87'	.57
R11	89'	.33

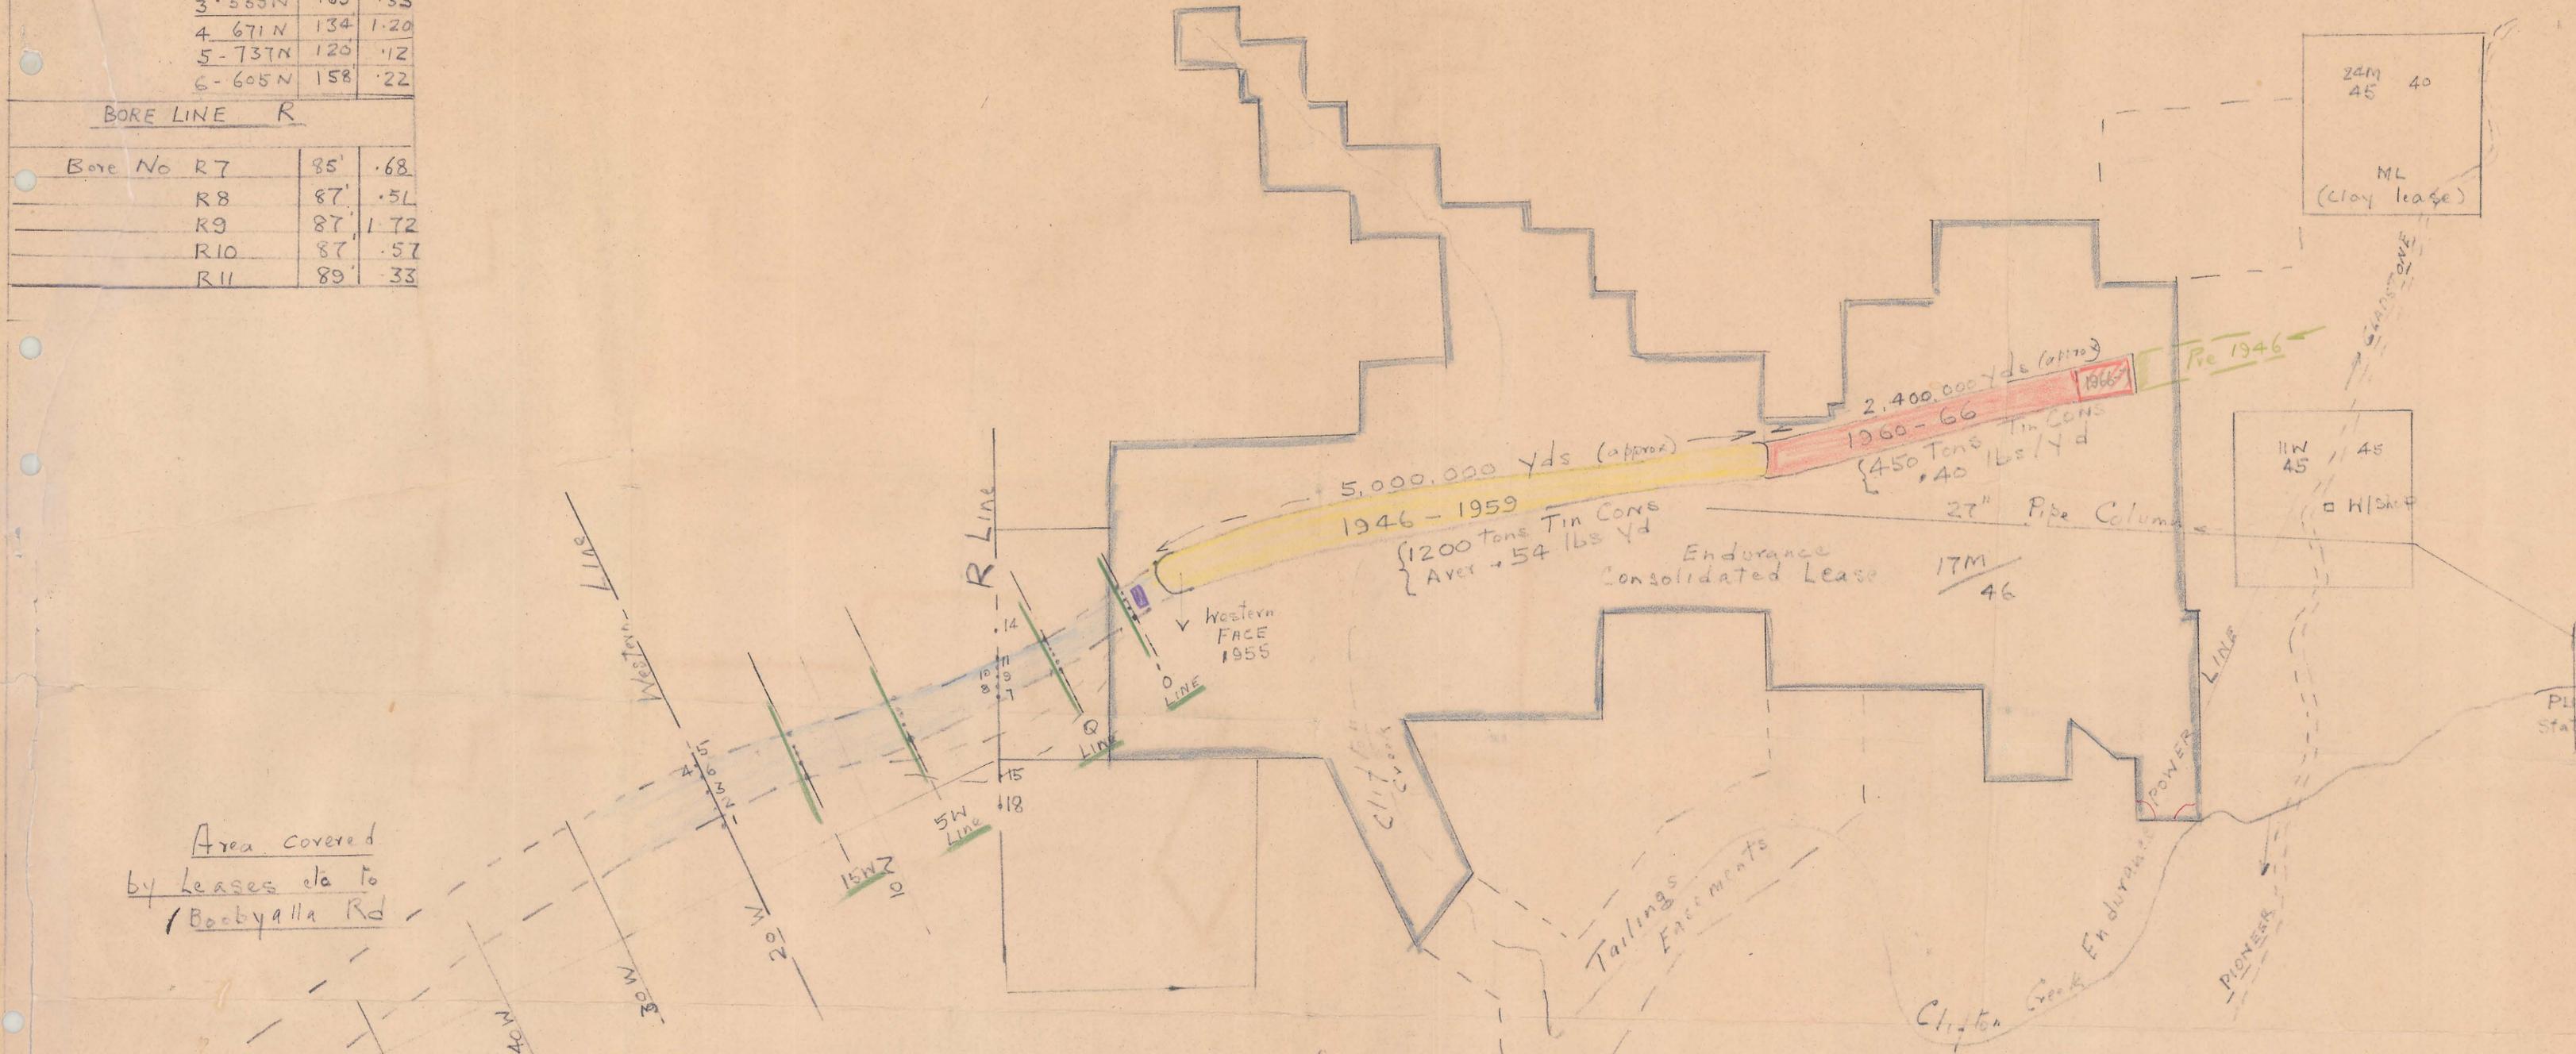

Area covered by leases da to Boobyalla Rd

Base line 244° Mag
Top

- Endurance - Main lease
- Clifton Lead - Area Worked 1946-59
- " " " " 1960-66
- " " " " Western Ext - to 20W Line
- Proposed Drill Lines - west of Old Face
- Probable sluicing point commencement 1967-8.

0382_046
0415-078
5cm

ST. MT
ENDURANCE TIN - Cameron
PLAN of
LEASES - Areas available etc
Ref - Mineral Chart - St. Mt C No 1
1" = 10 chns /M? Oct/1966.

0415-078