


added
6/80

POST OFFICE AREA

0418-001

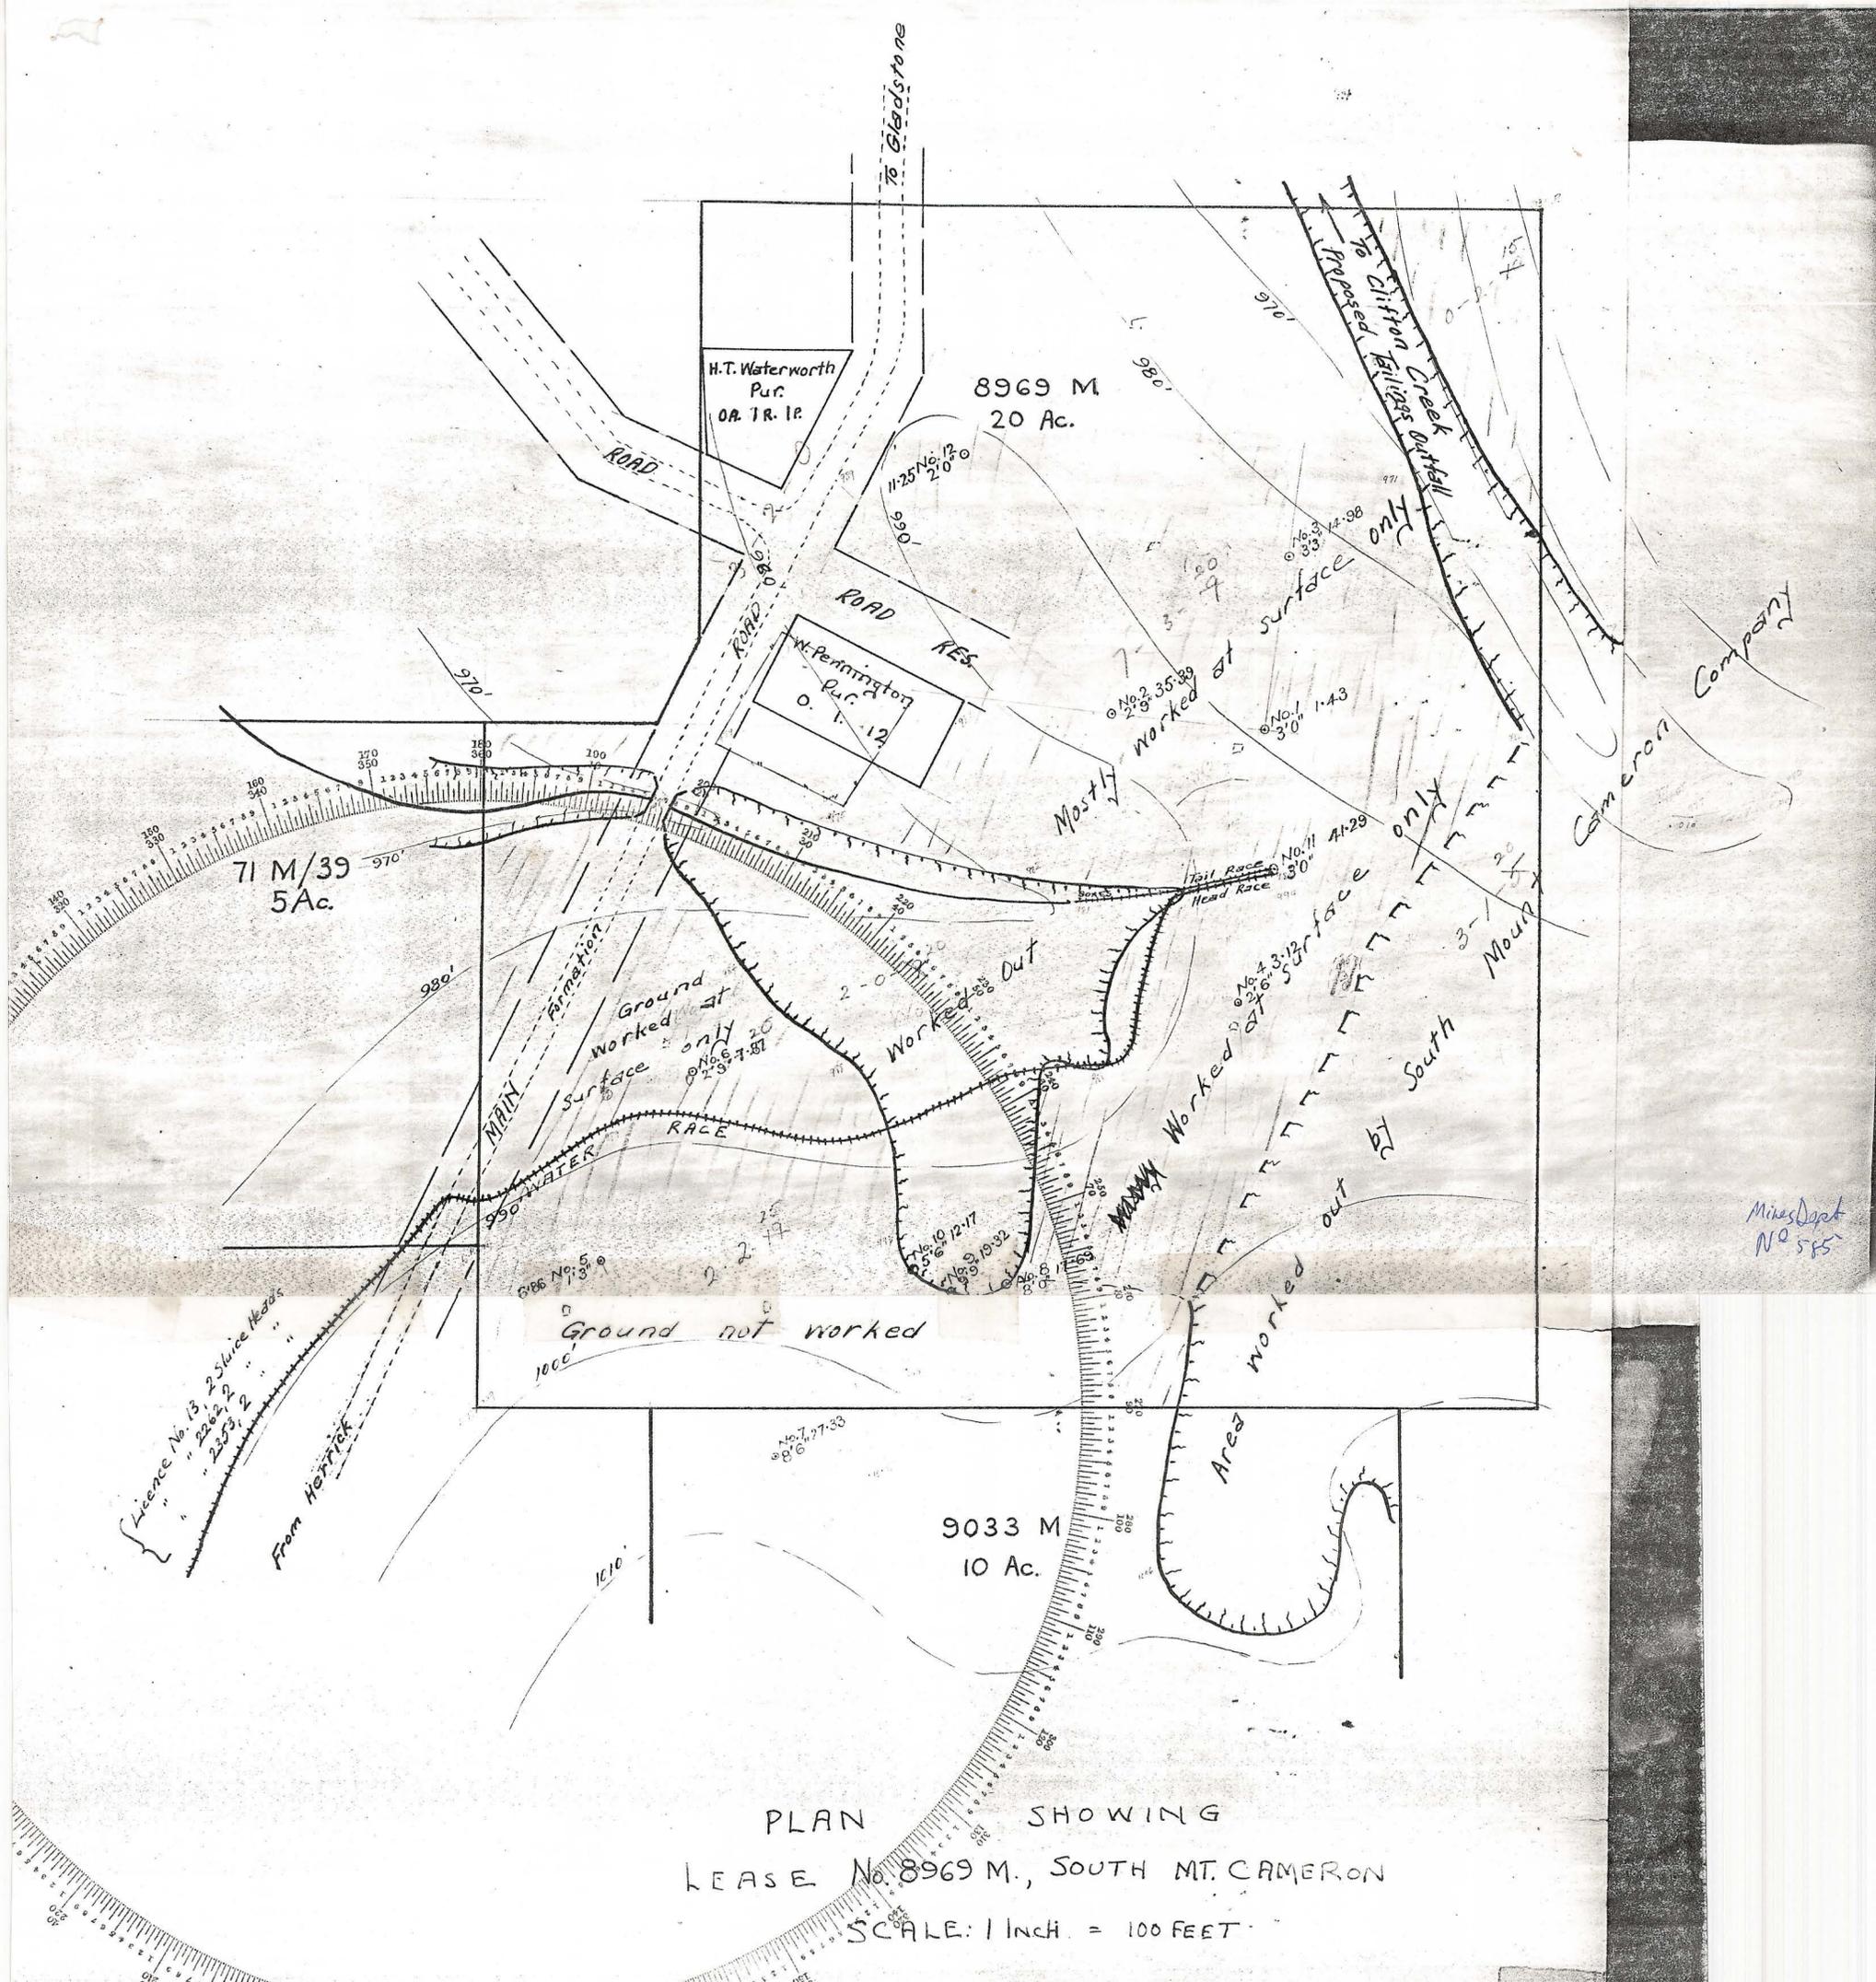

PLAN SHOWING
LEASE No. 8969 M., SOUTH MT. CAMERON
SCALE: 1 INCH. = 100 FEET

N.B. Contours are approximate and based on assumed datum.

- 3-2-0 Roads, purchase blocks, and isolated areas
- 5-2-0 Worked out areas
- 8-3-0 Partly worked areas
- 3-1-0 Virgin ground

Mines Dept Plan No 585

5 cm

0418-001