


0418-006

ENDURANCE

AAA

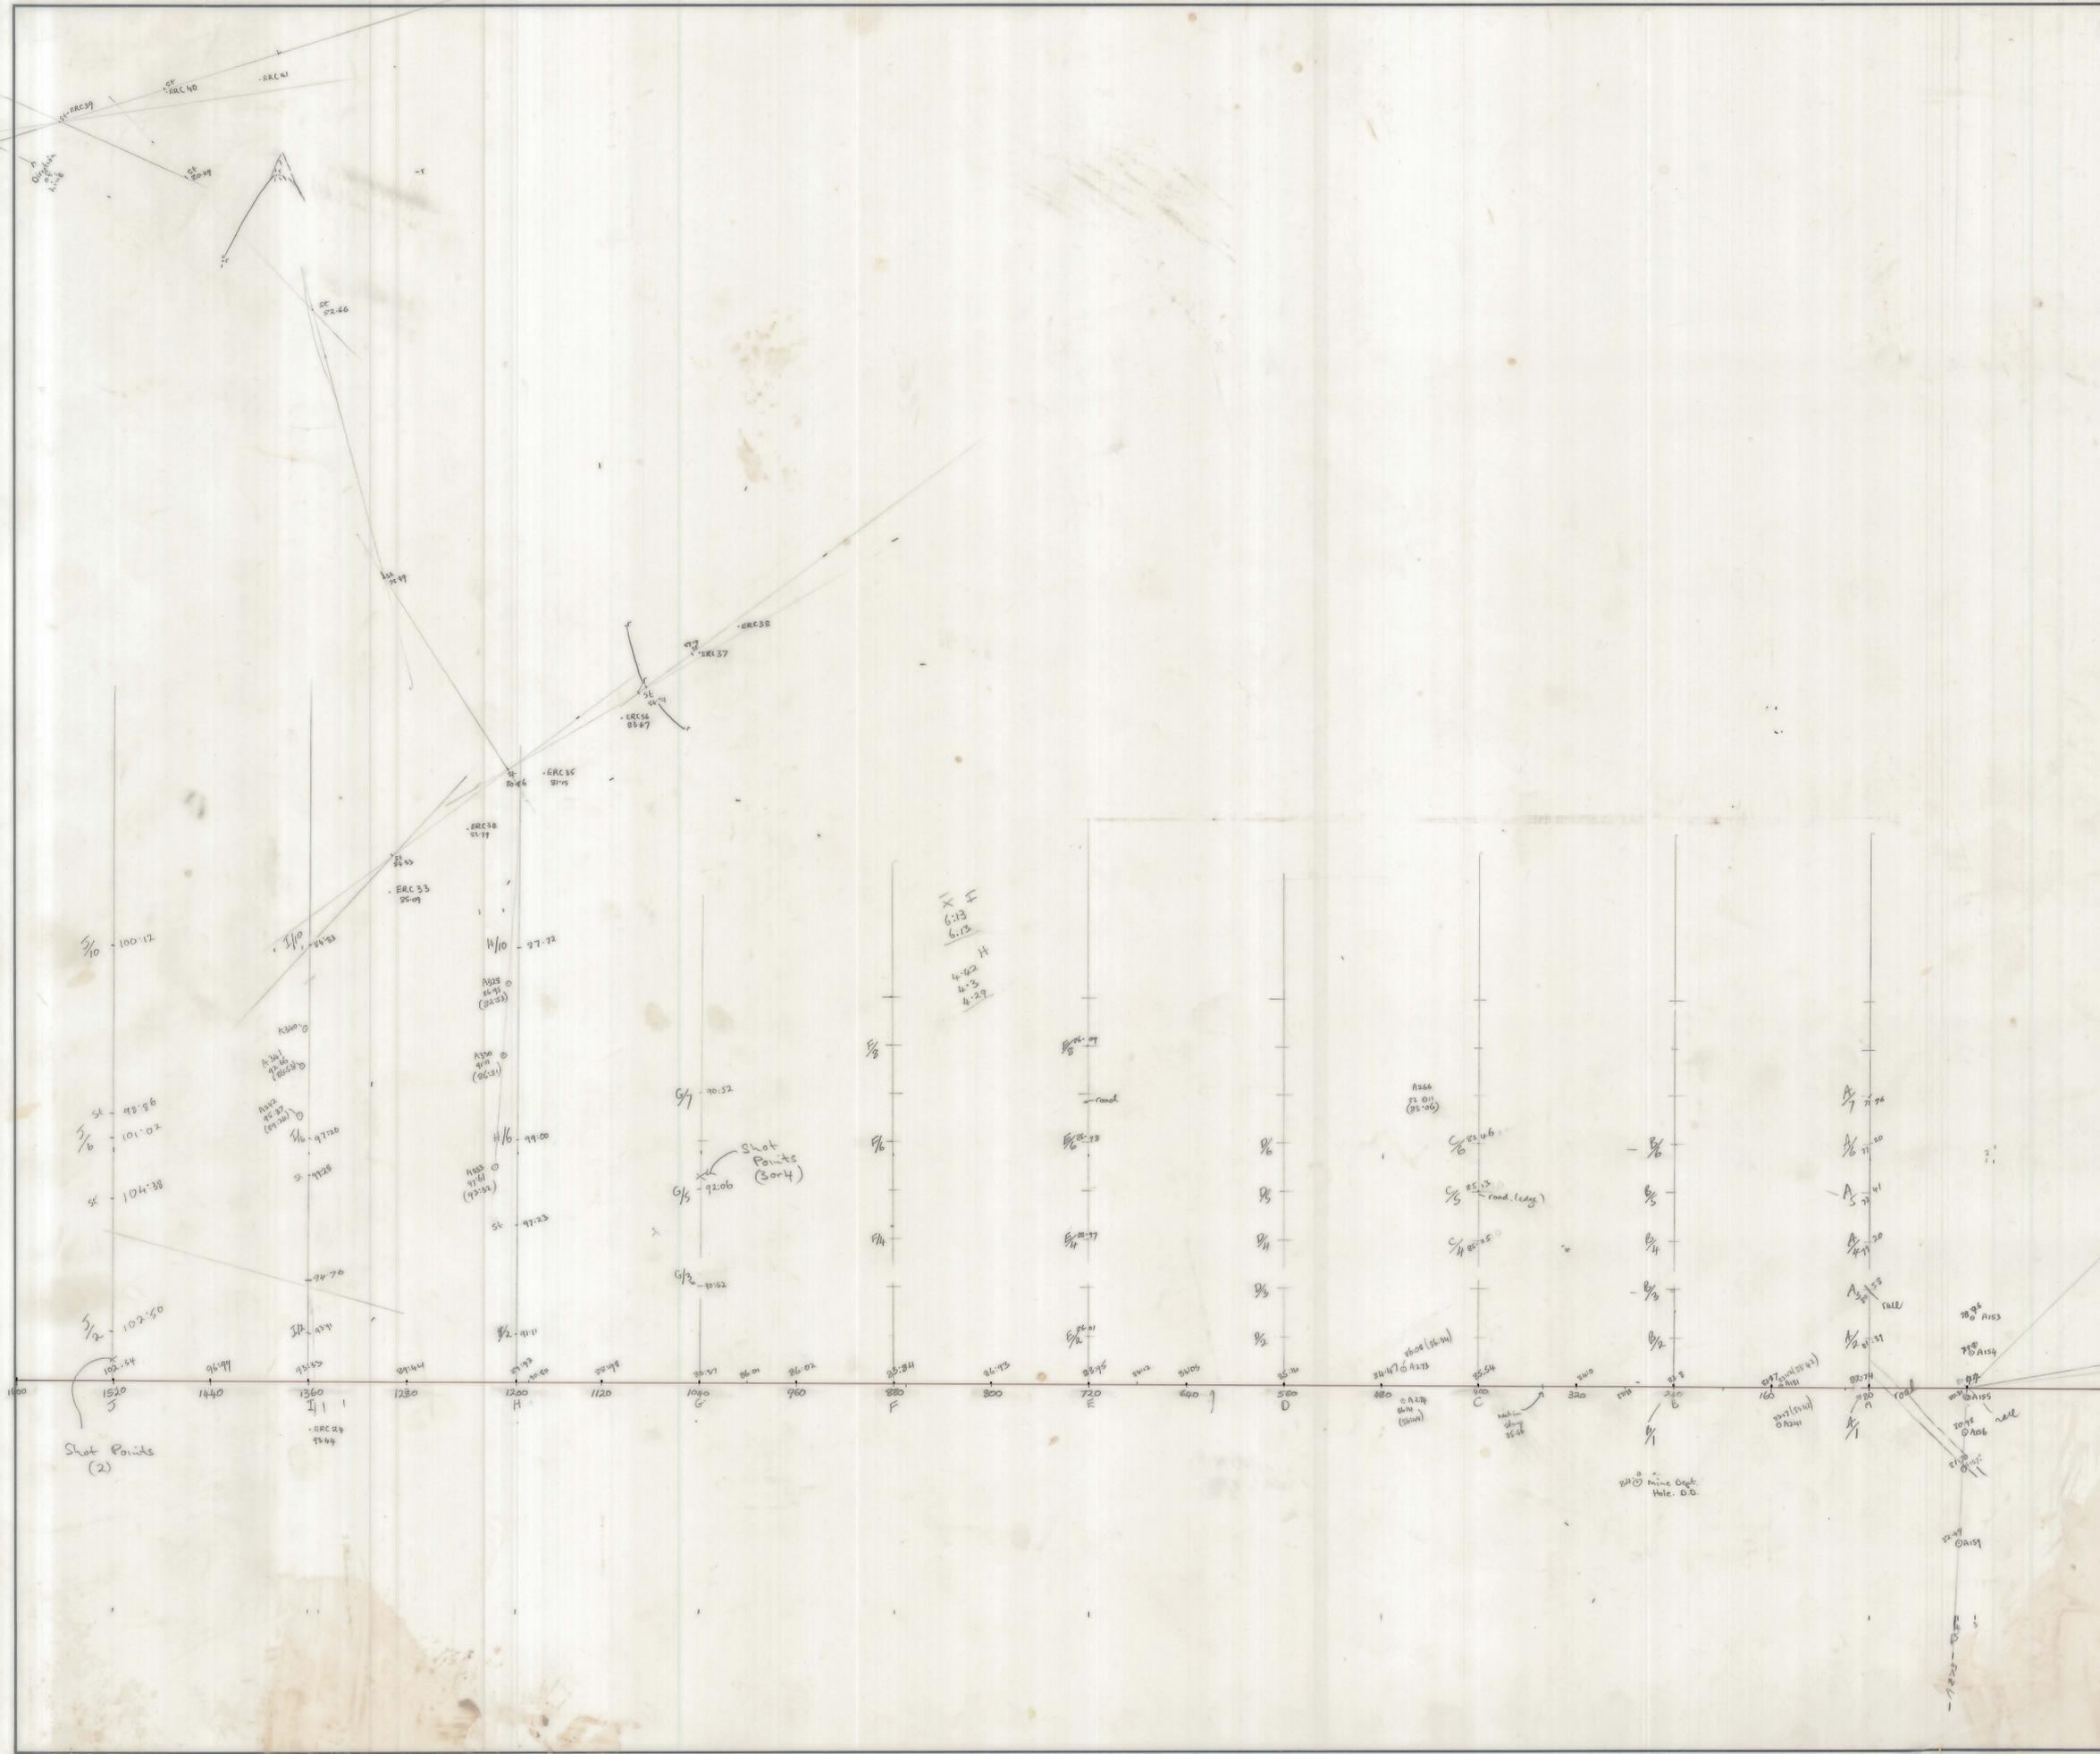

By 0 = 264' = 80.47m

To Mt. Cameron Trig 210° 52' 31"

To Sth Edge Endurance Shallow Pump House

To Sth Edge of W. Endurance Pump Hole

5cm
0418-006

AUSTRALIAN ANGLIO AMERICAN LTD	
PROJECT	ENDURANCE R.C. DRILLING GRID
AREA	Sth Mt Cameron
DATA	Survey Diagram
COMPILED	RAMBENS
DRAWN	31/8/82
AMENDED	
SCALE	1:2500
REF No	