
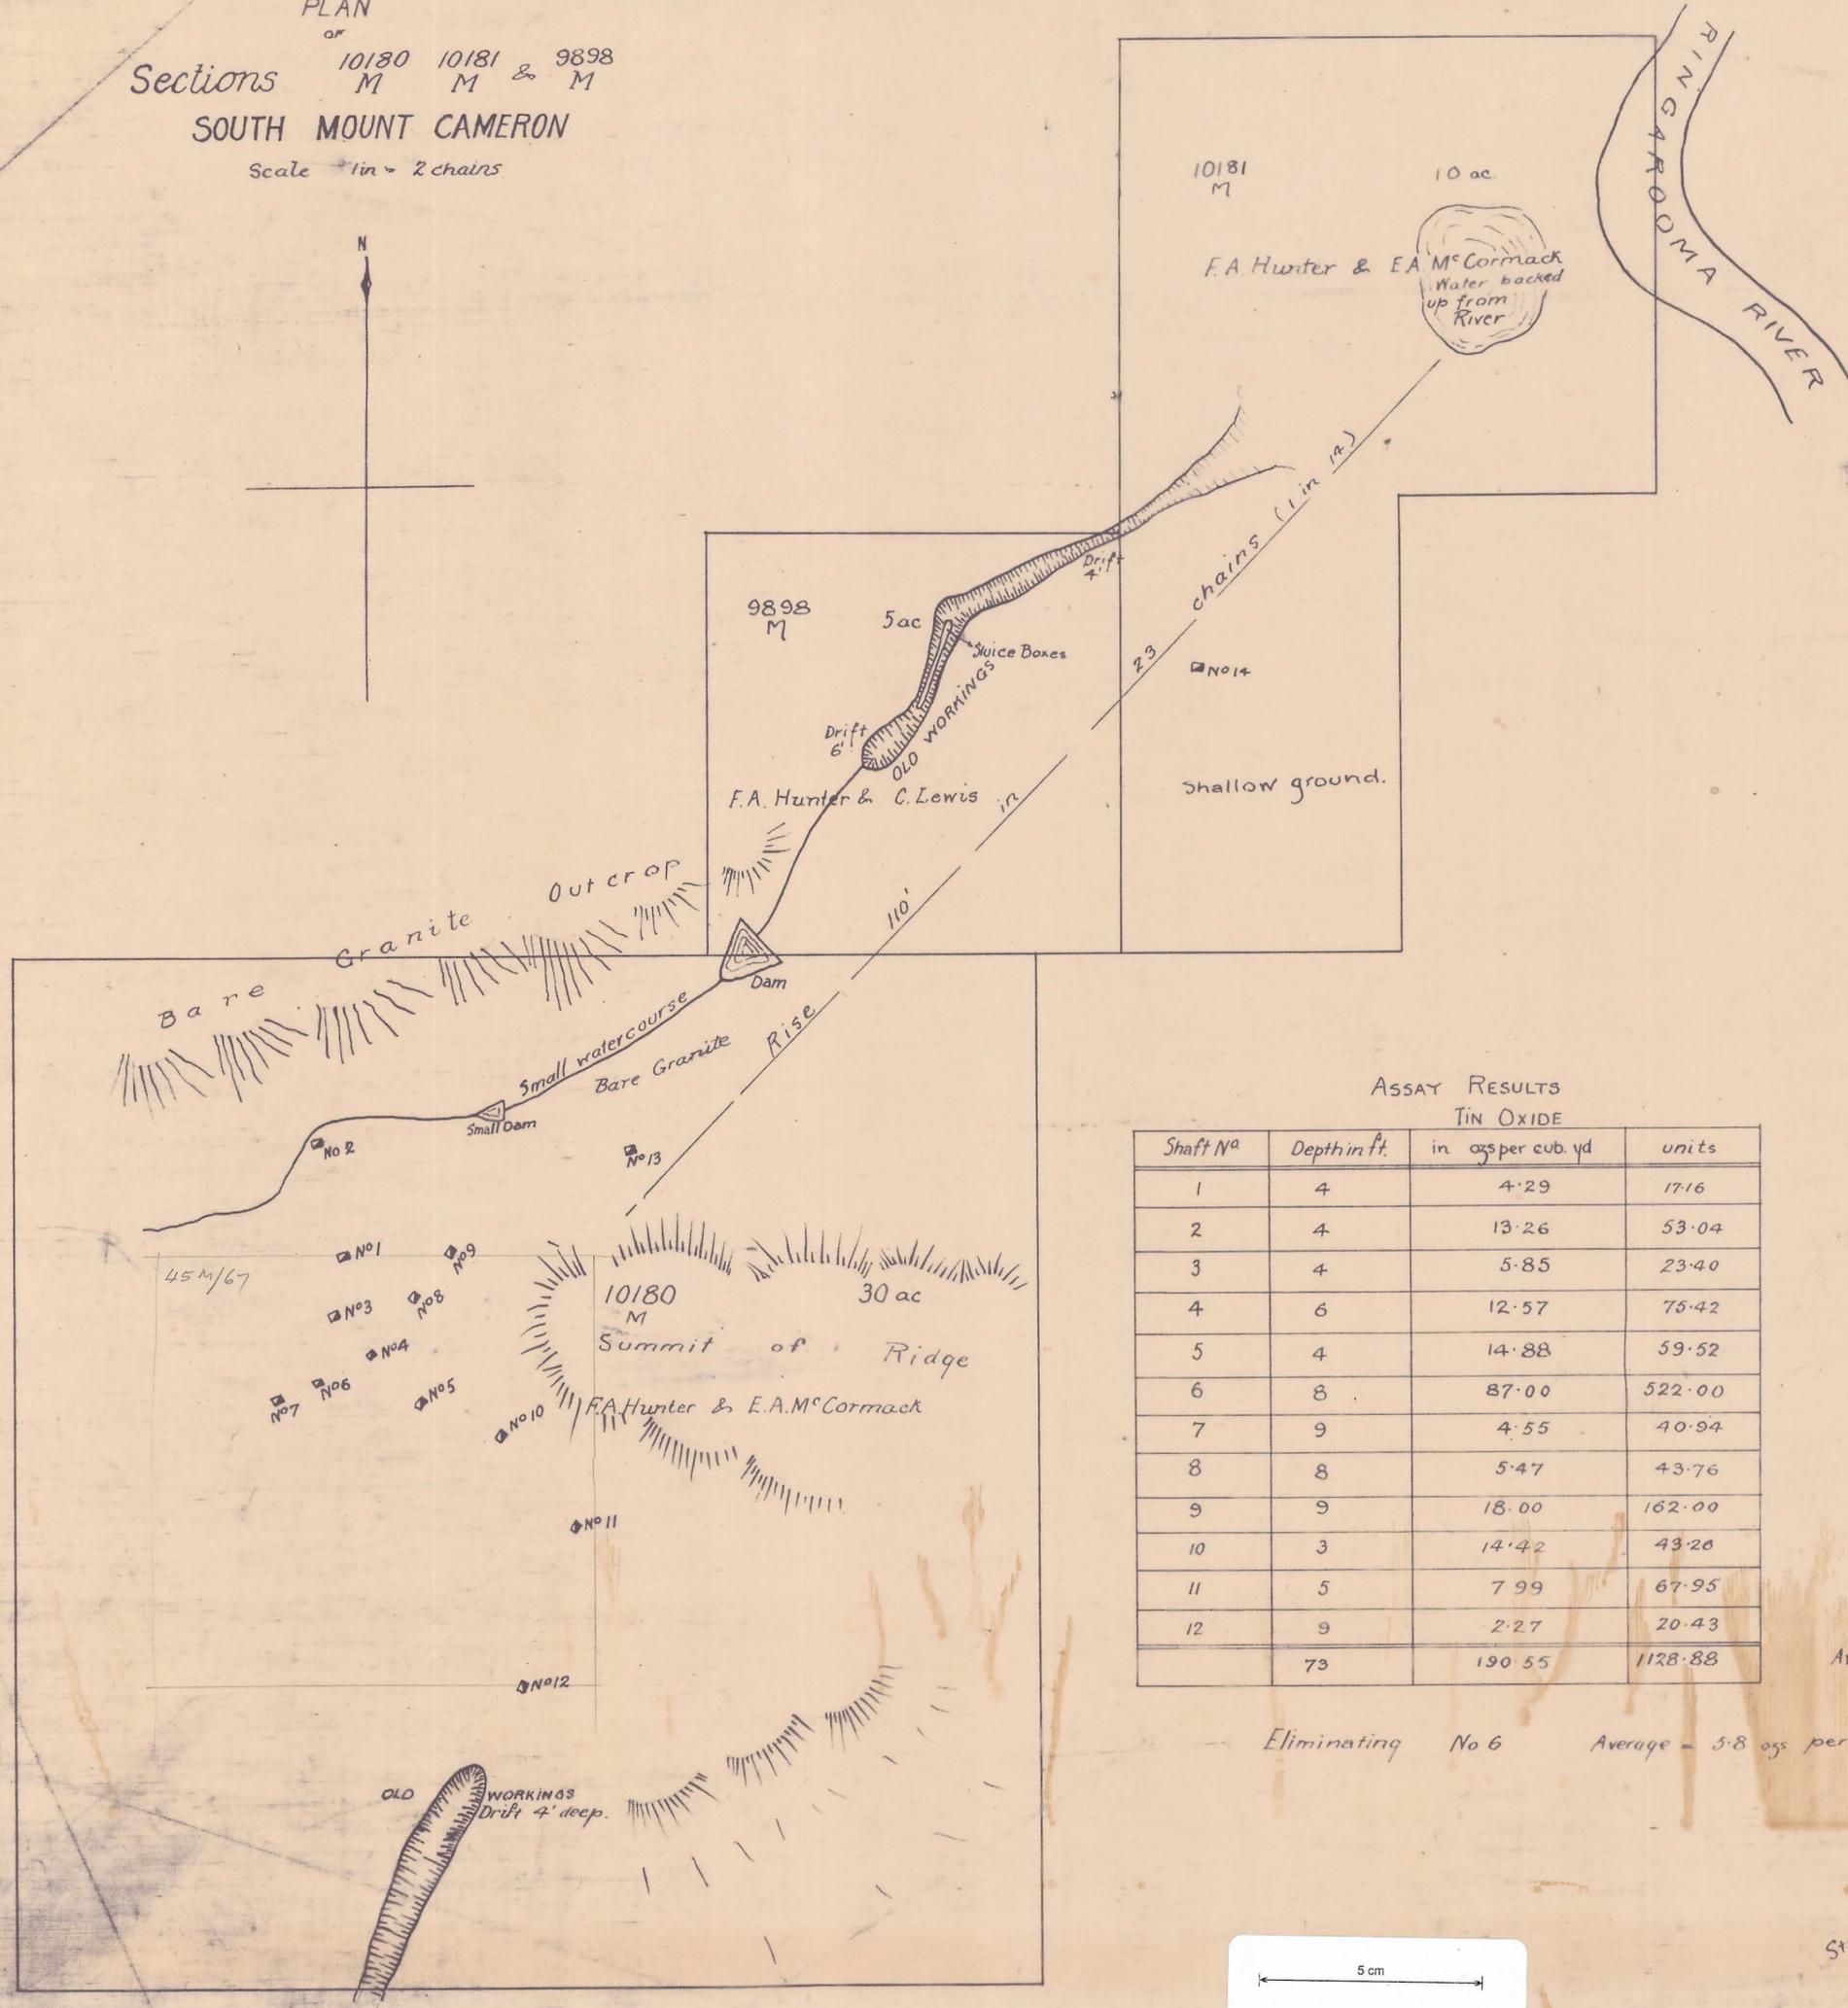


PLAN
of
Sections 10180 M, 10181 M & 9898 M
SOUTH MOUNT CAMERON

Scale 1 in = 2 chains

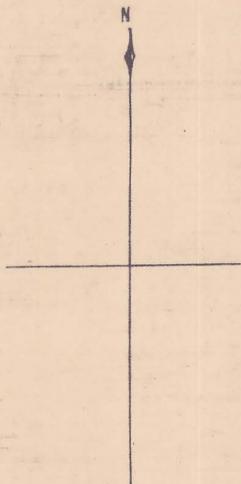

ASSAY RESULTS
TIN OXIDE

Shaft No	Depth in ft.	in ozs per cub. yd	units
1	4	4.29	17.16
2	4	13.26	53.04
3	4	5.85	23.40
4	6	12.57	75.42
5	4	14.88	59.52
6	8	87.00	522.00
7	9	4.55	40.94
8	8	5.47	43.76
9	9	18.00	162.00
10	3	14.42	43.26
11	5	7.99	67.95
12	9	2.27	20.43
73		190.55	1128.88

Average = 15.46 ozs per cubic yd

Eliminating No 6 Average = 5.8 ozs per cubic yard

J. DeCott
State Mining Engineer
3.6.28.

