


0420-001

CROSS SECTIONS
PICKETTS PLAIN
MAY 1983
RAAM

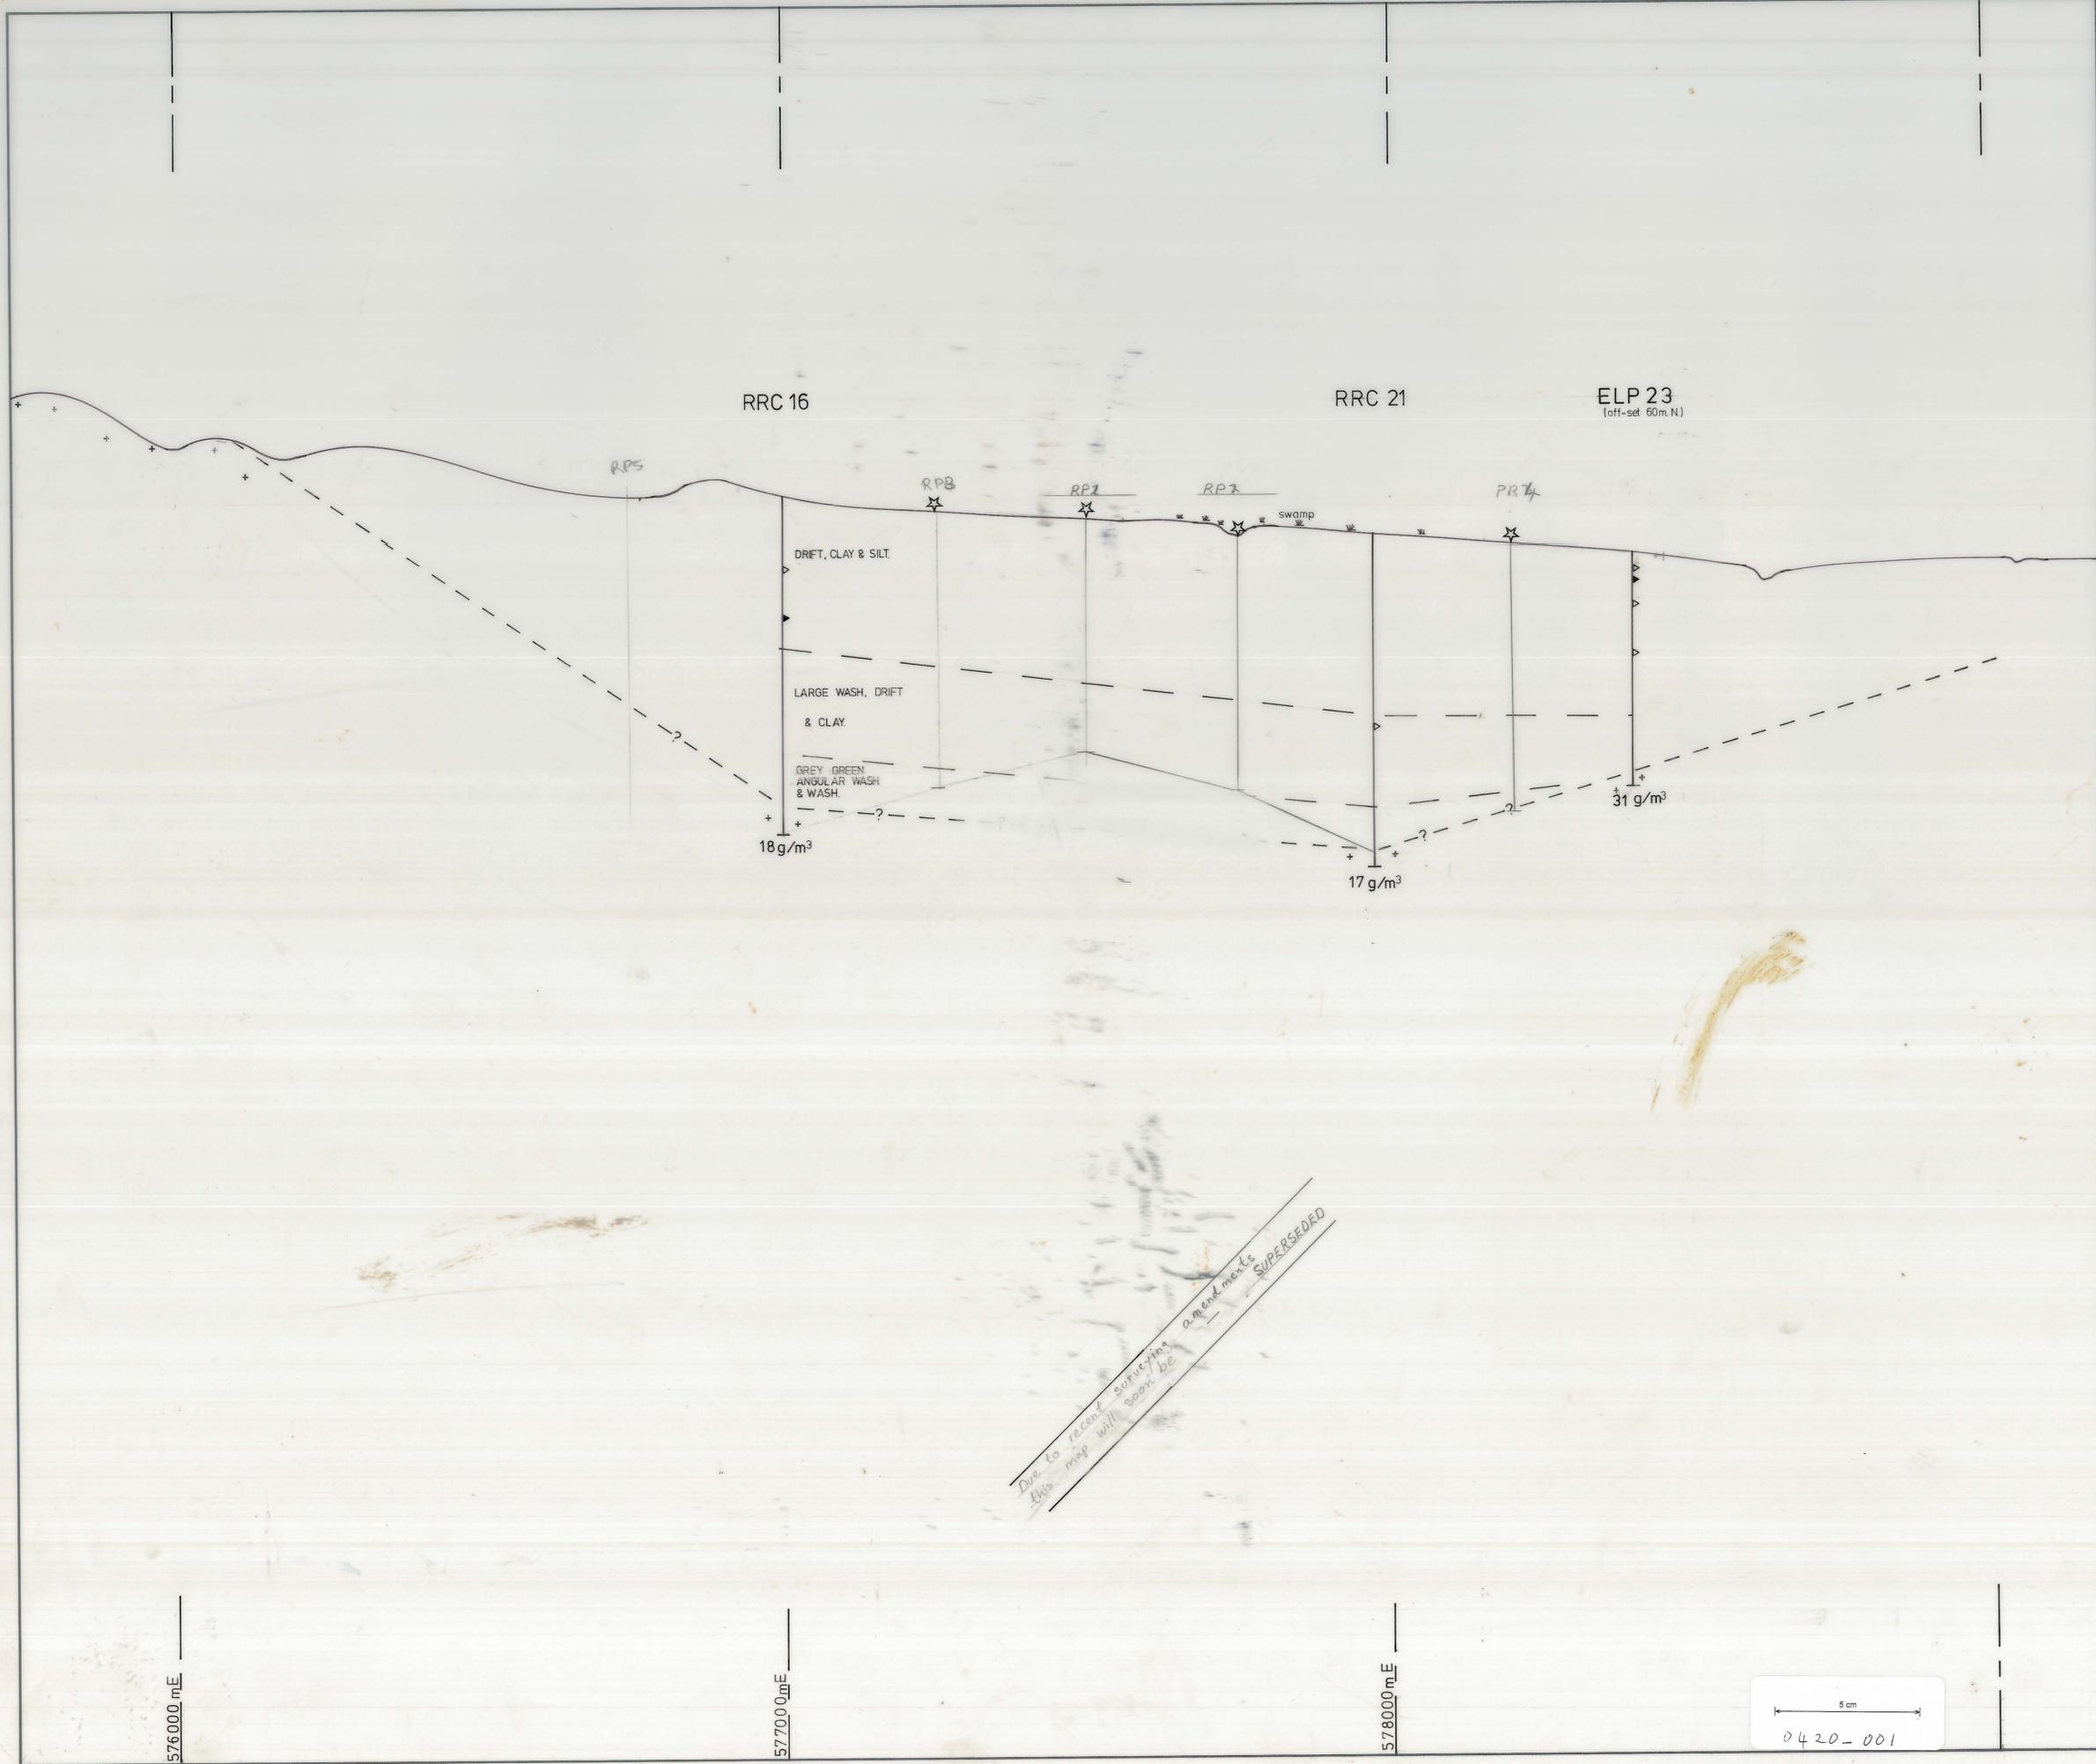

*Due to recent surveying
amendments
this map will soon be
SUPERSEDED*


LEGEND

- ▽ SAMPLE INTERVAL GRADE 50-99 g/m³
- ▽ " " " 100-249 g/m³
- ☆ PROPOSED DRILL HOLES

576000 mE

577000 mE

578000 mE

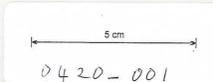

AUSTRALIAN ANGLO AMERICAN LTD			
PROJECT	A.A.A.-TRIAKO MINES J.V.		
AREA	PICKETTS PLAIN	N.E. TASMANIA	
DATA	E.-W. GEOLOGICAL CROSS SECTION LINE 54 58 000 metres North		
COMPILED	RAAM 5/80	SCALE	H:1:5000 V:1:500
DRAWN	RAAM	REF No	TAS=10-158
AMENDED			