


0424-003

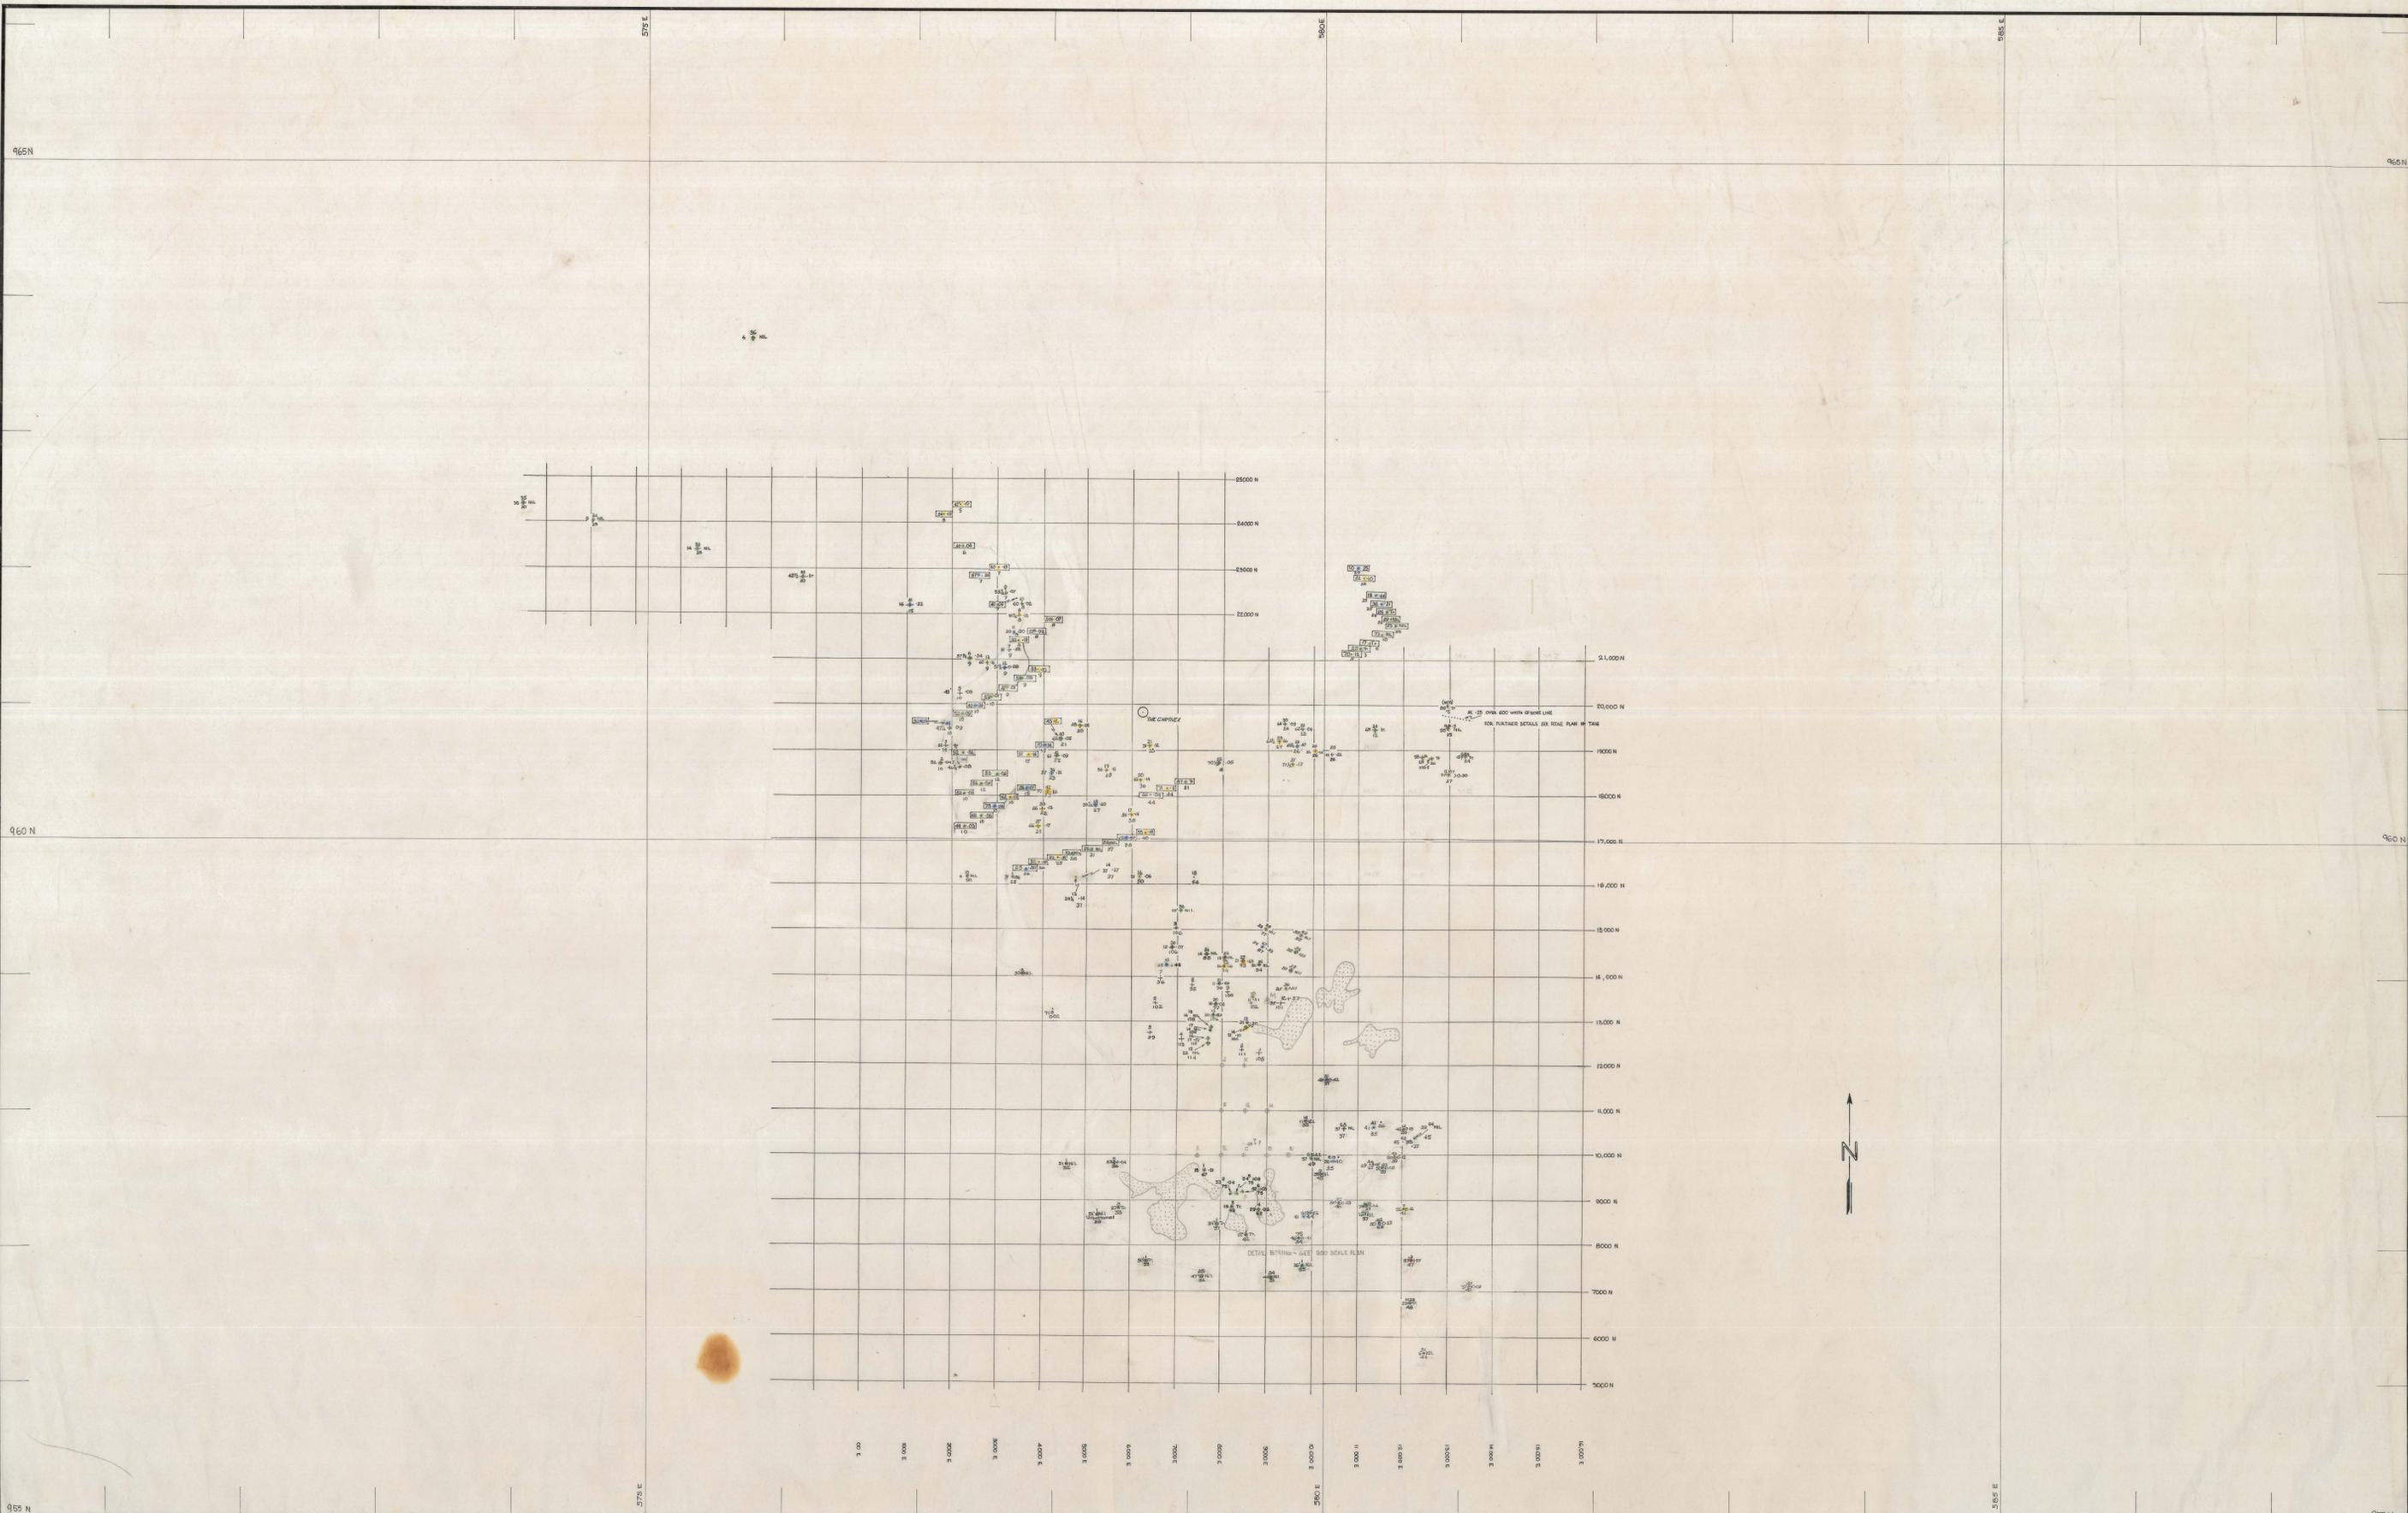

LEGEND:

+	6" HOLE	09 % Sh ₂ O	GREEN
•	16" HOLE	1 % Sh ₂ O	19 % Sh ₂ O YELLOW
◊	16" HOLE	50 % Sh ₂ O	49 % Sh ₂ O BLUE
◊	16" HOLE	50 % Sh ₂ O	49 % Sh ₂ O BROWN
◊	16" HOLE	70 % Sh ₂ O	AND OVER RED

REDUCED LEVELS = E1 ABOVE SEA LEVEL TAKEN FROM LANDS DEPT. TOPOGRAPHIC PLAN
 BORE HOLES IN VICINITY CORRECTED FOR R.L. TO SEA LEVEL BY ASSUMING HOLE NO. 38 = 33' ABOVE SEA LEVEL
 R.L. HOLE NO. 38 = 89'
 CORRECTION = "34" (SUBTRACT FROM BORE R.L. TO GET E1 ABOVE SEA LEVEL)

S.C.T.N.L- DORSET TIN DIVISION
BORE PLAN
RINGAROOMA RIVER-GREAT NORTHERN PLAINS
NORTH OF Mt. CAMERON TAS.

SURVEY - - / /
 GEOLOGY - - / /
 ENGINEERING - - / /
 DRAWN - - / /
 TRACED - - / /
 REFERENCE -
 PRINT N°:
DRAWING N° - DD-053-6

DRAWER: