


0425-005

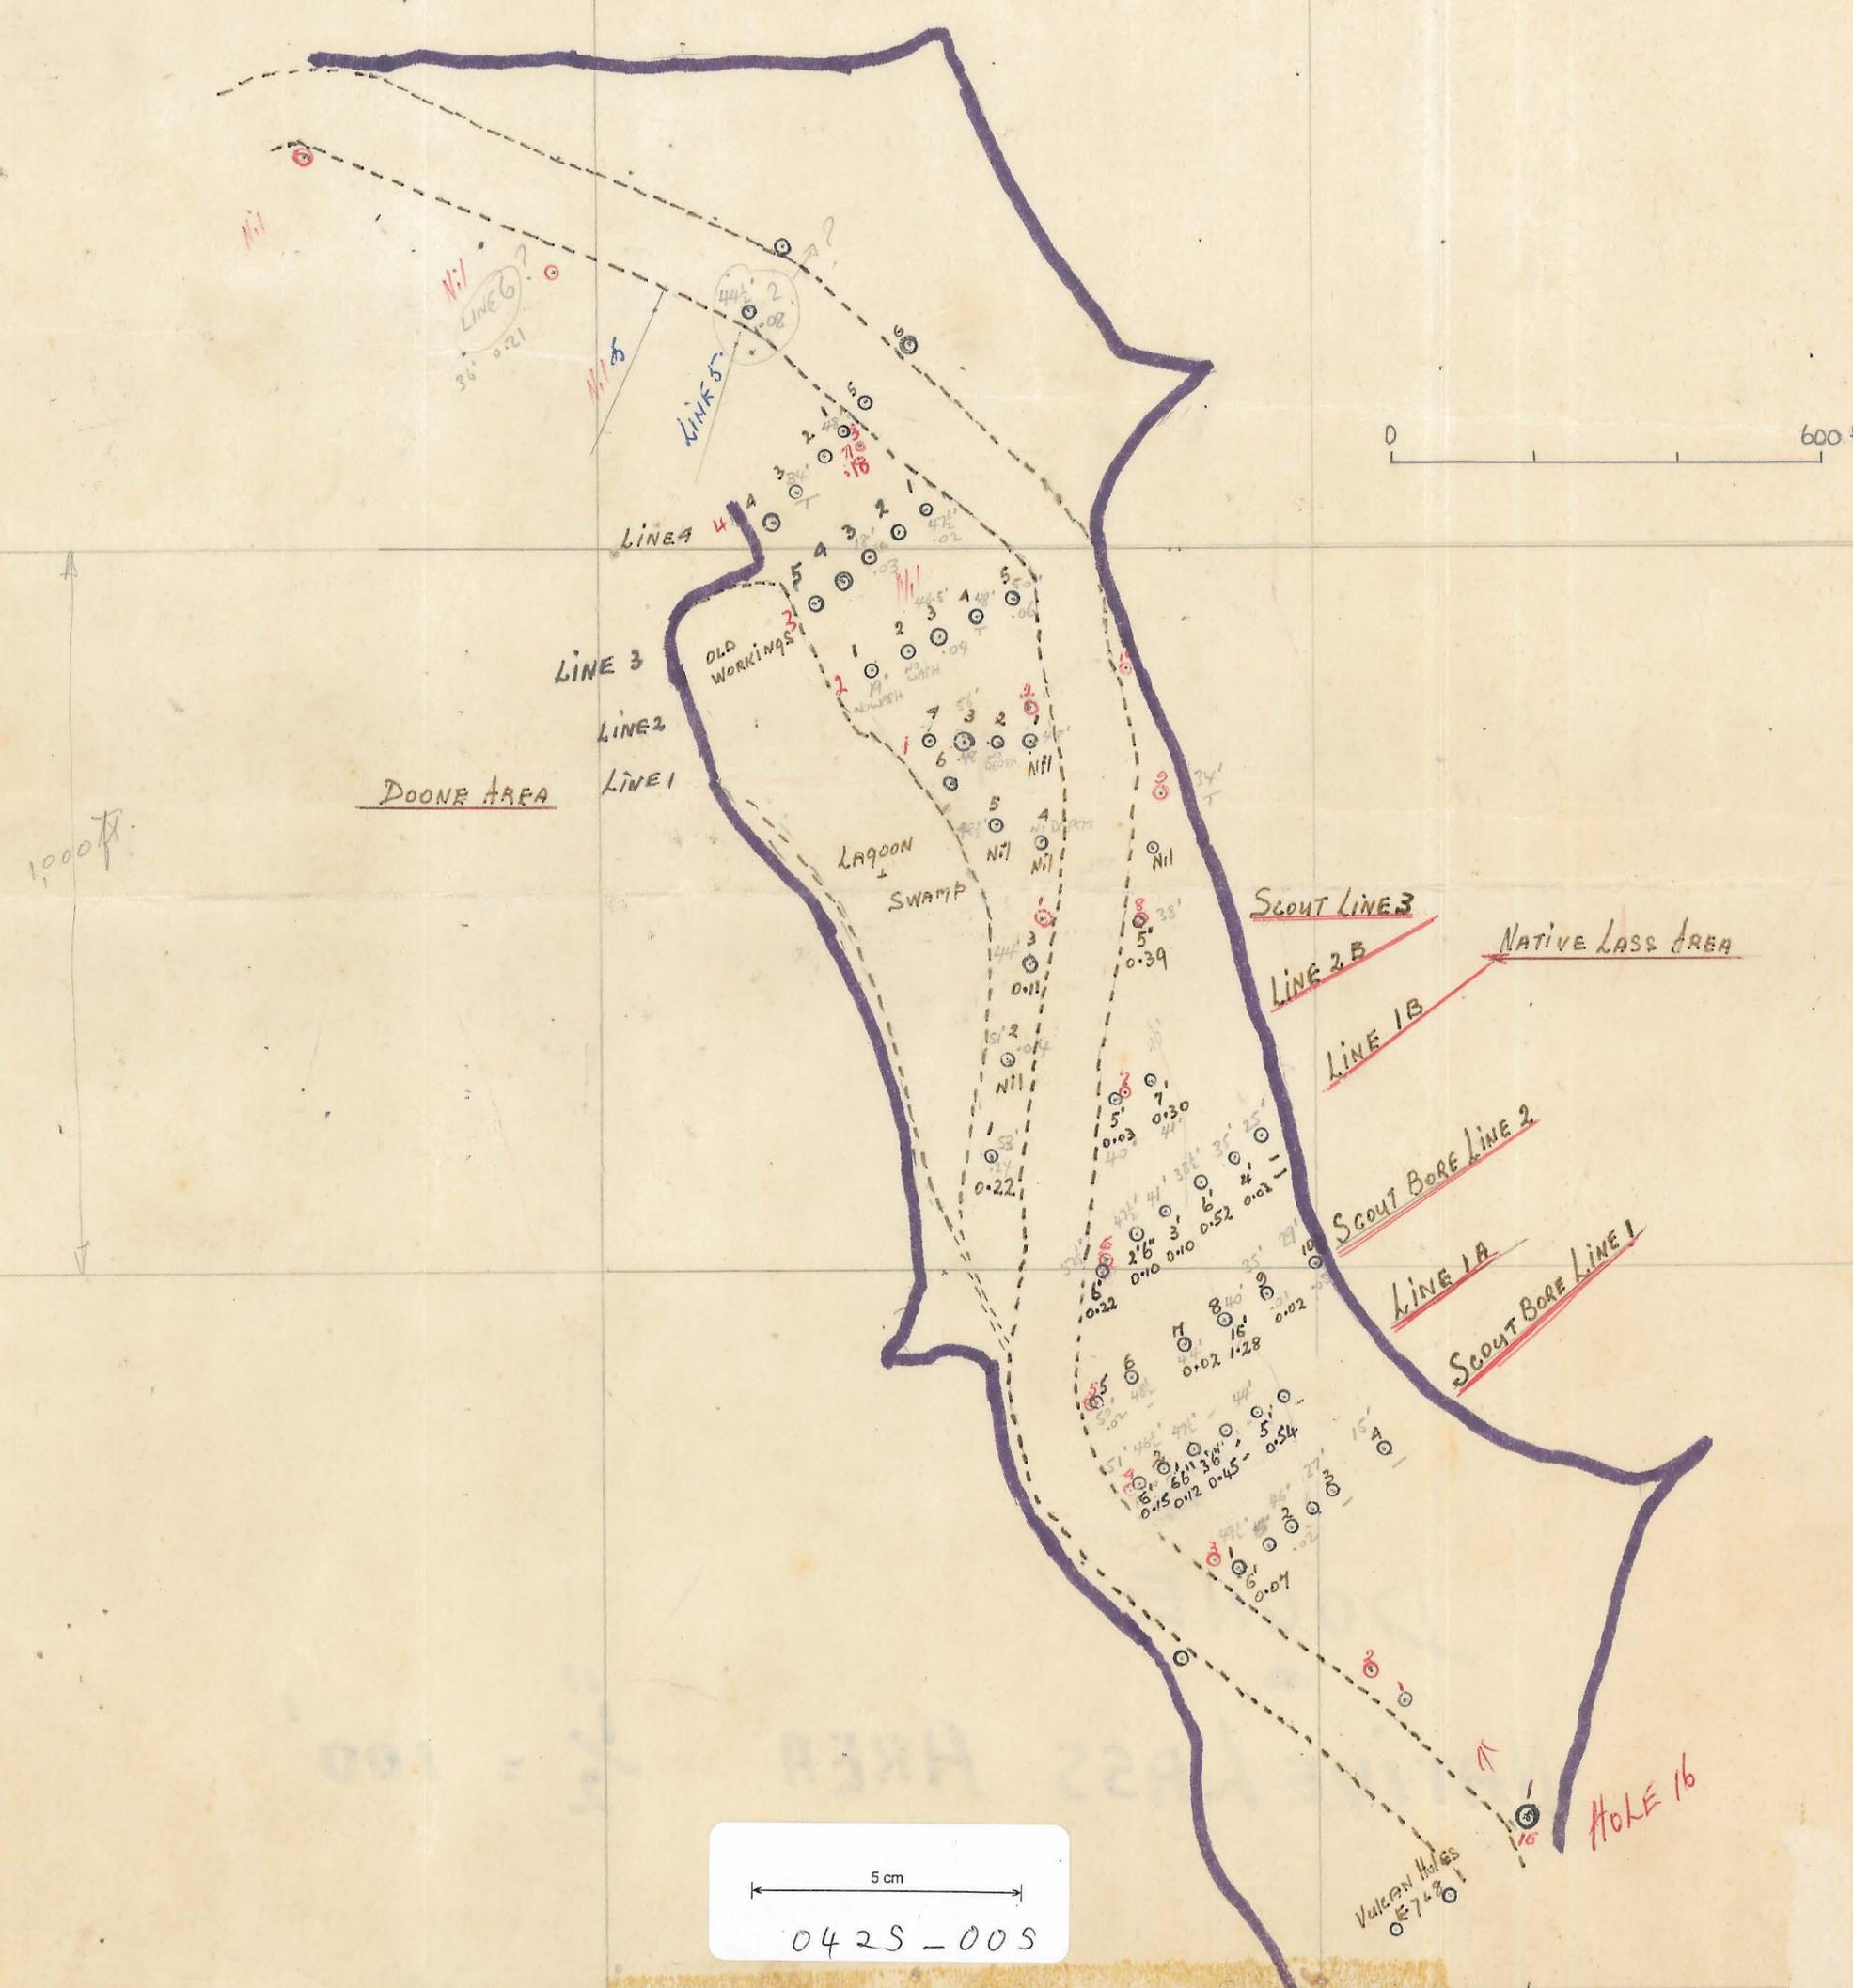

0425-005