


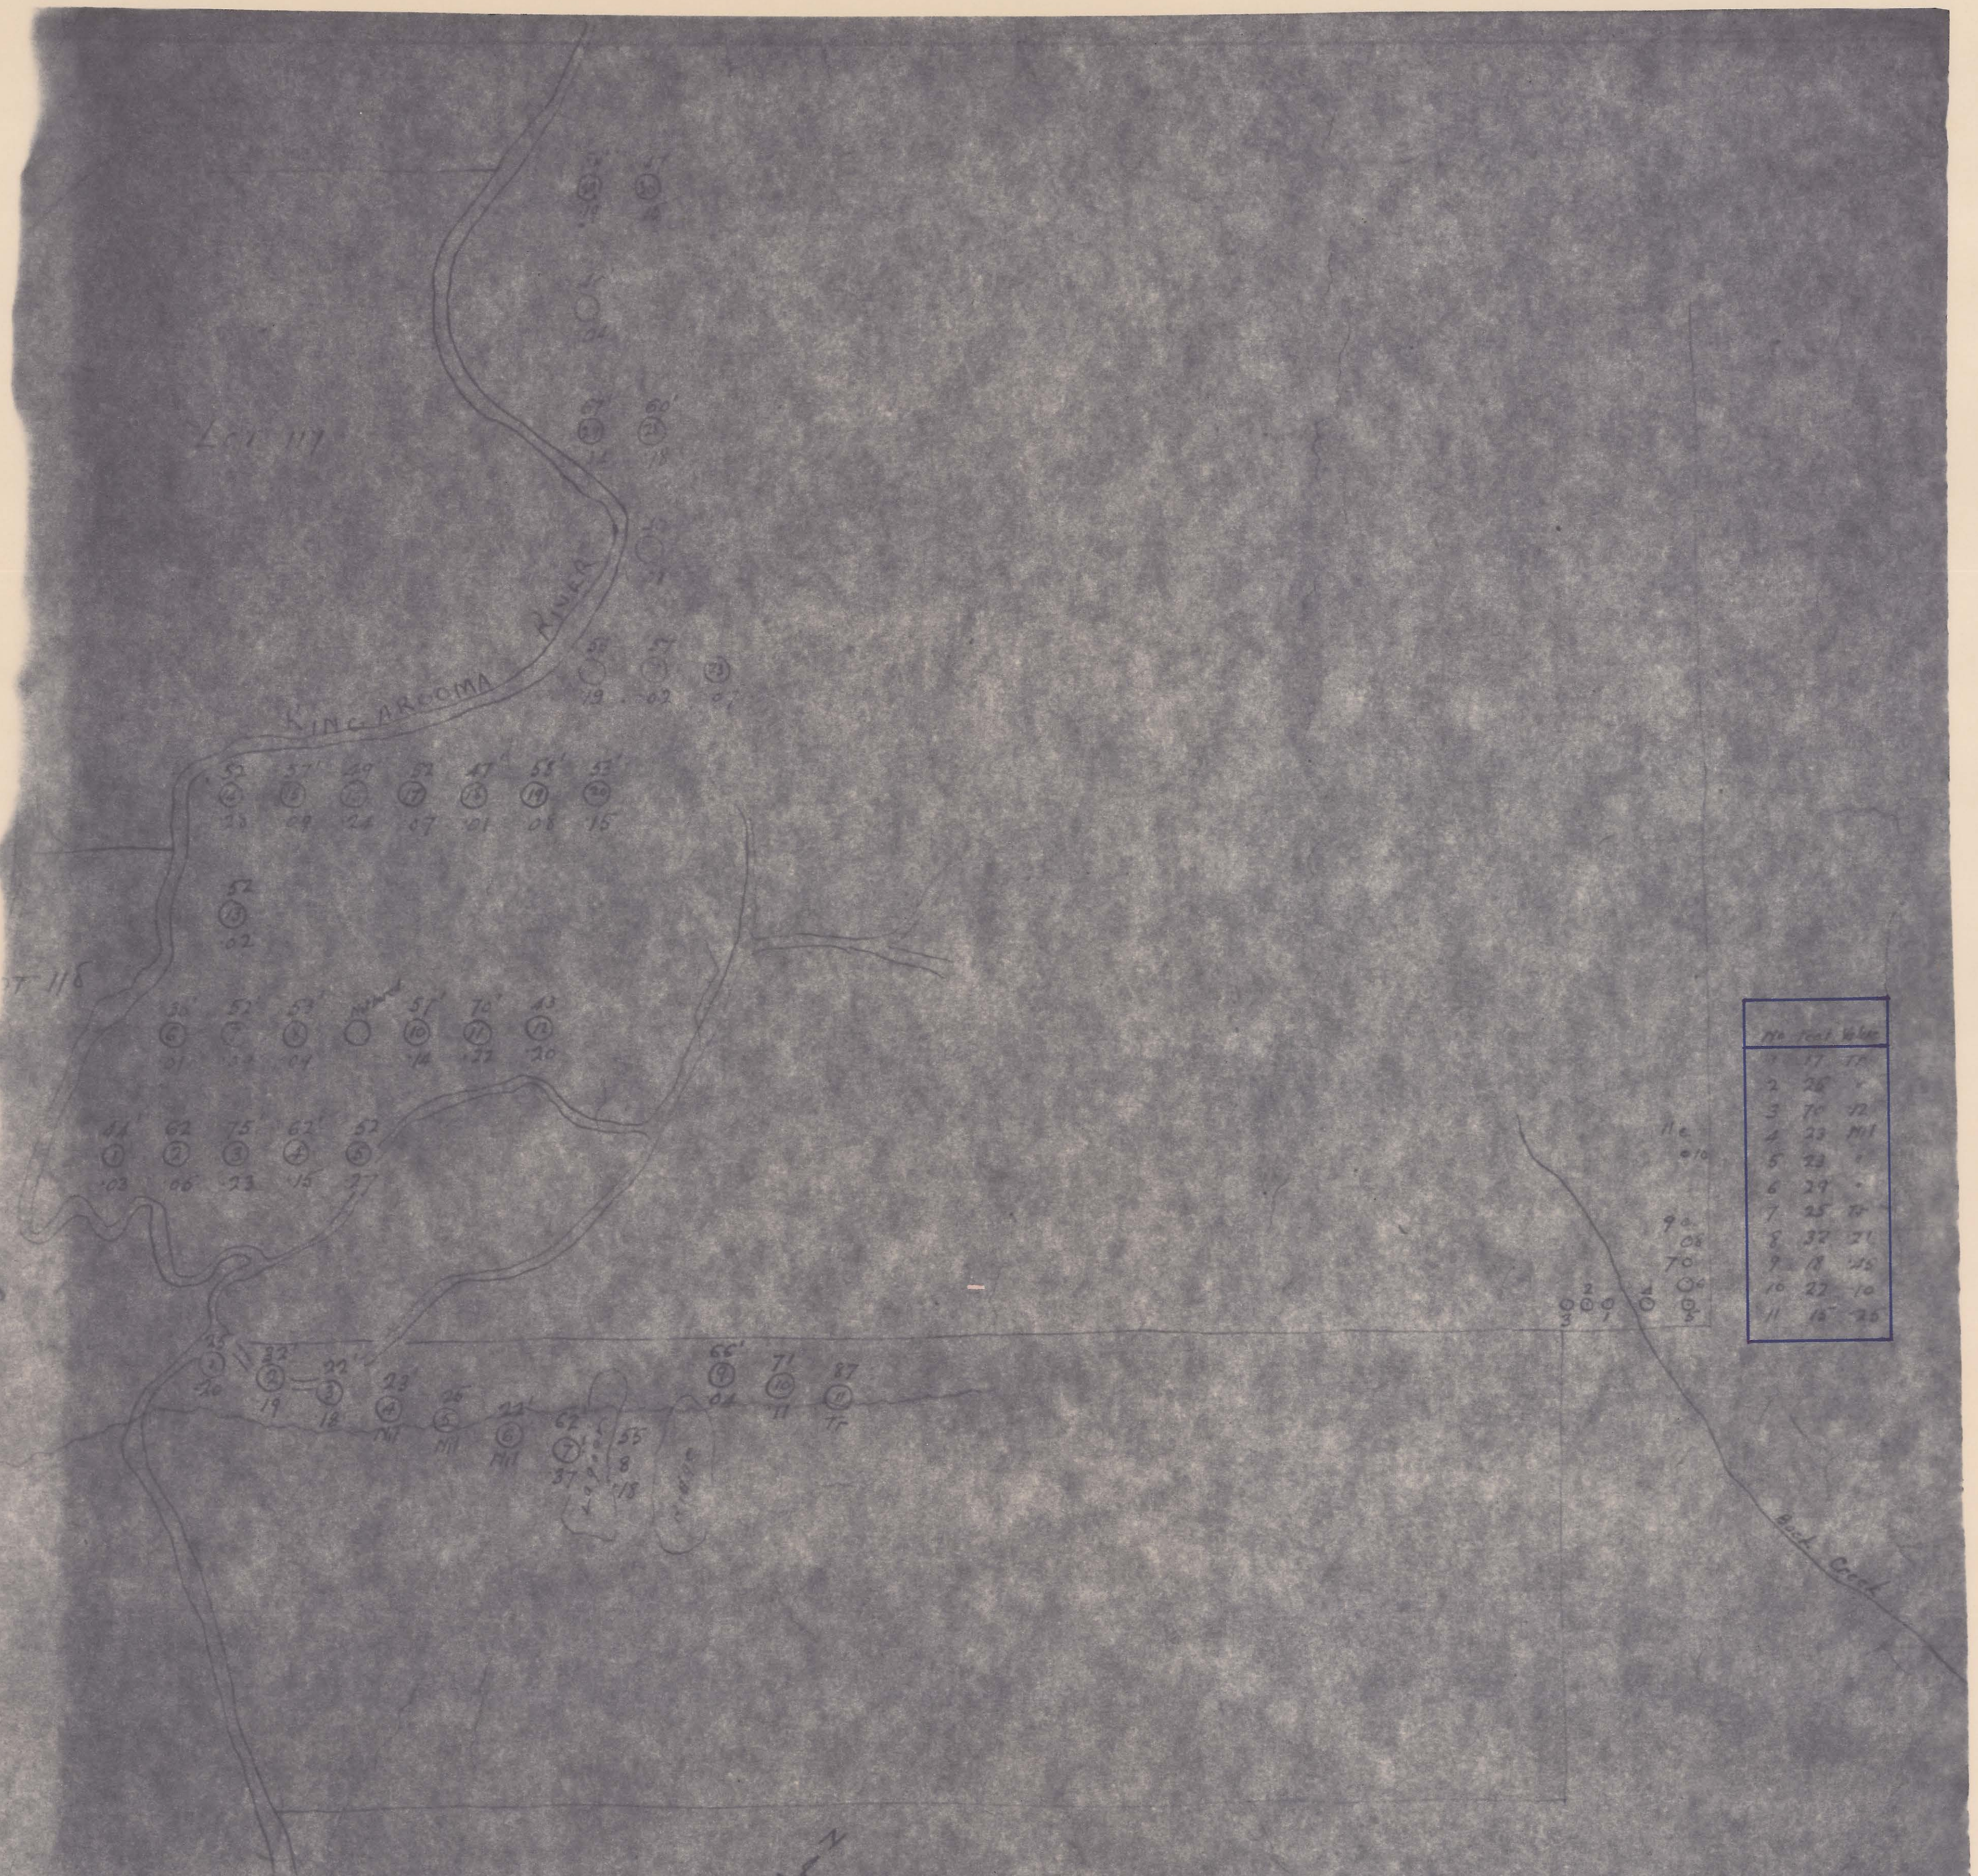

No	Test	Water
1	17	17
2	28	1
3	70	12
4	23	Nil
5	23	1
6	29	1
7	25	10
8	32	21
9	18	15
10	27	10
11	15	25

BORING PLAN OF FOSTER'S MARSH
BOOBYALLA

10 ch / 1 inch