


0427-007

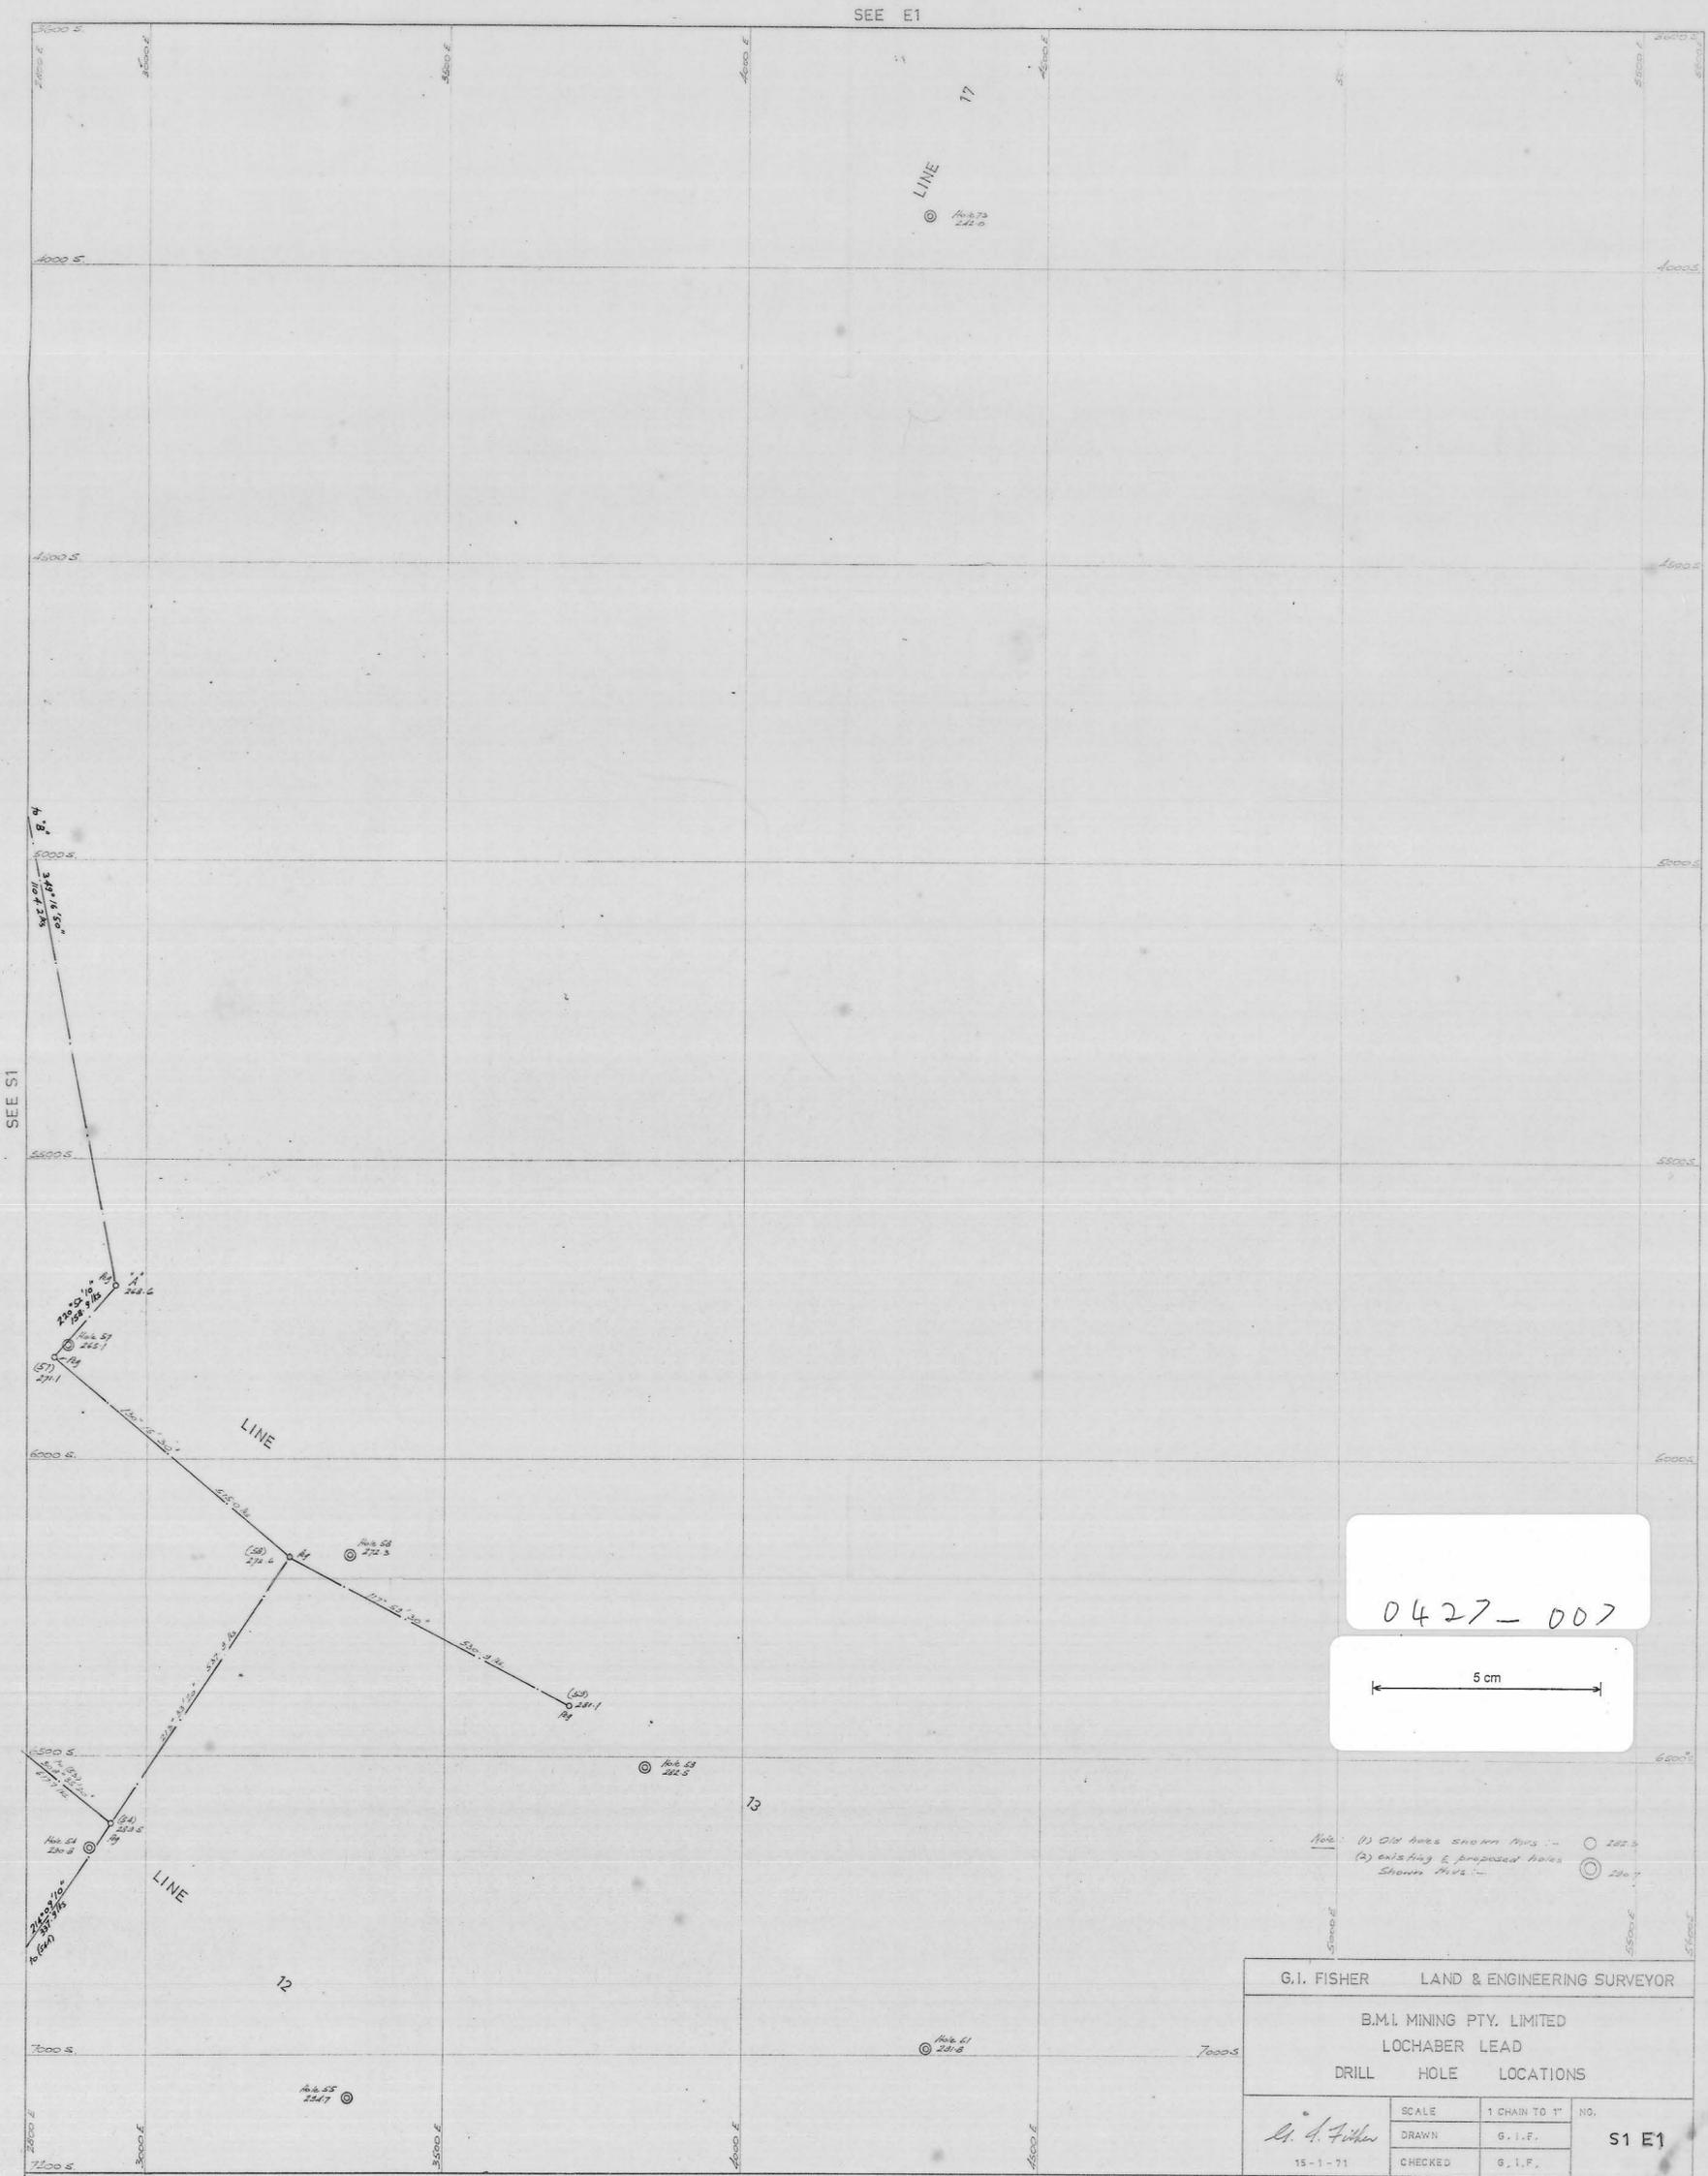

0427-007

5 cm

G.I. FISHER LAND & ENGINEERING SURVEYOR		
B.M.I. MINING PTY. LIMITED LOCHABER LEAD		
DRILL HOLE LOCATIONS		
<i>G.I. Fisher</i>	SCALE	1 CHAIN TO 1" NO.
	DRAWN	G.I.F.
15-1-71	CHECKED	G.I.F.
		S1 E1

Fig 41