
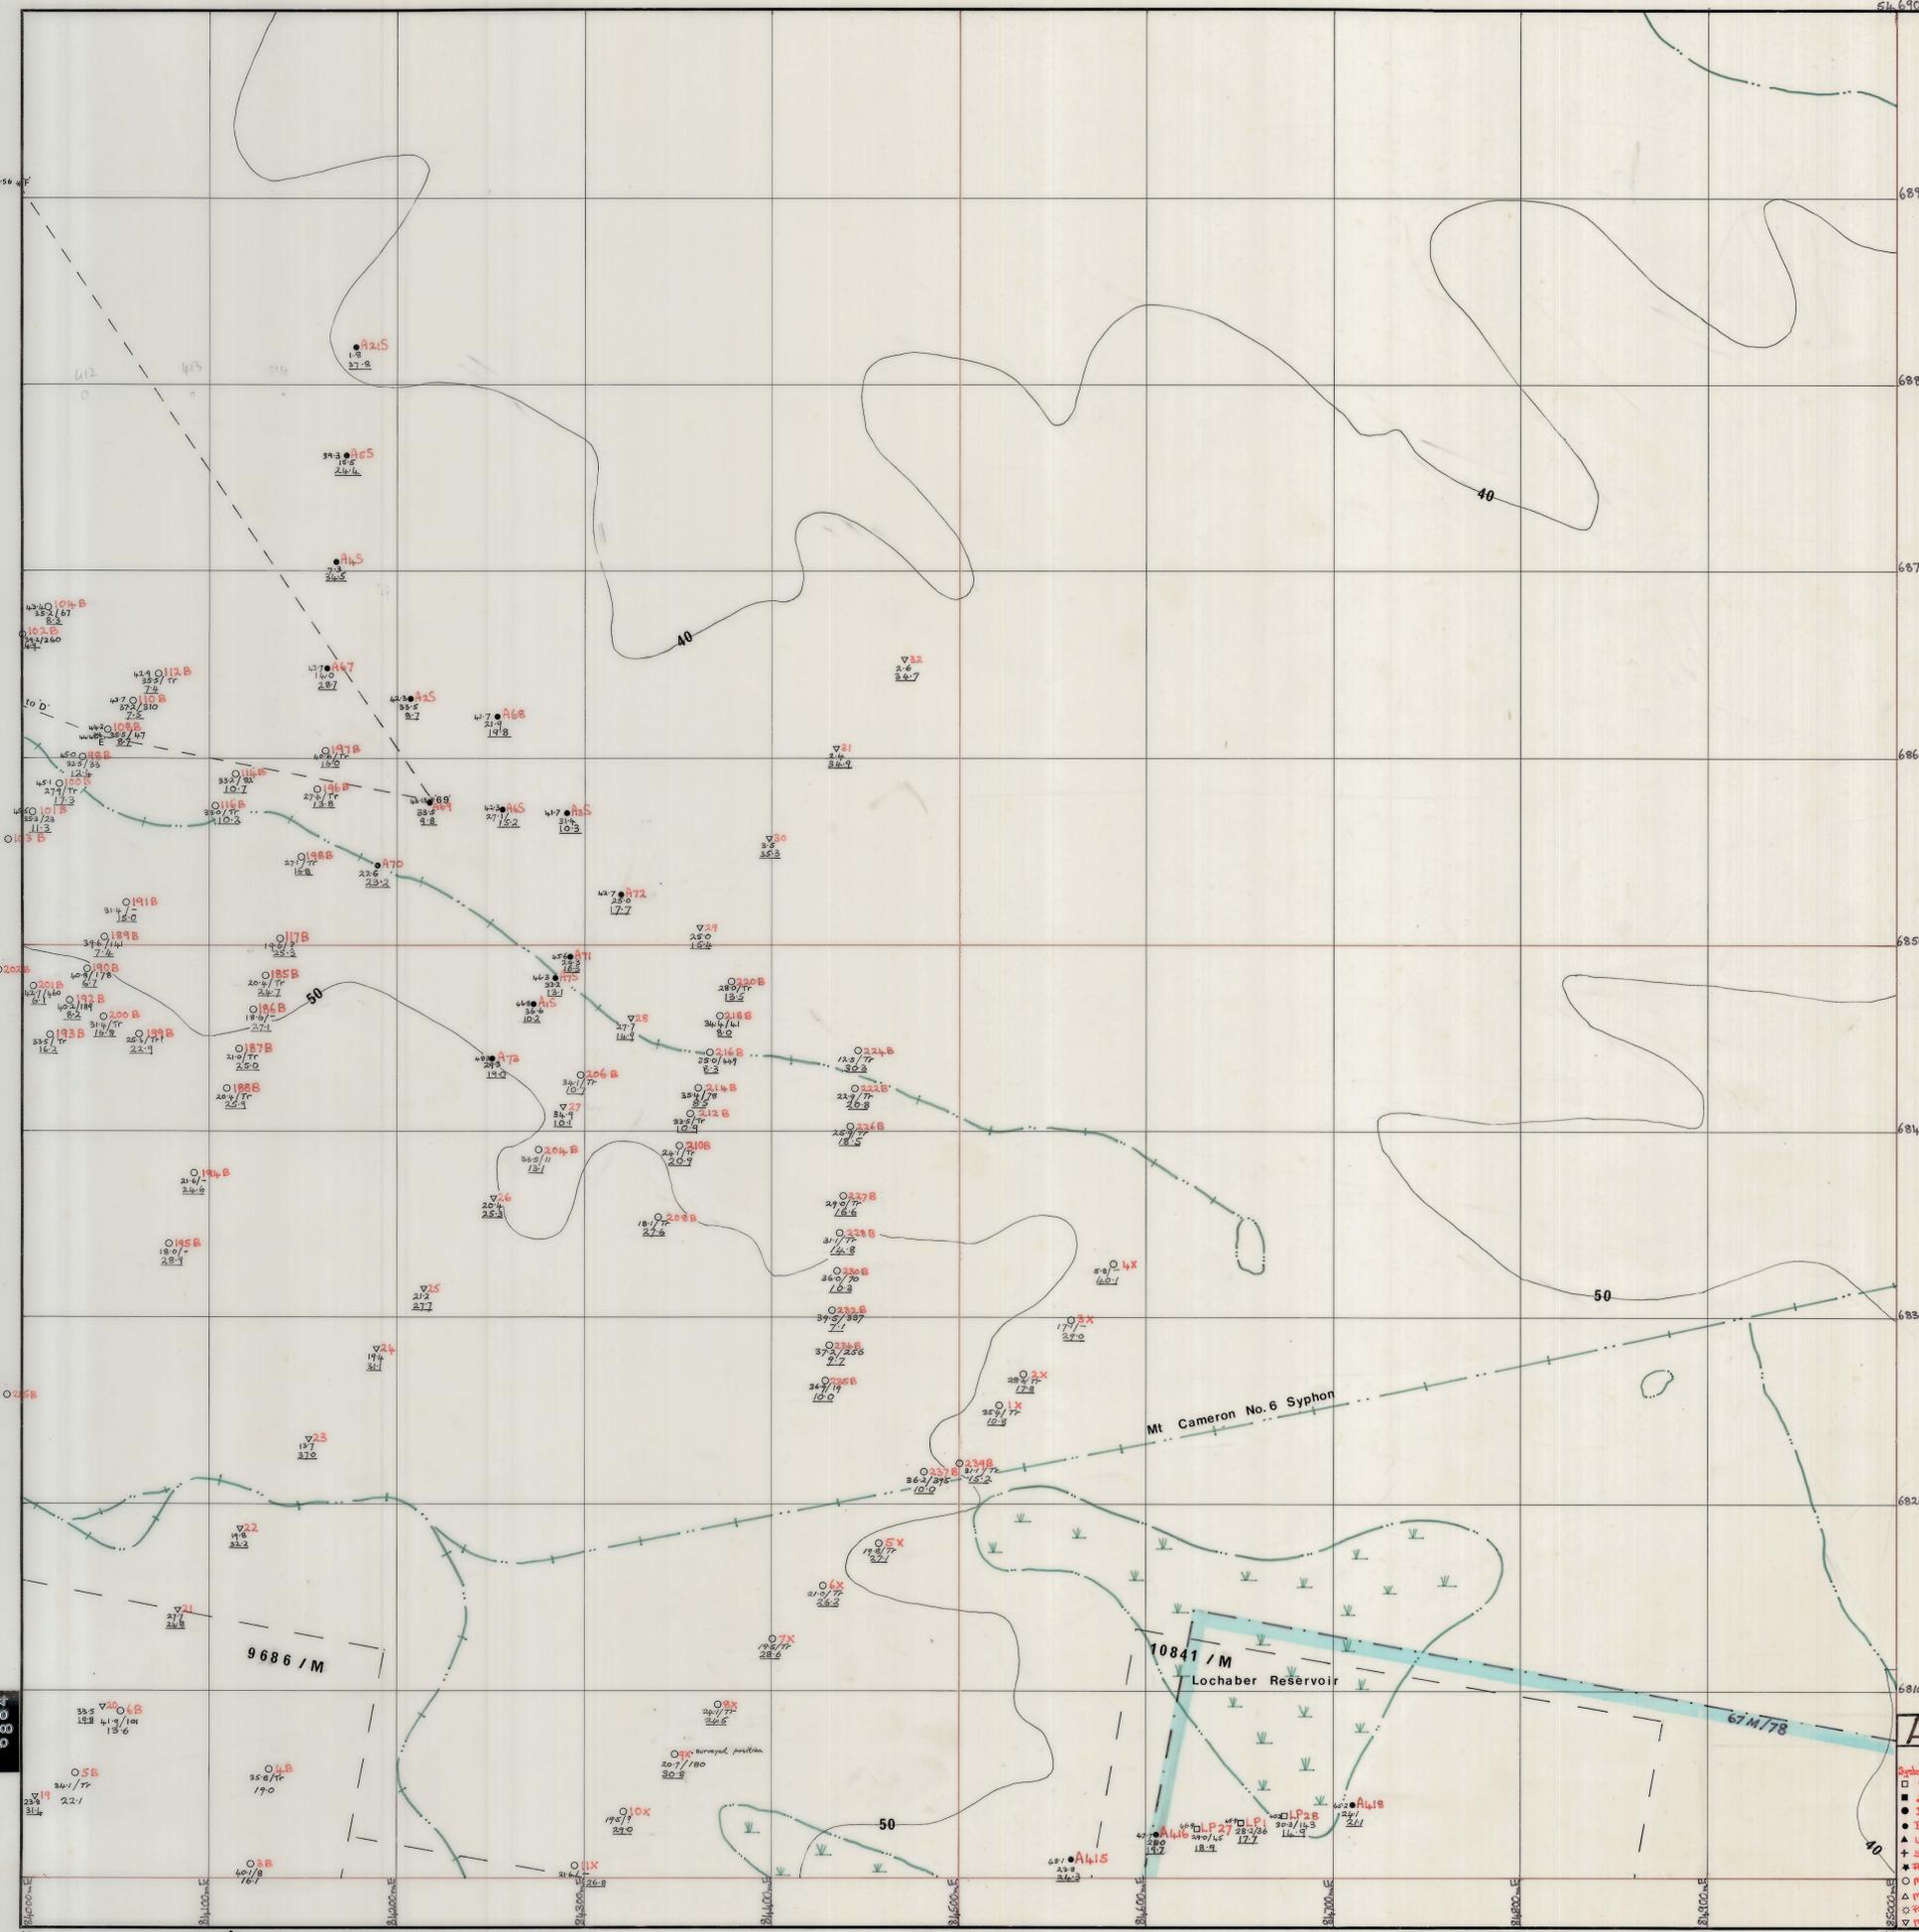


61 6900m N

### INDEX MAP

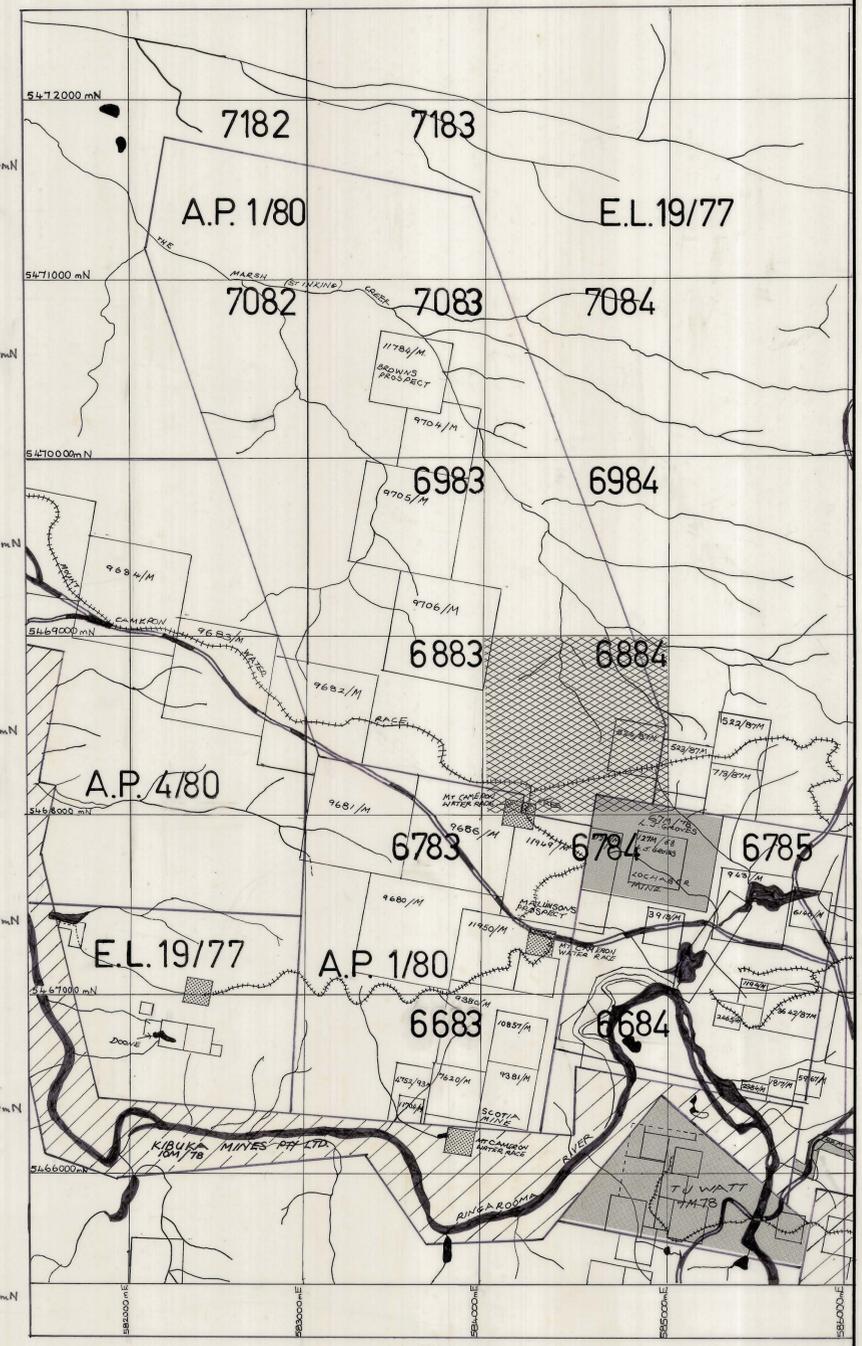

**AMDEX MINING LTD - SCOLOCH LEAD**

**SHEET - 6884**

LOCATION - N.E. TASMANIA  
SCALE - 1:1500  
DATE - July 1981  
DRAWN - R. MUNRO  
HEIGHT DATUM - A.H.D.  
GRID - A.M.G.

Symbol	Company	Date	Drilling Method
□	Amdex Mining Ltd.	1978 onwards	Perforation, sealed upper
■	L.I. Smees (Mines Department)	1971	Perforation
●	B. P.L.I. Mining Ltd.	1971-72, 1974	Perforation
▲	Wick Development Co.	1975-76	Rough - non sample
+	Stoney Creek Tin Mining Co. N.L.	1964-65	Perforation
★	River Tiers Rus. Exploration Pty. Ltd.	1958	Perforation
△	Mines Department - Roaches Domes	1935-44	Cable Gauge, Handplant
○	Pioneer Tin Mining Co. - Ruess Bore	1916	Handplant
▽	Mines Department - Sinking Bore	1902	Handplant

**DRILL HOLE LEGEND**

○ 104B - Surface R.H. - m (Column value assumed to be correct)  
○ 105B - Drill Hole Number  
○ 106B - grade - surface to basement - 3702m  
○ 107B - Basement R.H. - m  
○ 108B - Depth to basement - m

— Current Lease Boundaries  
- - - Old Lease Boundaries  
- \* - Scotia survey showing peg positions.

6884

428 - 009

SCOTIA

LOCHABER LEAD

428 - 009