


0432 - 005

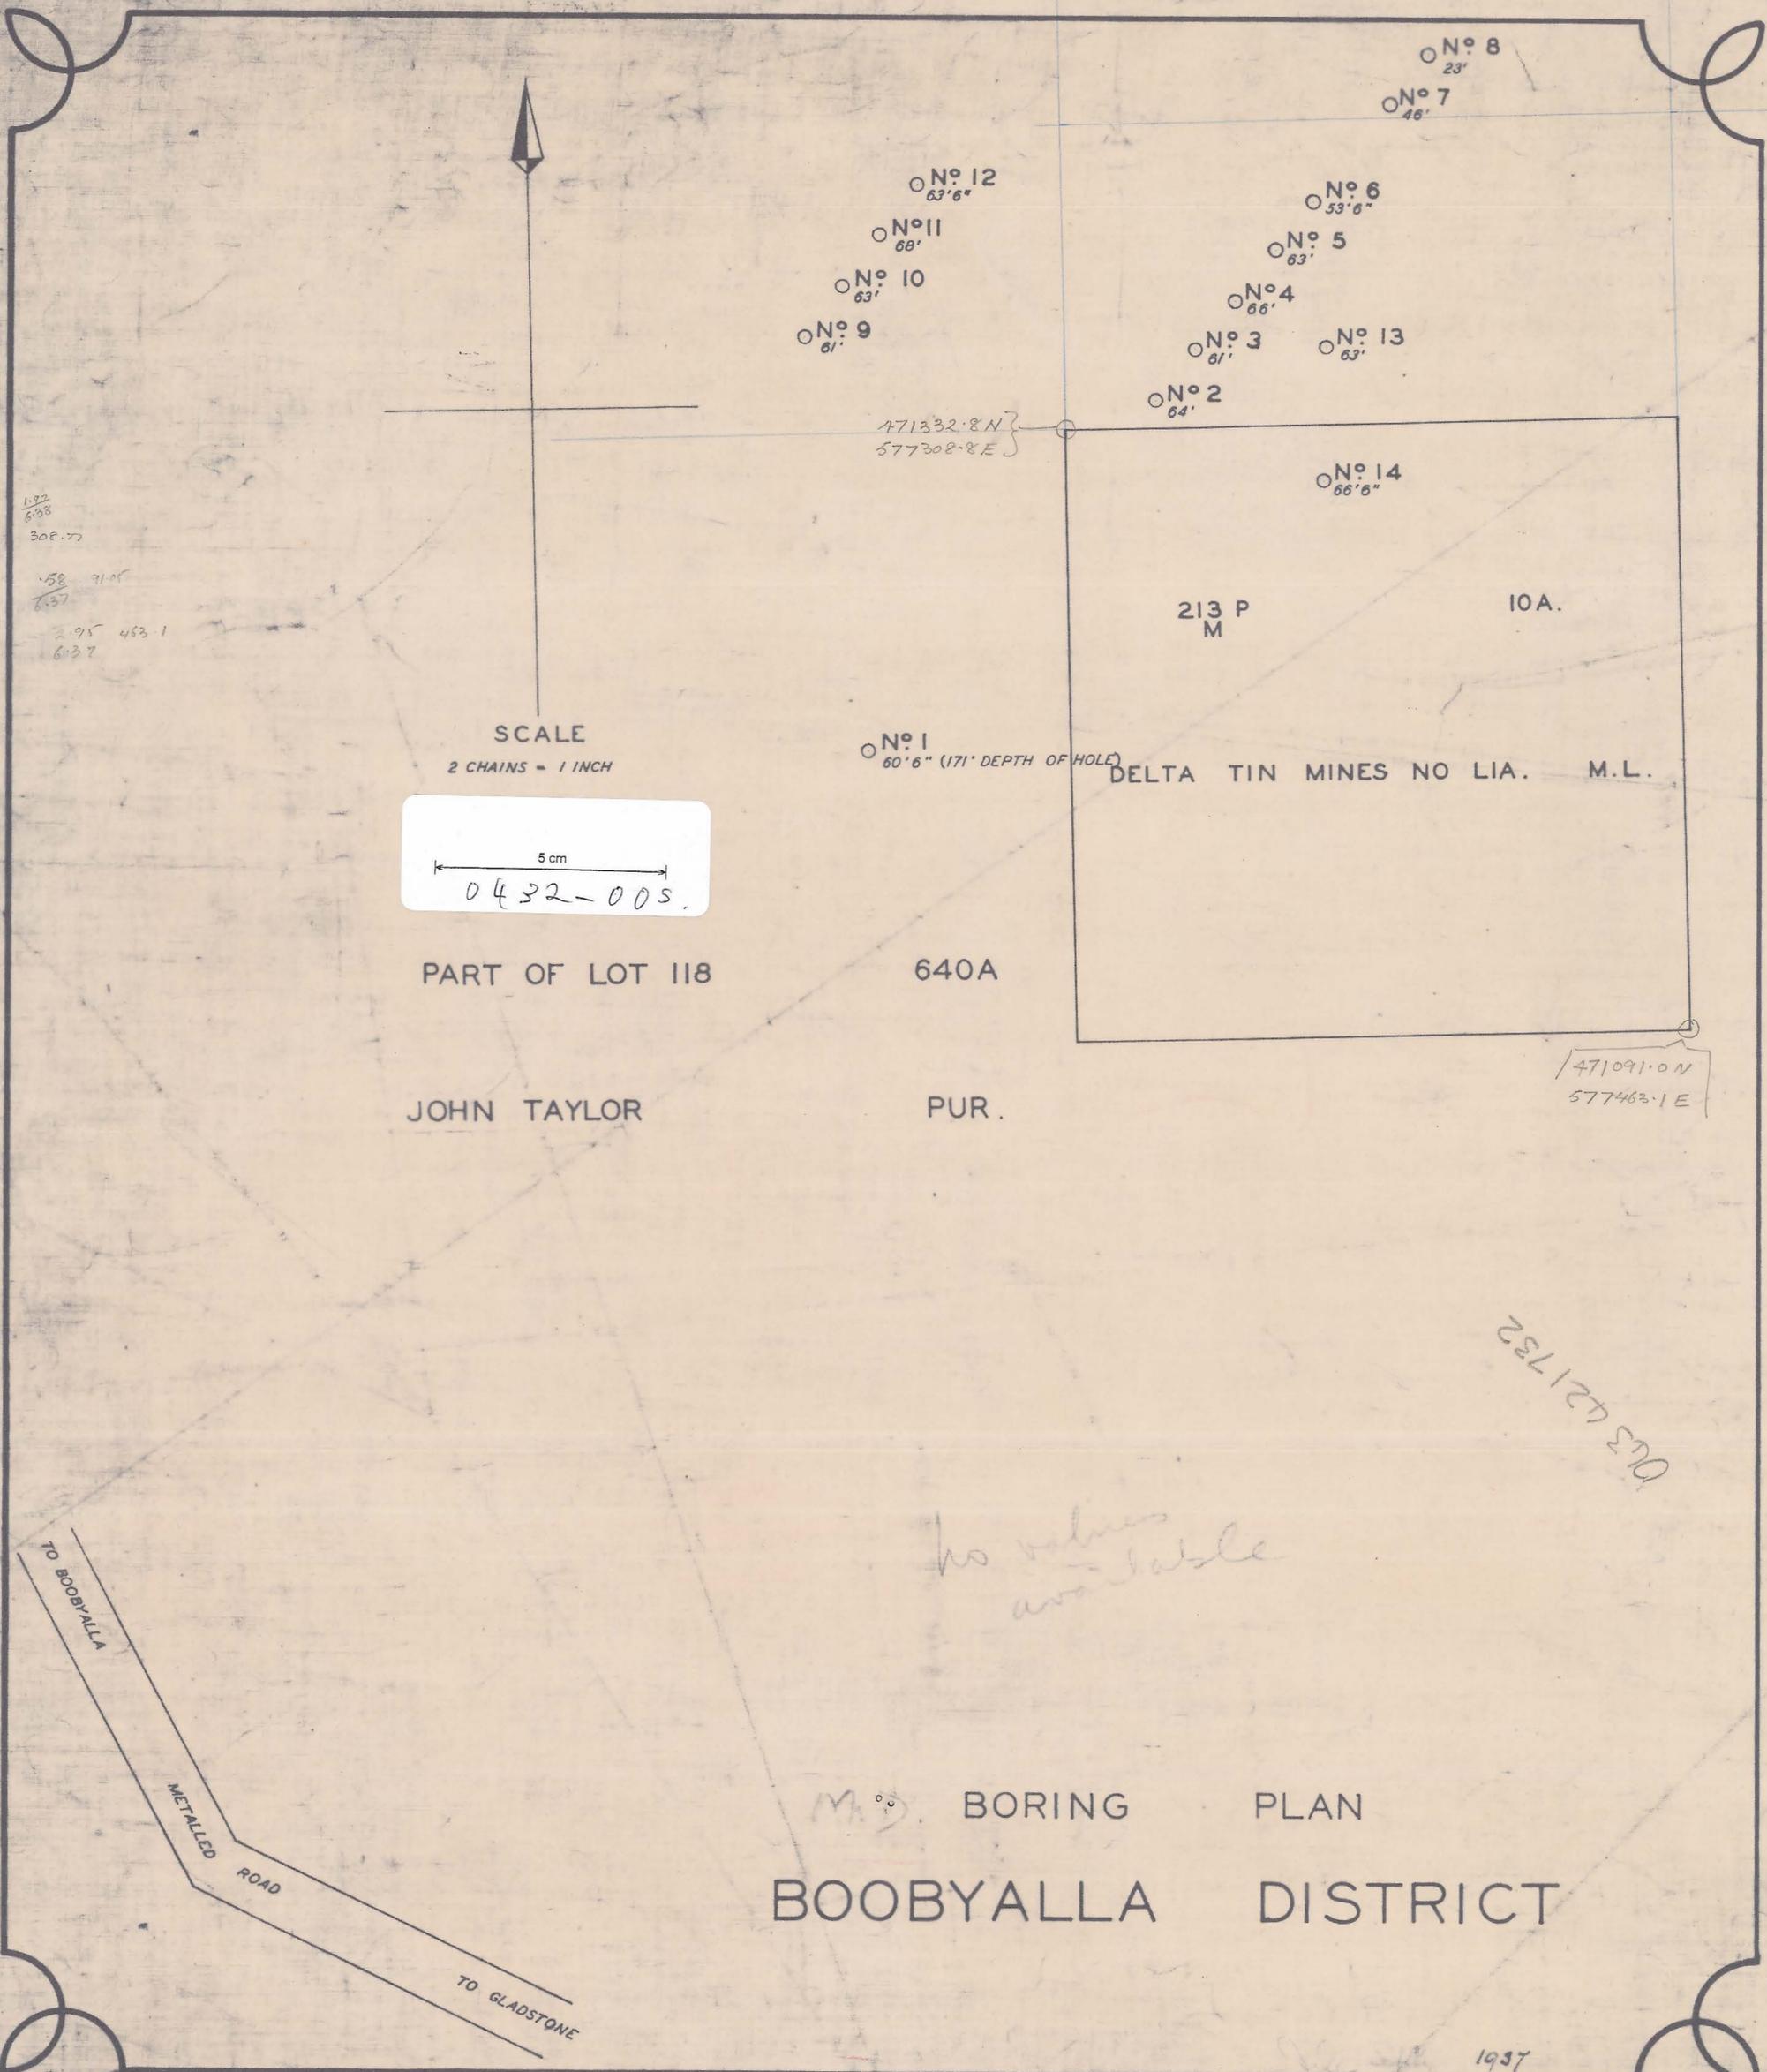

1.92
6.38
308.77

58 91.5
6.37

2.95 453.1
6.37

SCALE
2 CHAINS = 1 INCH

5 cm

0432-005

PART OF LOT 118

640A

JOHN TAYLOR


PUR.

DELTA TIN MINES NO LIA. M.L.

471091.0 N
577463.1 E

No values available

M.S. BORING PLAN
BOOBYALLA DISTRICT

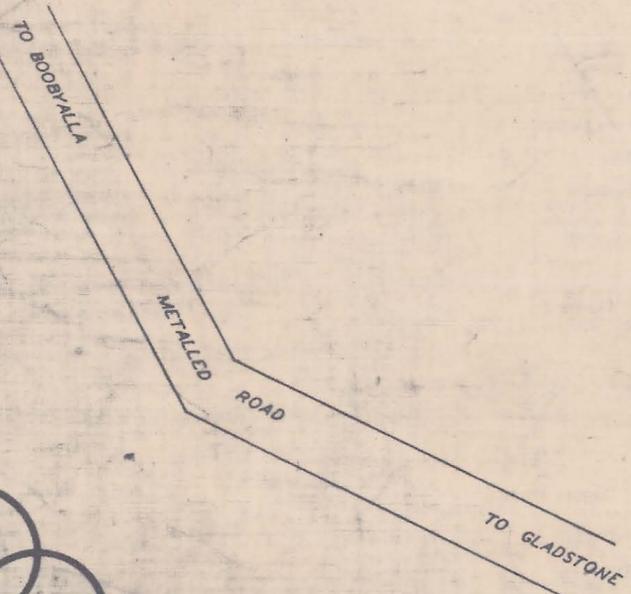

043 421 732

749

1937

9-749